

KELLER SPRINGS CLUBHOUSE

ADDISON, TEXAS

INTERIOR DESIGN DRAWINGS

EMBREY PARTNERS, LTD

SAN ANTONIO, TX

REVISED FOR CONSTRUCTION
MAY 16, 2012

KELLER SPRINGS CLUBHOUSE
ADDISON, TX


DRAWING LIST

DRAWING NUMBER	DRAWING TITLE
ID.0	DRAWING LIST, LEGEND & NOTES
ID.1	DETAIL LOCATION PLAN
ID.2	REFLECTED CEILING PLAN
ID.2A	ENLARGED PLAN & SECTION @ LOBBY LIGHT COVE
ID.2B	ENLARGED REFLECTED CEILING PLAN @ GREAT ROOM PANELING AND SOFFIT
ID.3	MISC. ELECTRICAL PLAN
ID.4.0	MISC. TRIMS, DETAILS & LOBBY LIGHT PANEL SECTIONS THRU LOBBY ELEMENTS & GAMES ROOM TRIM ASS'YS.
ID.4.1	MISC. DETAILS & SPECIFICATIONS
ID.4.2	INTERIOR DESIGNER'S PREFERRED FLAT SCREEN TV MODELS & MOUNTING BRACKETS
ID.4.3	EQUIPMENT SPECIFICATIONS, SHEET 1
ID.4.4	EQUIPMENT SPECIFICATIONS, SHEET 2
ID.4.5	RESTROOM ACCESSORIES SPECIFICATIONS
ID.5	GENERAL SECTIONS & ELEVATION @ GAMES
ID.6.0	ENLARGED KITCHEN PLAN
ID.6.1	ENLARGED KITCHEN ELEVATIONS, SECTION @ TV RECESS & CORNER DETAIL
ID.6.2	ENLARGED KITCHEN ELEVATION & SECTIONS
ID.6.3	KITCHEN ISLAND & FITNESS TOWEL CABINET ELEVATIONS & SECTION
ID.7.0	MISC. ENLARGED PLANS
ID.7.1	ENLARGED MISC. ELEVATIONS & SECTIONS
ID.7.2	ENLARGED ELEVATIONS & SECTIONS @ GREAT ROOM & GAMES CABINETS
ID.7.3	ENLARGED ELEVATIONS & SECTIONS @ GAMES
ID.FS.0	FINISH SPECIFICATIONS PLAN
ID.FS.1	FINISH SCHEDULE & MISC. SPECIFICATIONS
ID.FP	FURNITURE PLAN

DRAWING LIST, LEGEND & NOTES

ADDED FABRICATION DETAILS 5-16-12

© 2012 M. FORD & ASSOCIATES INC.
THIS DOCUMENT IS PUBLISHED AS AN INSTRUMENT OF SERVICE AND IS GIVEN IN CONFIDENCE. IT REMAINS THE PROPERTY OF M. FORD & ASSOCIATES, INC. THIS DOCUMENT, AND THE INFORMATION CONTAINED HEREIN, MAY NOT BE REPRODUCED OR DISCLOSED WITHOUT WRITTEN CONSENT OF M. FORD & ASSOCIATES, INC. HOUSTON, TEXAS

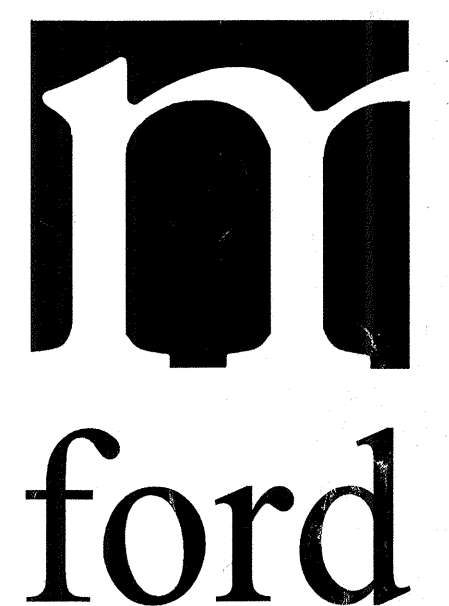

m. ford & associates
interior design
99 deterring street
suite 165
houston, tx 77007
phone 713-630-0800
fax 713-630-0814
mford@mfordassociates.com
www.mfordassociates.com

drawn by: Queen of the World

SHEET NO.

ID.0

The Texas Board of Architectural Examiners
333 Guadalupe, Suite 2-350 PO Box 12337
Austin, TX 78701-3942 Austin, TX 78711-2337

Telephone (512) 305-9000
has jurisdiction over individuals licensed under the Interior Designer's Registration Law Texas Civil Statutes, Article 249e

ANY DRAWINGS OR SPECIFICATIONS ARE FOR DESIGN INTENT ONLY. THESE ARE NOT INTENDED FOR ARCHITECTURAL/ENGINEERING PURPOSES.

ROOM TRIM & MOULDING COMBINATION LEGEND

TAG NO.	ROOM	GRADE	DESCRIPTION
1	LOBBY, LEASING	STAIN, & SPECIAL SURFACING	KELLER SPRINGS BASE THROUGHOUT (EXCEPT @ COLUMNS), KELLER SPRINGS CROWN ASSY. @ PERIMETER OF 10'-3" CEILING, VENEER PANELING @ COLUMNS & ACRYLIC BACKLIT PANEL. CUSTOM CABINETS PER INTERIOR DESIGNER'S FABRICATION DWGS. RECESSED LIGHT COVE W/WALLCOVERING 1 ON CEILING. SEE NOTE**
2	MANAGER, ASST. MGR.	PAINT	KELLER SPRINGS BASE. SEE NOTE**
3	WORKROOM, STORAGE	PAINT	MFG. CABINETS @ WORKROOM ONLY BY ARCHITECT. VINYL BASE TO MATCH FLOORING. SEE NOTE**
4	MEN, WOMEN	PAINT	TILE BASE. TILE WALLS TO APPROX. 50" A.F.F. WALLCOVERING ABOVE. BRUSHED STAINLESS IN-WALL AMENITY FIXTURES AS SPECIFIED BY INTERIOR DESIGNER. SEE NOTE**
5	KITCHEN, GREAT ROOM, INTERNET CAFE, DINING	STAIN	KELLER SPRINGS BASE THROUGHOUT, KELLER SPRINGS CROWN ASSY. @ PERIMETER OF 10'-8 1/2" CEILING, VENEER PANELING @ CEILING, DROPPED PAINTED GYP SOFFIT, CUSTOM CABINETS PER INTERIOR DESIGNER'S FABRICATION DWGS. BUILT-IN BANQUETTE PURCHASED BY INTERIOR DESIGNER. SEE NOTE**
6	GAMES	STAIN	KELLER SPRINGS BASE, CUSTOM CASED OPENINGS AT ENTRANCES, KELLER SPRINGS WALL TRIM @ TV, GAMING ACCESSORY OPENINGS AND ABOVE DRINK RAIL AT REAR WALL
7	FITNESS	PAINT	KELLER SPRINGS BASE THROUGHOUT, KELLER SPRINGS CROWN ASSY. @ PERIMETER OF 10'-8 1/2" CEILING, THREE MIRRORING WALLS, CUSTOM TOWEL CABINET PER INTERIOR DESIGNER'S FABRICATION DWGS. SEE NOTE**
8	CLUB/LEASING CORRIDOR	PAINT	KELLER SPRINGS BASE THROUGHOUT (EXCEPT @ COLUMNS), KELLER SPRINGS CROWN ASSY. @ PERIMETER OF 10'-8 1/2" CEILING OUTSIDE FITNESS. SEE NOTE**
9	MAIL	PAINT	KELLER SPRINGS BASE THROUGHOUT, INTERIOR DESIGNER TO SELECT MAIL BOX FINISHES FROM ARCHITECT'S SELECTED VENDOR OPTIONS. SEE NOTE**

WOOD SPECIES FOR CUSTOM CABINETS AND TRIMS SHOULD RESEMBLE FURNITURE-GRADE MATERIALS. MAPLE OR ALDER ARE OPTIONS, BUT BUILDER SHOULD ASK THE CABINETMAKER FOR SUGGESTIONS THAT WILL PROVIDE AN EVEN, FINE-GRAINED APPEARANCE. SMALLER TRIMS MAY REQUIRE HARDWOOD SELECTION.
**USE KELLER SPRINGS CASING @ DISCRETION OF BUILDER (DETAIL "3A" DWG. ID.4.0 ON ALL DOORS WITH WOOD FRAMES)

INTERIOR DESIGN SYMBOL LEGEND

SYMBOL	DESCRIPTION
X	SPECIALTY LIGHT FIXTURE (REFER TO INTERIOR DESIGNER'S KEYED NOTES, THIS DWG.)
XXX	COMPONENT TAG---SEE DWG. ID.FS.1
XX	KEYED NOTE (REFER TO THIS DWG.)
XX	ELEVATION VIEW & DRAWING WHERE IT CAN BE FOUND
XX	ROOM TRIM & MOULDING COMBINATION
*	DIMENSION TAKEN DIRECTLY FROM ARCHITECTURAL DRAWINGS REV. ISSUED 3, 2-14-12
---	KELLER SPRINGS CROWN ASSY. USED AT PERIMETER OF 10'-3" & 10'-8 1/2" CEILINGS
⊠	ADD'L. STUD FRAMING NOT SHOWN ON ARCHITECTURAL PLANS
▲	FINISHED DIMENSION---ALL OTHER DIMENSIONS ARE ROUGH DIMENSIONS U.N.
XX	FLOOR FINISH---REFER TO INTERIOR DESIGN SPECIFICATIONS ON DWG. ID.FS.1
XX	WALL FINISH---REFER TO INTERIOR DESIGN SPECIFICATIONS ON DWG. ID.FS.1
▬	DROPPED SOFFIT---BOTTOM OF FRAMING EL. 8'-0" A.F.F. UNLESS NOTED
XX	PRESENTATION NOTE TO CLIENT, STRUCTURAL ENGINEER, AND/OR MEP CONTRACTOR (NOT USED IN ISSUED FOR CONSTRUCTION DRAWINGS)
○	6" DIA. RECESSED CAN PER LIGHTING CONTRACTOR AND SPECIFIED ON INTERIOR DESIGN MEP KEYED NOTES 1, ITEM #7 (THIS SHEET)
○	4" DIA. RECESSED CAN PURCHASED BY LIGHTING CONTRACTOR AND SPECIFIED ON INTERIOR DESIGN MEP KEYED NOTES 1, ITEM #8 (THIS SHEET)
○	36" DIA. SURFACE-MOUNT FIXTURE PER INTERIOR DESIGNER (SEE INTERIOR DESIGN DESIGN MEP KEYED NOTES 1, ITEM #10 (THIS SHEET))

ELECTRICAL SYMBOL LEGEND

NOTE: ALL SYMBOLS MAY NOT APPEAR ON INTERIOR DESIGNER'S DRAWINGS. REFER TO ELECTRICAL ENGINEER'S PLANS FOR DETAILS, WIRING AND OTHER IMPORTANT INFORMATION REGARDING ELECTRICAL EQUIPMENT AND SYSTEMS. THIS LEGEND IS PROVIDED BY THE ELECTRICAL ENGINEER AS A COURTESY TO THE INTERIOR DESIGNER. PLEASE SEE THE ADJACENT INTERIOR DESIGNER'S KEYED MEP NOTES FOR FURTHER INFORMATION. SYMBOLS ARE NOT TO SCALE.

SYMBOL	DESCRIPTION	HEIGHT	SYMBOL	DESCRIPTION	HEIGHT
S	SINGLE POLE SINGLE THROW TOGGLE SWITCH (NOTE L-1)	48"	EXIT	EXIT SIGN, CEILING/WALL MOUNTED. PROVIDE ARROWS AS INDICATED ON DRAWINGS	
S ₃ /S ₄	THREE-WAY TOGGLE SWITCH/FOUR-WAY TOGGLE SWITCH (NOTE L-1)	48"	EMERGENCY	EMERGENCY LIGHTING FIXTURE	
S _M	MOTOR RATED SWITCH		PANELBOARD	PANELBOARD - WALL MOUNTED (RECESSED)	
S _K	KEYED SWITCH	48"	PANELBOARD	PANELBOARD - WALL MOUNTED (SURFACE)	
T	TIMER SWITCH	48"	MOTOR	MOTOR	
D	DIMMER SWITCH (NOTE L-1)	48"	DISCONNECT	NONFUSIBLE DISCONNECT SWITCH, RATING/POLES/NEMA ENCLOSURE	
D ₃	THREE-WAY DIMMER SWITCH (NOTE L-1)	48"	DISCONNECT	FUSIBLE DISCONNECT SWITCH, RATING/POLES/NEMA ENCLOSURE/FUSE RATING	
⊕/⊕	DUPLEX / QUAD RECEPTACLE OUTLET (NOTE L-1)	18"	STARTER	MAGNETIC MOTOR STARTER. NEMA SIZE RATING/ENCLOSURE (NEMA 1 IF NOT SHOWN)	
⊕/⊕	(*WP)=WEATHERPROOF, *GFI=GROUND FAULT INTERRUPTER		STARTER	COMBINATION MAGNETIC MOTOR STARTER AND DISCONNECT MEANS, NEMA SIZE RATING/ENCLOSURE (NEMA 1 IF NOT SHOWN)	
⊕/⊕	G.F.C.I. DUPLEX RECEPTACLE OUTLET WALL/ABOVE COUNTER MOUNTED (NOTE L-1)	18"/43"	CT	CURRENT TRANSFORMER CABINET	48"
⊕	ISOLATED GROUND DUPLEX RECEPTACLE OUTLET	18"	PM	POWER METER AND SOCKET	
⊕	SPECIAL PURPOSE RECEPTACLE OUTLET, NEMA CONFIGURATION TO MATCH PLUG. (NOTE L-1)	18"	FAS	FIRE ALARM MANUAL STATION	48"
⊕	SPLIT WIRED DUPLEX RECEPTACLE. ONE RECEPTACLE SHALL BE SWITCHED AS SHOWN ON PLANS (NOTE L-1)	18"	EM ₁₀	FIRE ALARM HORN/SPEAKER WITH VISUAL DEVICE (NOTE L-3), NUMERAL INDICATES CANDELA RATING	
⊕/⊕	DUPLEX RECEPTACLE OUTLET, CEILING MOUNTED/FLOOR MOUNTED		EM	FIRE ALARM HORN/SPEAKER (NOTE L-3)	
⊕/⊕	MULTI-OUTLET ASSEMBLY WITH OUTLETS ON CENTERS AS INDICATED IN NOTES OR SPECIFICATIONS MOUNT 6" ABOVE COUNTER OR AS INDICATED		EM ₁₀	FIRE ALARM VISUAL DEVICE (NOTE L-3), NUMERAL INDICATES CANDELA RATING	
⊕	FIRE-RATED POKE-THRU DEVICE		F	FIREMAN PHONE JACK	
⊕/⊕	JUNCTION BOX, CEILING/WALL/FLOOR MOUNTED		F	FIRE PHONE	
X-1,3,5	ARROWHEAD INDICATES HOMERUN. X-1,3,5 ADJACENT TO HOMERUN. ARROWHEADS INDICATES HOMERUN TO PANEL X CIRCUIT NUMBERS 1,3, AND 5.		⊕	SMOKE DETECTOR (CEILING/WALL MOUNTED 4" MIN. AND 12" MAX. FROM CEILING)	
3,5	INDICATES CIRCUIT-CONTINUATION OF CIRCUITS 3 AND 5 OF PANEL X.		⊕	THERMAL DETECTOR, CEILING MOUNTED	
⊕	MARKS ACROSS RACEWAY SYMBOLS INDICATE THE NUMBER OF #12 CONDUCTORS (2 PHASE, 1 NEUTRAL) UNLESS OTHERWISE NOTED. NO MARKS INDICATES TWO #12 CONDUCTORS. EQUIPMENT GROUNDING CONDUCTORS ARE NOT INDICATED BY MARKS.		⊕	CONNECTION TO FIRE PROTECTION SYSTEM FLOW SWITCH	
⊕	RACEWAY/CABLE CONCEALED IN WALL AND/OR ABOVE CEILING		⊕	CONNECTION TO FIRE PROTECTION SYSTEM TAMPER SWITCH	
⊕	RACEWAY CONCEALED BELOW GRADE OR IN-SLAB		⊕	FIRE ALARM CONNECTION TO SMOKE/FIRE DOOR HOLD-OPEN DEVICE	
⊕	RACEWAY/CABLE CONCEALED IN WALL AND/OR ABOVE CEILING - EMERGENCY CIRCUIT		⊕	DUCT MOUNTED SMOKE DETECTOR	
⊕	RACEWAY INSTALLED EXPOSED		⊕	REMOTE STATION FOR DUCT MOUNTED SMOKE DETECTOR	
⊕	GROUNDING CONNECTION (SYSTEM AND/OR EQUIPMENT)		⊕	FIRE ALARM CONTROL PANEL, SURFACE/RECESSED	
⊕	CONDUIT TURNING UP/DOWN		⊕	FIRE ALARM ANNUNCIATOR PANEL, RECESSED	
⊕	CONDUIT STUB. TERMINATE IN INSULATED BUSHING OR CAP IF UNDERGROUND		⊕	TELEPHONE OUTLET, WALL MOUNTED/ABOVE COUNTER (NOTES L-1, L-2)/FLOOR MOUNTED	18"/43"
⊕	FLUORESCENT LIGHTING FIXTURE, 2X4, 1X4, 2X2		⊕	COMBINATION TELEPHONE/DATA OUTLET, WALL MOUNTED/ABOVE COUNTER (NOTE L-1, L-2)/FLOOR	18"/43"
⊕	FLUORESCENT LIGHTING FIXTURE, 2X4, 1X4, 2X2 - PROVIDING EMERGENCY ILLUMINATION		⊕	DATA OUTLET, WALL MOUNTED/ABOVE COUNTER (NOTE L-1, L-2)/FLOOR MOUNTED	18"/43"
⊕	LIGHTING FIXTURE - OVERHEAD/WALL MOUNTED		⊕	TELEVISION OUTLET WALL MOUNTED (NOTE L-1)/CEILING MOUNTED/FLOOR MOUNTED	18"
⊕	EMERGENCY LIGHTING FIXTURE - OVERHEAD/WALL MOUNTED		LEGEND NOTES		
⊕	FLUORESCENT STRIP FIXTURE - OVERHEAD/WALLMOUNTED		L-1	MOUNTING HEIGHTS NOTED ARE TO THE CENTER OF DEVICE ABOVE FINISHED FLOOR, UNLESS NOTED OTHERWISE.	
⊕	DIRECTIONAL OR WALL WASH LIGHTING FIXTURE		L-2	STUB 3/4" CONDUIT 6" ABOVE ACCESSIBLE CEILING AND TERMINATE WITH NYLON GROMMET.	
⊕	LIGHT TRACK AND LIGHT TRACK FIXTURES		L-3	FIRE ALARM VISUAL DEVICES SHALL BE WALL-MOUNTED 80" AFF OR 6" BELOW CEILING, WHICHEVER IS LOWER. AUDIBLE ONLY DEVICES SHALL BE WALL-MOUNTED AT NOT LESS THAN 90" AFF AND NOT LESS THAN 6" BELOW CEILING.	
⊕	POLE MOUNTED LIGHT FIXTURE WITH ARM. SEE PLANS FOR NUMBER OF LUMINAIRES.				
⊕	POST TOP OR BOLLARD LIGHT FIXTURE				
⊕	CEILING/PENDANT MOUNTED PADDLE FAN				

INTERIOR DESIGN MEP KEYED NOTES

NOTE	DESCRIPTION
1	INTERIOR DESIGNER'S DRAWINGS LOCATE THE FOLLOWING SPECIALTY LIGHTING FIXTURES. FIXTURES ARE ORDERED BY INTERIOR DESIGNER & PURCHASED BY OWNER UNLESS NOTED. FURTHER INFORMATION ON THESE FIXTURES CAN BE FOUND UNDER "LIGHTING SPECIFICATIONS" ON DWG. ID.FS.1: (1) LOBBY CHANDELIER, "MANIFESTO" BY LUSIVE DECOR (REFER TO DWG. ID.FS.1) ON DIMMER. (2) (4~ 8'L.G. 2~ 3'L.G. & 2~ 48" L.G. ALL NOMINAL LENGTHS) LOBBY COVE STRIP LIGHTS---CORELIGHT SERIES, CS COVE SOLO S-175-1C-120, NO DIMMING---COOPER LIGHTING W/175BULB EACH (3) BILLIARDS FIXTURE---CUSTOM "RAY 5" BY FLOSS USA (SEE DWG. ID.FS.1) ON DIMMERS. (4) (6) CORRIDOR SURFACE MOUNT "UNA" FIXTURE BY OCL (SEE DWG. ID.FS.1) (4) 52" DIA. FITNESS CEILING FANS WITH NO LIGHT KITS (SEE DWG. ID.FS.1) (16) 4" DIA. RECESSED CAN (50W) INCANDESCENT LOW-VOLTAGE DOWNLIGHT WITH PINHOLE APERTURE TRIM. SELECTED BY LIGHTING CONTRACTOR---PAINTED TO MATCH CEILING. (23) 6" DIA. RECESSED CAN (50W) FLUORESCENT SELECTED BY LIGHTING CONTRACTOR. PAINTED TO MATCH CEILING. (NO DIMMING). SEE LIGHTING PLAN FOR EMERGENCY KIT LOCATIONS. (20) 4" DIA. RECESSED CAN (50W) INCANDESCENT LOW-VOLTAGE DOWNLIGHT (WALL-WASHER) WITH ADJUSTABLE SLOT APERTURE TRIM. SELECTED BY LIGHTING CONTRACTOR---PAINTED TO MATCH CEILING. (3) BUSINESS CENTER PENDANT FIXTURES, CUSTOM "ROCK CANDY" BY STONE LIGHTING (SEE DWG. ID.FS.1) ON DIMMERS. (1) 36" DIA. CORRIDOR CUSTOM SURFACE-MOUNT DRUM FIXTURE BY STONEGATE DESIGNS (SEE DWG. ID.FS.1) (4) UP/DOWN LINEAR WALL MOUNTED WALL WASHERS BY OCL (SEE DWG. ID.FS.1) ON DIMMERS. (6) LED FIXTURES BY 3FORM. REFER TO ITEM #3 IN ID.DOC FOR SPECIFICATIONS.
2	LIGHT FIXTURES THAT ARE DIMENSIONALLY LOCATED ARE CRITICAL TO FURNISHINGS PLACEMENT AND ANY CHANGES TO THESE LOCATIONS SHOULD BE COORDINATED WITH THE INTERIOR DESIGNER.
3	INTERIOR DESIGNER ASSUMES NO RESPONSIBILITY FOR LIGHTING DESIGN. ANY MODEL NUMBERS FOR FIXTURES CALLED OUT ON REFLECTED CEILING PLANS ARE SUGGESTIONS ONLY, AND SHOULD BE EVALUATED BY A LIGHTING PROFESSIONAL FOR APPROPRIATENESS.
4	ALL LIGHT FIXTURES ARE SPECIFIED BY OTHERS, EXCEPT THOSE NOTED AS BY INTERIOR DESIGNER IN LEGEND ABOVE.
5	CAREFULLY AVOID PLACING SAFETY LIGHTING, STROBES, OR HORNS IN AREAS ON ELEVATIONS DESIGNATED AS "SPACE FOR ART".
6	NOT USED
7	SWITCHPLATE SAMPLES ARE TO BE PROVIDED TO INTERIOR DESIGNER FOR COLOR SELECTIONS.
8	LOCATE SWITCHES AND/OR EMERGENCY LIGHTS OR ALARMS AS CLOSE TO CORNER AND/OR DOOR AS POSSIBLE.
9	6"DIA. FLUORESCENT DOWNLIGHTS (BY LIGHTING CONTRACTOR) TO BE ON SEPARATE SWITCH NORMALLY OFF (USED FOR ROOM/EQUIPMENT MAINTENANCE SERVICES ONLY)
9A	6"DIA. FLUORESCENT DOWNLIGHTS (BY LIGHTING CONTRACTOR)
ELECTRICAL	
10	ELECTRICAL SYMBOLS IN ADDITION TO, RELOCATED FROM, OR IN LIEU OF, LOCATIONS SHOWN ON ELECTRICAL PLANS, REV. 6 EMAILED TO INTERIOR DESIGNER ON 4-3-2012. IN THE EVENT OF DISCREPANCY BETWEEN THIS DWG. & MEP CONSTRUCTION DWGS, BUILDER IS TO CONTACT INTERIOR DESIGNER.
11	RECEPTACLES THAT ARE DIMENSIONALLY LOCATED ARE CRITICAL TO FURNISHINGS PLACEMENT. ANY CHANGES TO THESE LOCATIONS SHOULD BE COORDINATED WITH INTERIOR DESIGNER.
12	HEIGHT OF RECEPTACLES TO BE PER LOCAL BUILDING CODES AND T.A.S. ACCESSIBILITY REQUIREMENTS UNLESS AS INDICATED IN NOTE 10 ABOVE.
13	RECEPTACLE PLATE SAMPLES TO BE PROVIDED TO INTERIOR DESIGNER FOR SELECTION.
14	ALL FLOOR RECEPTACLES ARE TO BE BRUSHED STAINLESS FINISH.
FRAMING	
15	FRAMERS ARE TO CAREFULLY CENTER STUDS AS SHOWN ON DWG. ID.1 AT FIVE RECESSED TV LOCATIONS TO FACILITATE INSTALLATION OF TRIM CABINETS.
PLUMBING	
16	MEP IS TO ENSURE THAT PLUMBING STUB UPS ARE COORDINATED WITH LATEST RESTROOM, COFFEE BAR AND KITCHEN PLANS. UPDATED PLUMBING CAD FILES HAD NOT BE ISSUED TO INTERIOR DESIGNER AS OF 4-23-12.
HVAC	
17	REFLECTED CEILING PLAN SHOWS HVAC REGISTER LOCATIONS FROM HVAC PLAN REV. 8 3-27-12.

INTERIOR DESIGN MISC. NOTES

1.	DUE TO THE VARIATIONS OF PRINTER SETTINGS FOR PDFs, THESE PLANS AS PRINTED MAY NOT BE TO SCALE. USE DIMENSIONS WHERE NOTED. IF SCALING IS NECESSARY, WE RECOMMEND YOU USE A DIMENSION ON THE PLAN AS THE BASIS TO CALCULATE THE DIFFERENCE BETWEEN IT AND WHAT YOUR SCALING TOOL READS.
2.	CARE HAS BEEN TAKEN TO COMPLY WITH FEDERAL 2010 ACCESSIBILITY STANDARDS DURING DESIGN PHASE. HOWEVER, OWNER IS RESPONSIBLE FOR ENSURING APPROPRIATE T.A.S. COMPLIANCE @ TIME OF INSPECTION. MARCH 15, 2012 IS THE COMPLIANCE DATE FOR USING THE 2010 REVISED REQUIREMENTS FOR NEW CONSTRUCTION, ALTERATIONS, PROGRAM ACCESSIBILITY, AND BARRIER REMOVAL. ALTHOUGH UNDER CERTAIN CIRCUMSTANCES, THE REVISED REGULATIONS PERMIT THE USE OF THE 2010 STANDARDS BEFORE THE COMPLIANCE DATE OF MARCH 15, 2012. ENTITIES ARE NOT REQUIRED TO COMPLY WITH THE 2010 STANDARDS UNTIL MARCH 15, 2012.
3.	FLAT SCREEN TVs ILLUSTRATED IN THESE PLANS WERE BASED ON MODELS SHOWN ON DWG. ID.4.3. TWO BASIC SIZES WERE DETERMINED OPTIMUM SIZES FOR OVERALL DESIGN COHESION. TVs SMALLER OR LARGER OR BY A DIFFERENT MANUFACTURER MAY NOT BALANCE WITH THE SURROUNDING INTERIOR DESIGN, AND USE OF LARGER MODELS MAY REQUIRE A DIFFERENT TV MOUNTING BRACKET.