


Kellen Springs
EMERY PARTNERS
CLUBHOUSE FITNESS ROOM
ADDISON, TEXAS

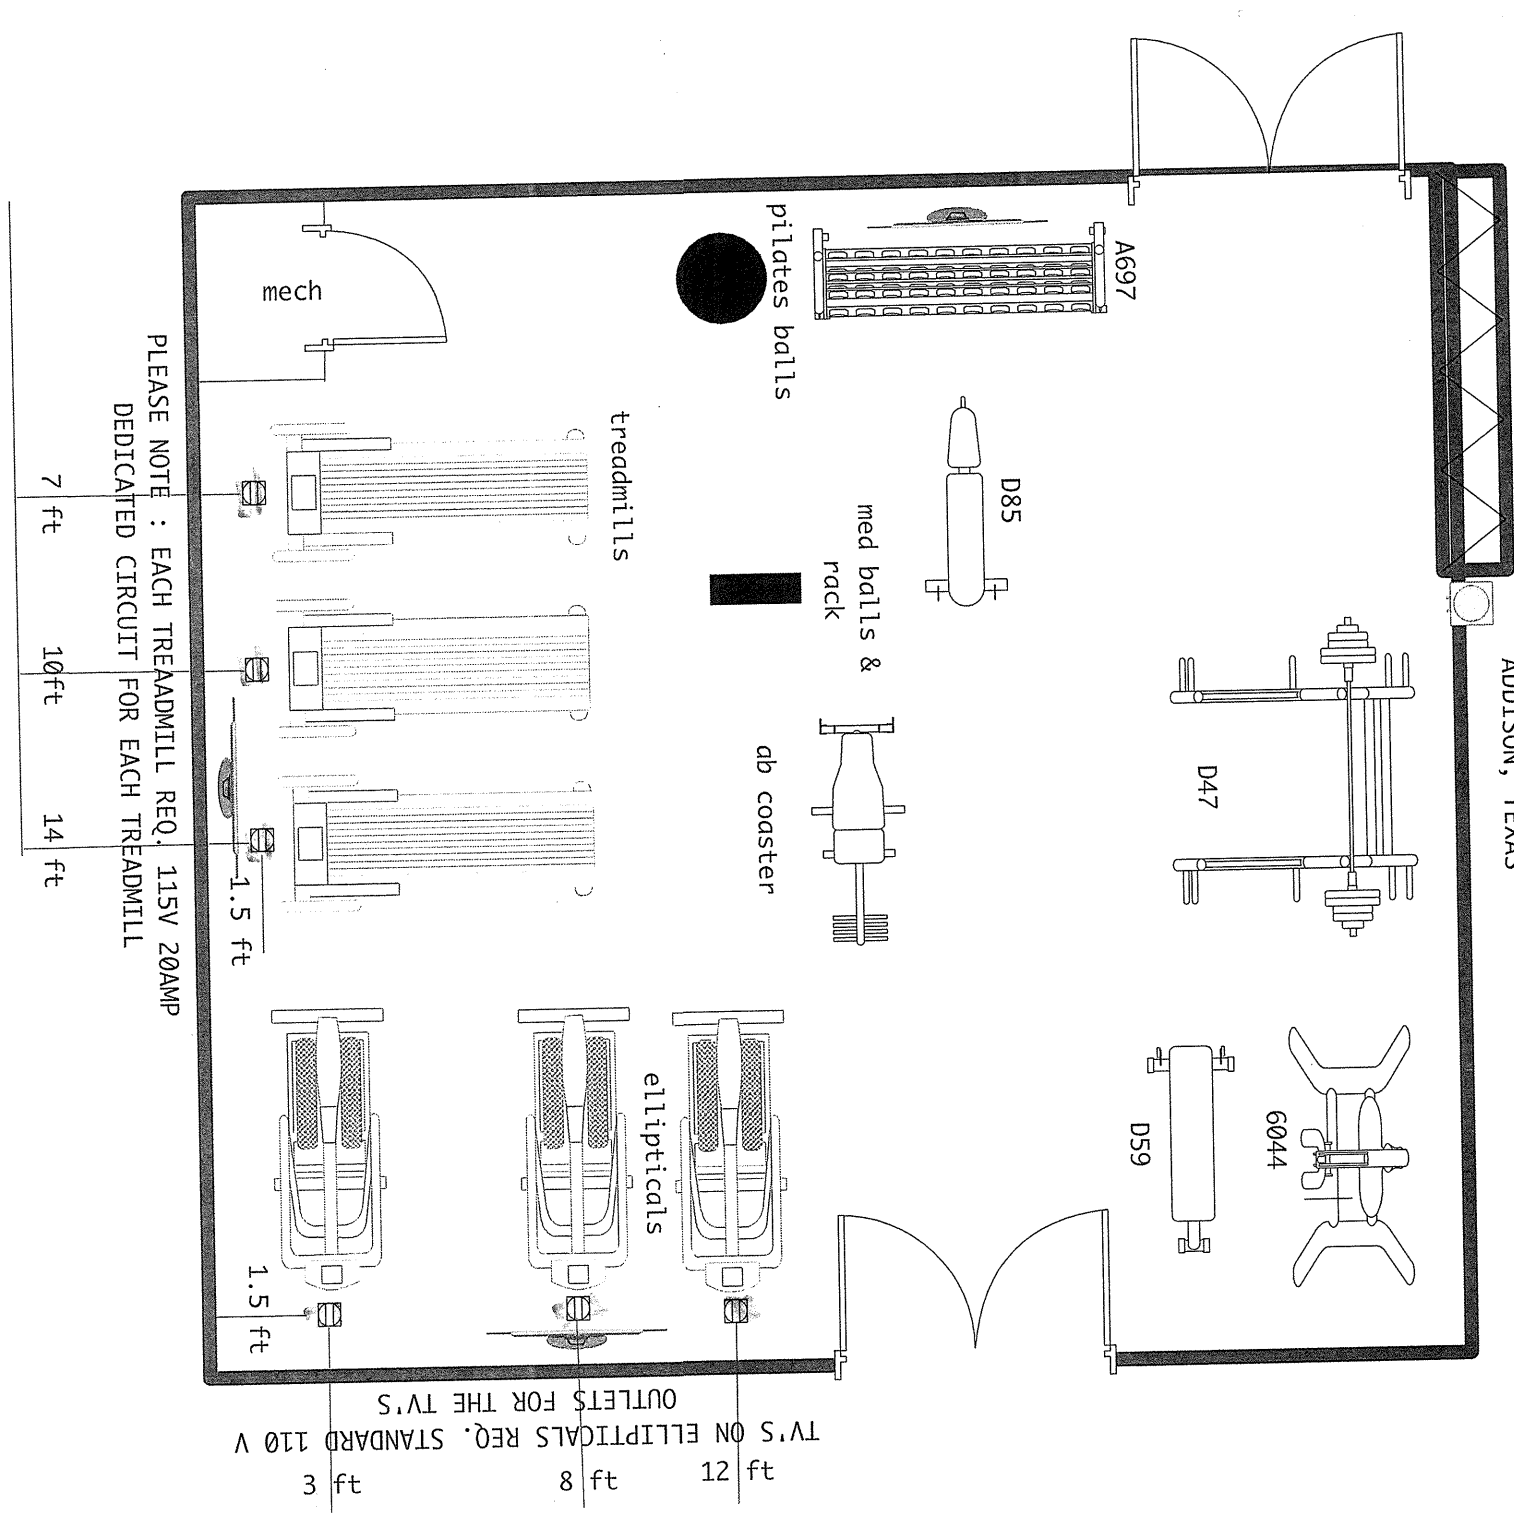

Electrical Floor Outlets