


6C SECTION THRU LOBBY LIGHT PANEL
1 1/2" = 1'-0"

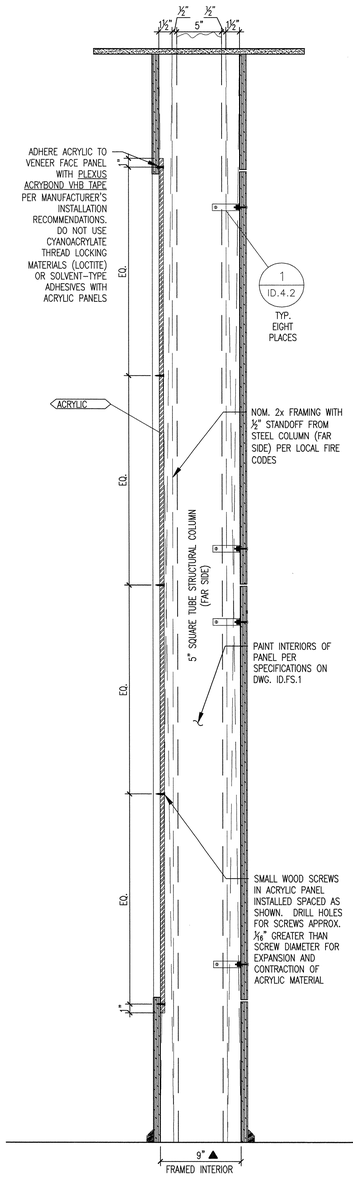


9A PLAN @ LEASING COLUMN ENCLOSURES
1 1/2" = 1'-0"




10A PLAN @ CORRIDOR COLUMN ENCLOSURES
1 1/2" = 1'-0"

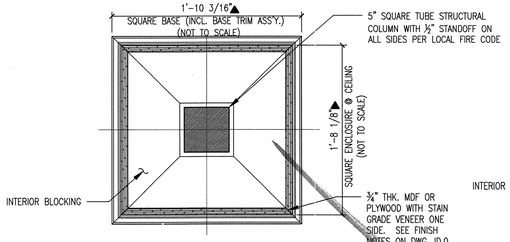


11 GAMES TRIM ASS'Y.--QUAD JOINT
FULL SIZE

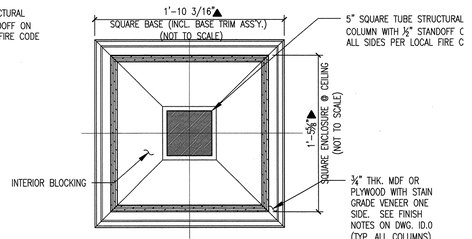


9 SECTION THRU LEASING COLUMN ENCLOSURE
1 1/2" = 1'-0"

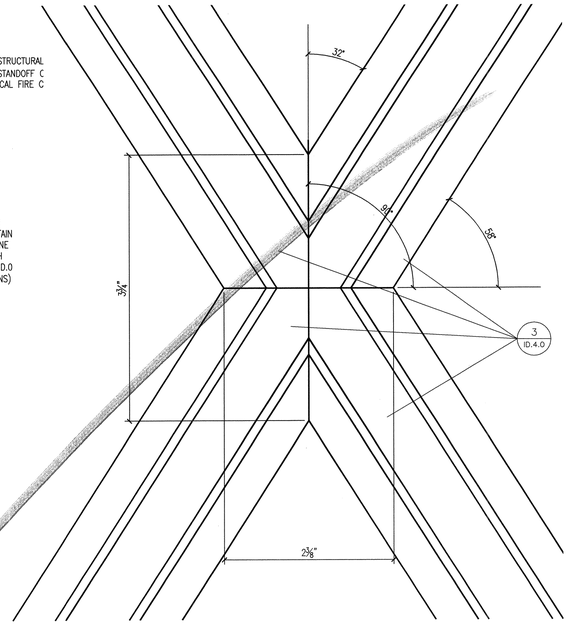


10 SECTION THRU CORRIDOR COLUMN ENCLOSURE
1 1/2" = 1'-0"

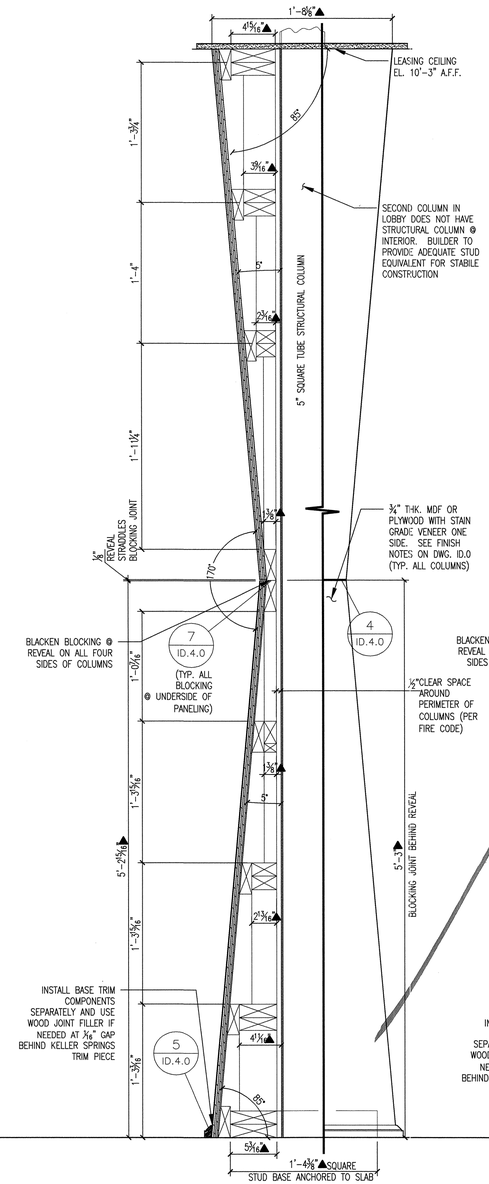


12 GAMES TRIM ASS'Y.-TRIPLE JOINT
FULL SIZE

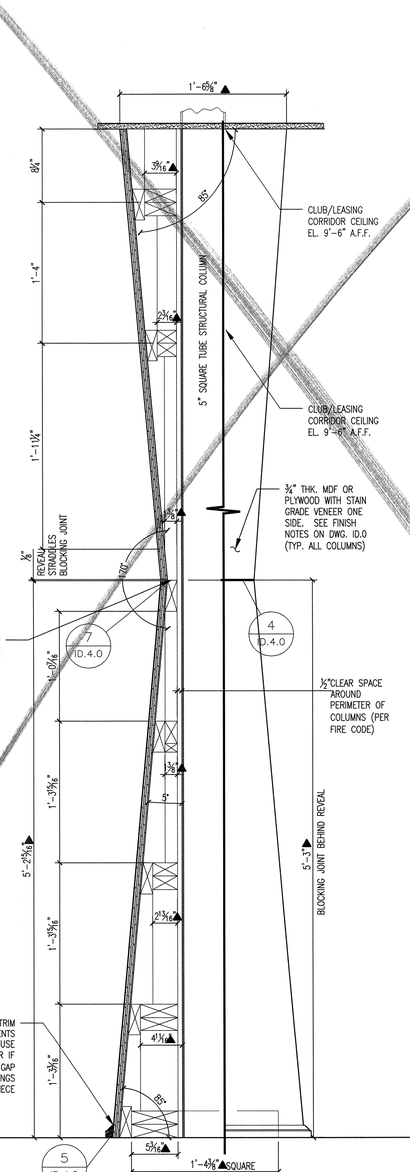


13 GAMES TRIM ASS'Y.--DOUBLE JOINT
FULL SIZE

# SECTIONS THRU LOBBY ELEMENTS & GAMES ROOM TRIM ASS'YS.

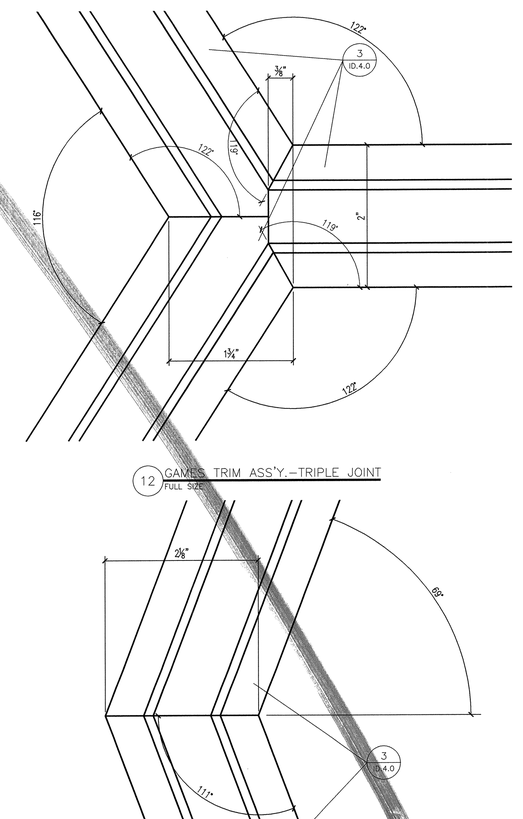ISSUED FOR CONSTRUCTION
APRIL 23, 2012

EMBREY PARTNERS, LTD

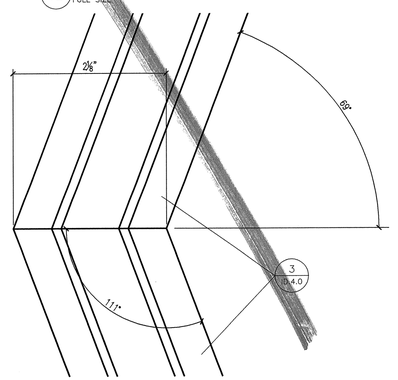SAN ANTONIO, TX

KELLER SPRINGS CLUBHOUSE

ADDISON, TX

© 2012 M. FORD & ASSOCIATES INC.
THIS DOCUMENT IS PUBLISHED AS AN INSTRUMENT OF SERVICE AND IS GIVEN IN CONFIDENCE. IT REMAINS THE PROPERTY OF M. FORD & ASSOCIATES, INC. THIS DOCUMENT, AND THE INFORMATION CONTAINED WITHIN MAY NOT BE DUPLICATED OR DISCLOSED WITHOUT WRITTEN CONSENT OF M. FORD & ASSOCIATES, INC. HOUSTON, TEXAS

ford

m. ford & associates
interior design
99 detering street
suite 165
houston, tx 77007
phone 713-630-0800
fax 713-630-0814
mford@mfordassociates.com
www.mfordassociates.com

drawn by:

SHEET NO.

ID.4.1