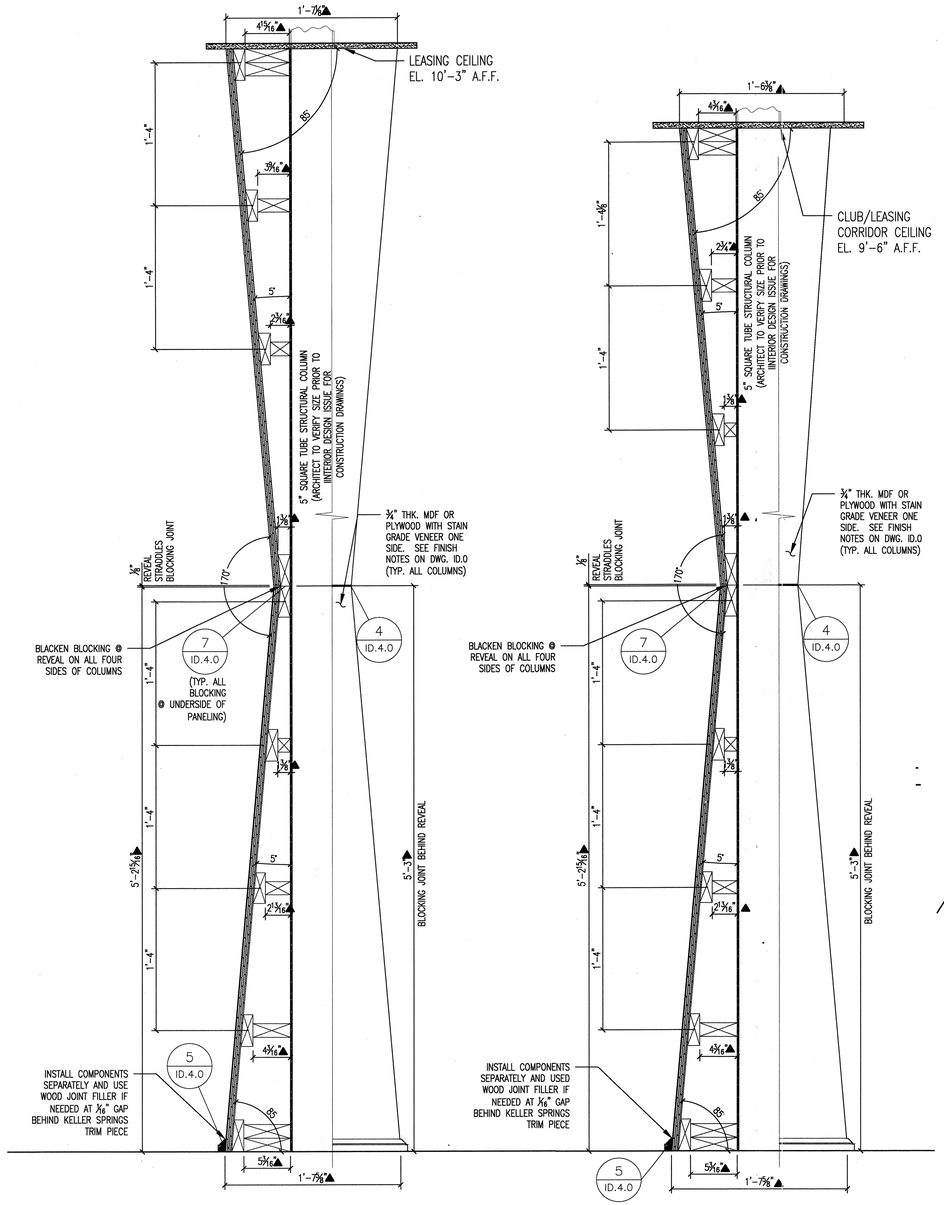

9 SECTION THRU LEASING COLUMN ENCLOSURE
1 1/2" = 1'-0"

10 SECTION THRU CORRIDOR COLUMN ENCLOSURE
1 1/2" = 1'-0"

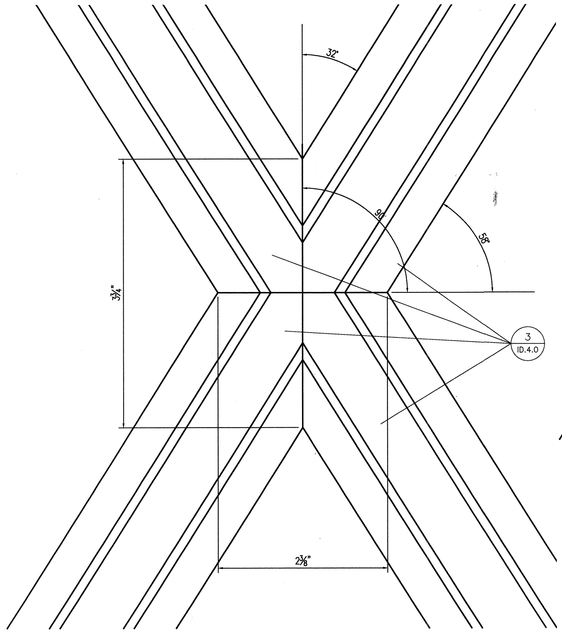

11 GAMES TRIM ASS'Y. QUAD--JOINT
FULL SIZE

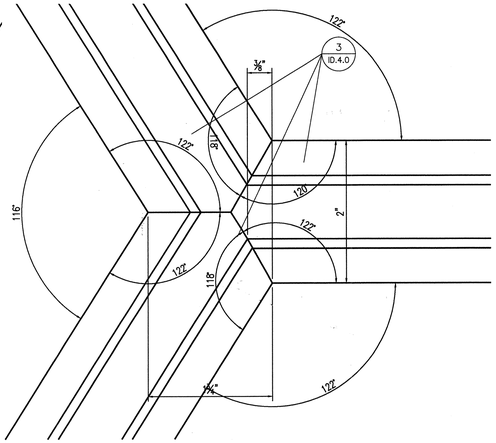

12 GAMES TRIM ASS'Y. TRIPLE-JOINT
FULL SIZE

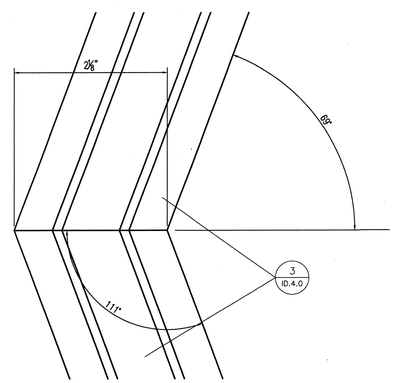

13 GAMES TRIM ASS'Y. DOUBLE--JOINT
FULL SIZE

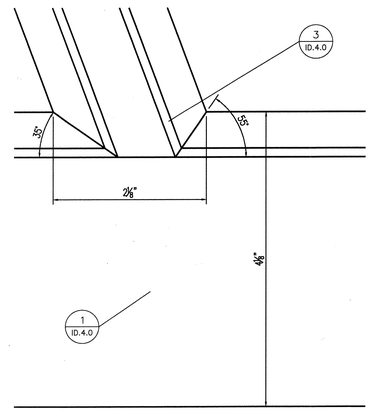

14 GAMES TRIM ASS'Y. TRIM-TO-BASE JOINT
FULL SIZE

ISSUED FOR PRESENTATION
NOVEMBER 9, 2011

EMBREY
PARTNERS, LTD

SAN ANTONIO, TX

KELLER SPRINGS
CLUBHOUSE
ADDISON, TX

MISC. DETAILS

© 2011 M. FORD & ASSOCIATES INC.
THIS DOCUMENT IS PUBLISHED AS AN INSTRUMENT OF SERVICE AND IS GIVEN IN CONFIDENCE. IT REMAINS THE PROPERTY OF M. FORD & ASSOCIATES, INC. THIS DOCUMENT, THE ELECTRONIC DATA ASSOCIATED WITH IT, AND THE INFORMATION CONTAINED WITHIN MAY NOT BE DUPLICATED, USED, OR DISCLOSED WITHOUT WRITTEN CONSENT OF M. FORD & ASSOCIATES, INC. HOUSTON, TEXAS

ford

m. ford & associates
interior design
99 detering street
suite 165
houston, tx 77007
phone 713-630-0800
fax 713-630-0814
mford@mfordassociates.com
www.mfordassociates.com

drawn by:
Queen of the World

SHEET NO.

ID.4.1