Paper towels are manually withdrawn through dispensing slot. A towel adapter ensures that towels feed properly until depleted.

replacing towels for an empty or partially empty unit. Dispenser supply is replenished and waste container is emptied manually

on cycles determined by maintenance needs. Locking full-face door over compartments prevents unauthorized access or

RECESSED PAPER TOWEL DISPENSER/WASTE RECEPTACLE

Desert Ray Products

WATROUS

Unit will continue to feed properly when reloaded with a partial load in place. Refill dispenser by unlocking door and

THIS MANUFACTURER RESERVES THE RIGHT TO MAKE CHANGES IN DESIGN OR DIMENSIONS WITHOUT FORMAL NOTICE

AMERICAN DISPENSER

Accessory Specialties

MODEL No: 9477 AMERICAN SPECIALTIES, INC. 441 Saw Mill River Road, Yonkers, NY 10701 (914) 476-9000 RECESS MOUNTED TOILET SEAT COVER DISPENSER DISPENSER CUT-DUT SMOOTH AND ROUNDED MINIMUM DEPTH 2-1/2" (64mm) CABINET BODY TUMBLER LOCK RIMLESS PIN TYPE -15/16"

Recess Mounted Toilet Seat Cover Dispenser shall hold and dispense 500 standard single or half-fold paper toilet seat covers contained in supply box. Cabinet and door shall be fabricated of alloy 18-8 stainless steel, type 304. Cabinet shall be 22 gauge, with a 1" (25mm)wide perimeter return to lay flat against wall. Full face door shall be 16 gauge and shall be free of miters, welding or open seams with 15/16"(24mm) square horizontal returns to wall and 3"/4 rounded vertical edges. Door shall be attached to the edge of unit with a full length 3/16" (5mm) dia. stainless steel multi-staked plano hinge and shall be held closed with a rimless tumbler lock keyed alike to other ASI washroom equipment. Cover dispensing slot shall have a fully deburred flat edge for snag-free dispensing and user safety. Structural assembly of cabinet and door components shall be of welded construction and shall have no exposed fasteners or welded seams. All exposed surfaces shall have a N4 satin finish.

SECTION "A"

Recess Mounted Toilet Seat Cover Dispenser shall be Model N9477 as manufactured by American Specialties, Inc., 441 Saw Mill River Road, Yonkers, New York 10701-4913

INSTALLATION

Unit is mounted in wall recess using N10 self tapping screws (by others). Mounting holes are provided in side and rear walls of cabinet and are accessible through door for installation. For compliance with ADA Accessibility Guidelines, unit should be installed so that center line of dispenser slot is(4016mm) maximum above finished floor (AFF). Typical installation height for general utility is 46' (1168mm) from bottom of trim AFF (46-3/4-1187mm> to bottom edge RWO AFF).

Rough Wall Opening (RWO) required is...... 15-3/4" W x 11-1/4" H x 2-5/8" D (400mm x 285mm x 67mm)


Covers are self-feeding until supply is depleted. Unit is manually reloaded with a full box through access door on a schedule determined by maintenance requirements.

AMERICAN DISPENSER Accessory Specialties

WATROUS Desert Ray Products

THIS MANUFACTURER RESERVES THE RIGHT TO MAKE CHANGES IN DESIGN OR DIMENSIONS WITHOUT FORMAL NOTICE

RECESSED TOILET SEAT COVER DISPENSER

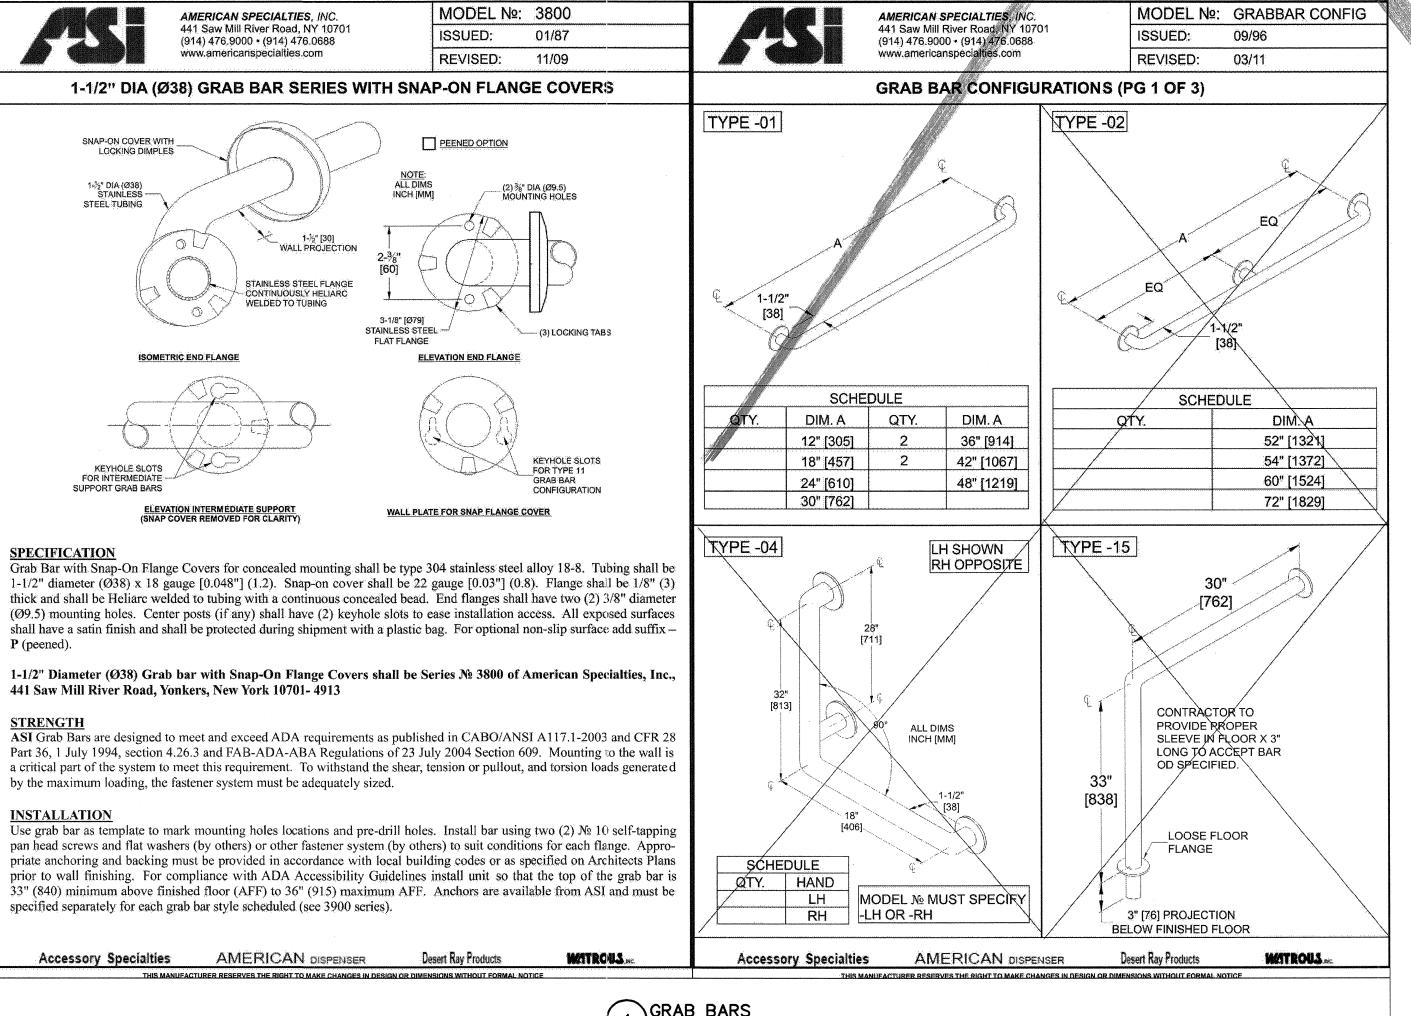

MODEL №: 20364 AMERICAN SPECIALTIES, INC. 441 Saw Mill River Road, NY 10701 (914) 476-9000 ISSUED: 08/09 www.americanspecialties.com

AUTOMATIC SOAP DISPENSER

TOP VIEW SOAP NOZZLE RECESSED SENSOR-MAGNETIC KEY ADJUSTMENT-SIDE VIEW

Automatic Soap Dispenser shall hold 33.8 oz (1000 ml) of soaps and lotions within the viscosity range of 50 - 3500 cP (MPa·s) and dispense in cycles of owner-adjustable single shot volume ranging from 0.02 oz to ½ oz (½ ml to 15 ml) with factory initial setting of 0.034 oz (1 ml). Operation is initiated by hands-free sensor controlled by microprocessor digital circuitry powered by four (4) AA size 1.5 V batteries (supplied by others) in a concealed compartment and locked inside umit bottom. Unit shall be fabricated of 22 gage type 304 stainless steel alloy 18-8 (.031" [0.8] thick) with a uniform satin finish over all exposed surfaces. Cover shall have lock keyed alike with other ASI washroom accessories. Unit shall have an LED to indicate function and operational condition on front face. Internal tank shall be translucent to show quantity of soap remaining at any time when cover is opened and shall have an internal shut-off valve to facilitate filling and external storage of full tanks. Owner shall easily and securely adjust dispensing cycle with magnetic fob provided. Unit shall mount to wall on concealed base plate with screws secured under locked cover. Mounting template and Owner's Manual shall be provided with unit in each carton.

FRONT VIEW

Automatic Soap Dispenser shall be Model № 20364 of American Specialties, Inc., 441 Saw Mill River Road, Yonkers, NY 10701-4913

Secure concealed base plate to wall with four (4) self-tapping screws (supplied: two (2) № 8 x 3/4" (M4.5 x 20) pan head & two (2) No 8 x 3/4" (M4.5 x 20) flat head) through mounting holes provided in plate into plastic wall anchors (supplied) or other suitable mounting system (provided by others). Install four (4) AA size 1.5 V cells (supplied by others) in concealed battery compartment according to polarity indication and snap-latch battery door. Fill tank with appropriate viscosity soap to correct level and lock door. Locking door activates concealed button to initiate operation. Retain key & fob provided for future access.

Unit shall operate each time an object is positioned within the sensing distance of $3-\frac{1}{8}$ " (80) $\pm \frac{3}{8}$ " (10) from unit bottom. Owner may change dispensing cycle at any time with magnetic fob provided through tamperproof port. A drop of 0.034 oz (1 ml) of soap will be pumped out of the nozzle on unit bottom if unit is left in factory setting. Unit will dispense soap on each activation while batteries are at suitable charge level (LED is not flashing) and correct viscosity soap is present in the tank. Door has lock to provide security and vandal resistance after each soap refill and battery change service interval.

AMERICAN DISPENSER METTROUS. Desert Ray Products 'HIS MANUFACTURER RESERVES THE RIGHT TO MAKE CHANGES IN DESIGN OR DIMENSIONS WITHOUT FORMAL NOTICE.

3 SOAP DISPENSER

ASTIC ROLLER



SPECIFICATION

FRONT VIEW

Recessed Dual Roll Toilet Paper Holder shall hold and dispense all standard core roll tissue up to 6" diameter (Ø152) roll and shall be fabricated of stainless steel type 304 alloy 18-8. Outer shells shall have two (2) perforated lugs for wet wall anchoring or two (2) dimpled holes for dry wall installation each. Rollers shall be chrome plated high impact resistant ABS plastic and shall be spring-loaded. Mounting style shall be wet wall or dry wall as chosen by option and indicated by code suffix. All exposed surfaces shall be satin or bright finish as chosen by option and indicated by code suffix.

Recessed Mounted Dual Roll Toilet Paper Holder shall be Model No 74022 of American Specialties, Inc., 441 Saw Mill River Road, Yonkers, New York 10701-4913

For Wet wall Recessed Mounting: Slop grout into rough wall opening. Apply grout to back of unit and on perforated lugs and push unit into opening to seat flange flush with wall face. Allow unit to set and grout to cure before use.

For Standard Dry Wall Recessed Mounting: Use four (4) No 10 stainless steel Philips flat or oval head self tapping or wood screws (by others) of suitable length to penetrate blocking in back of RWO by approximately 1/2" (13). Apply a continuous bead of silicone sealant (by others) behind flange. Tighten screws to hold flange tight against finished wall face. Wipe off excess sealant immediately. Optional Method for Dry Wall Recessed Mounting: Order two (2) separate items Model Nº 39 dry wall clamps. Loosely attach clamps to the back of the unit with four (4) stainless steel Philips flat or oval head No 10B (or 10AB or 10BP) self tapping screws (provided by

others to suit wall conditions) through dimpled holes at back of shell. Apply a continuous bead of silicone sealant (by others) behind flange.

Insert into RWO and adjust clamps so that they grip inside wall surface through opening. Secure accessory to clamps and wall by tightening screws. Wipe off excess sealant immediately. For compliance with ADA Accessibility Guidelines install unit with centerline of rollers 19" (483) min AFF to 42" (1067) max AFF and "(178) min to 9" (229) max from front of commode to centerline of dispenser.

Rough Wall Opening (RWO) required is 11-3/4" W x 5-1/2" H x 2" D (298 x 140 x 51)

Optional finish and mounting style must be specified as either bright or satin and wet or drywall. Specify finish and mounting by adding code suffixes to model number (i.e. 74022-SD or 74022-SW or 74022-BD or 74022-BW).

 Specifies ory Specialt	Bright Finish	Dry wall holes		Wet wall lugs Products WATROUS
Option	В	D	S	W

HIS MANUFACTURER RESERVES THE RIGHT TO MAKE CHANGES IN DESIGN OR DIMENSIONS WITHOUT FORMAL NOTICE

5 RECESSED DUAL TOILET PAPER DISPENSER

EMBREY PARTNERS, LTD

SAN ANTONIO, TX

STRUCTION 312 CONS 0R ISSUED F(APRIL

ADDISON,

(C) 2012 M. FORD & ASSOCIATES INC. THIS DOCUMENT IS PUBLISHED AS AN INSTRUMENT OF PROPERTY OF M. FORD & ASSOCIATES, INC. THIS DOCUMENT, AND THE INFORMATION CONTAINED WITHIN MAY NOT BE DUPLICATED OR DISCLOSED WITHOUT WRITTEN



H

CESSOR

TR


S

H

X

SIDE VIEW

m. ford & associates interior design 99 detering street suite 165 houston, tx 77007 phone 713-630-0800 fax 713-630-0814 mford@mfordassociates.com www.mfordassociates.com

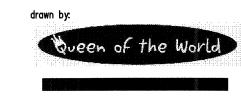

SHEET NO.