


ISSUED FOR CONSTRUCTION
APRIL 23, 2012

KELLER SPRINGS CLUBHOUSE
ADDISON, TX

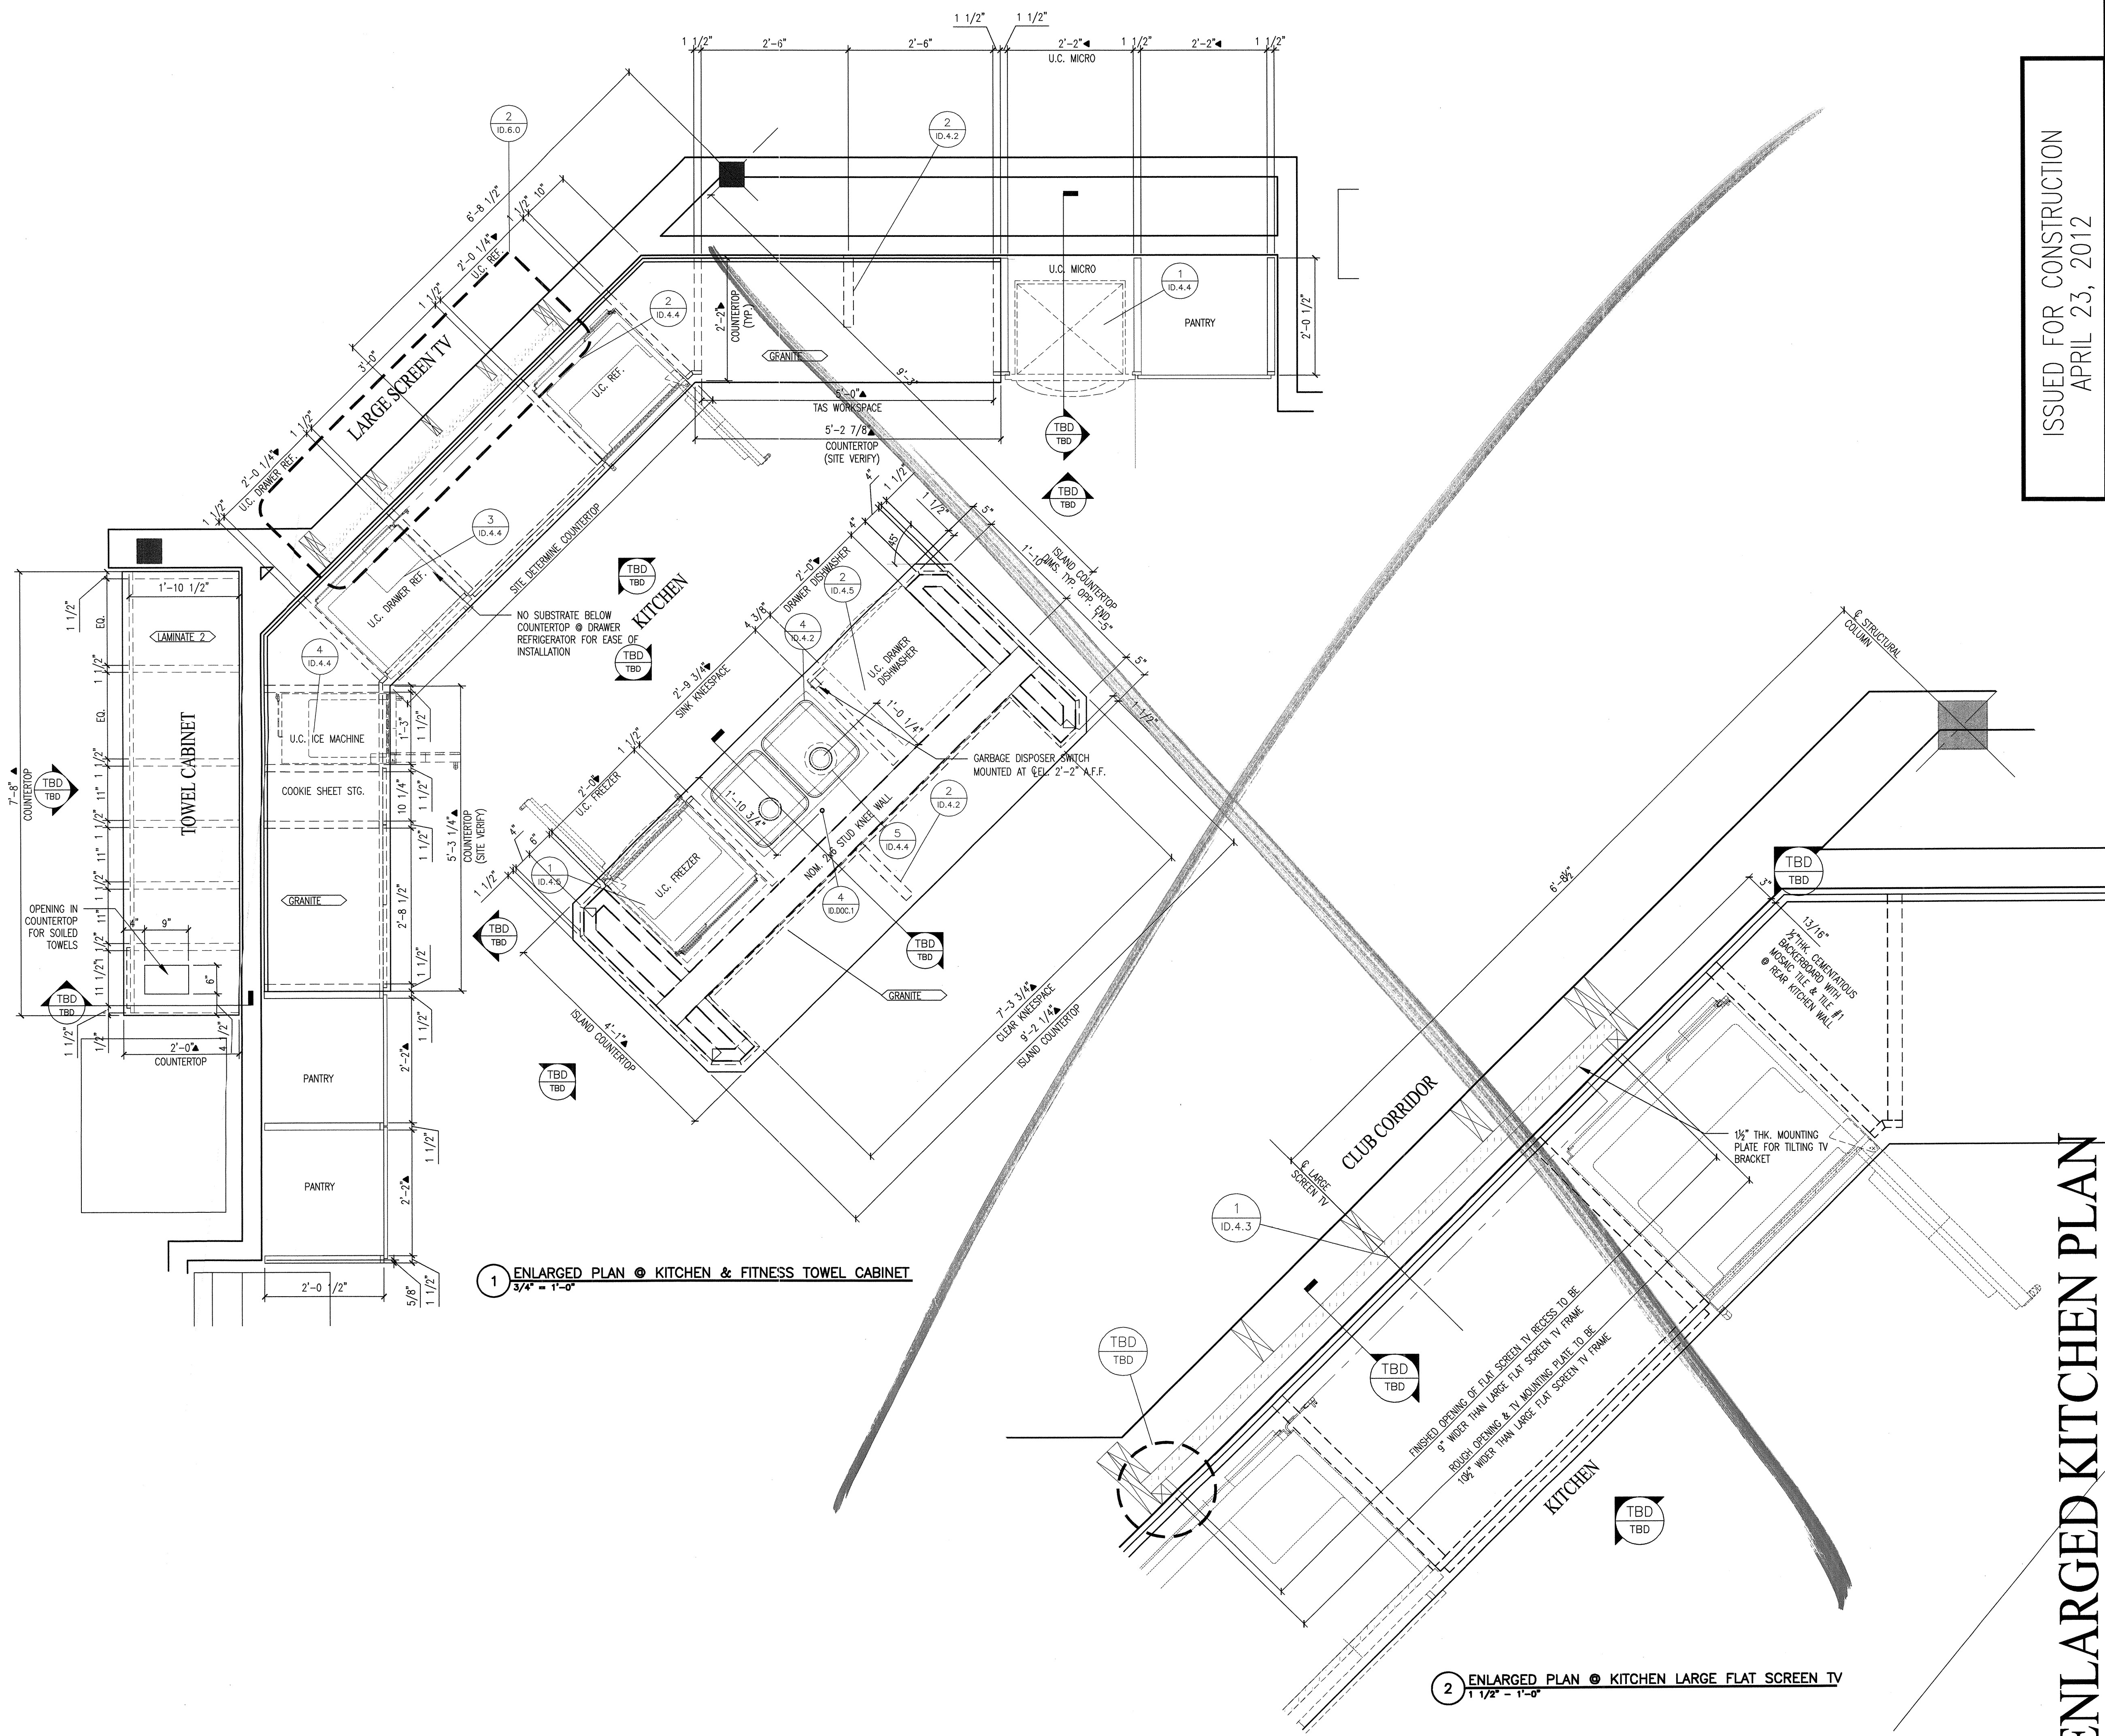

1 ENLARGED PLAN @ KITCHEN & FITNESS TOWEL CABINET
3/4" = 1'-0"


2 ENLARGED PLAN @ KITCHEN LARGE FLAT SCREEN TV
1 1/2" = 1'-0"

ENLARGED KITCHEN PLAN

© 2012 M. FORD & ASSOCIATES, INC.
THIS DOCUMENT IS PUBLISHED AS AN INSTRUMENT OF SERVICE AND IS GIVEN IN CONFIDENCE. IT REMAINS THE PROPERTY OF M. FORD & ASSOCIATES, INC. THIS DOCUMENT AND THE INFORMATION CONTAINED HEREIN MAY NOT BE DUPLICATED OR DISCLOSED WITHOUT WRITTEN CONSENT OF M. FORD & ASSOCIATES, INC. HOUSTON, TEXAS.



m. ford & associates
interior design
99 detersing street
suite 165
houston, tx 77007
phone 713-630-0800
fax 713-630-0814
mford@mfordassociates.com
www.mfordassociates.com

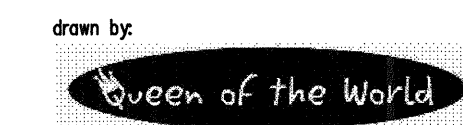

SHEET NO.

ID.6.0