



REVISED FOR CONSTRUCTION  
MAY 16, 2012

ENLARGED KITCHEN ELEVATIONS,  
SECTION @ TV RECESS & CORNER DETAIL

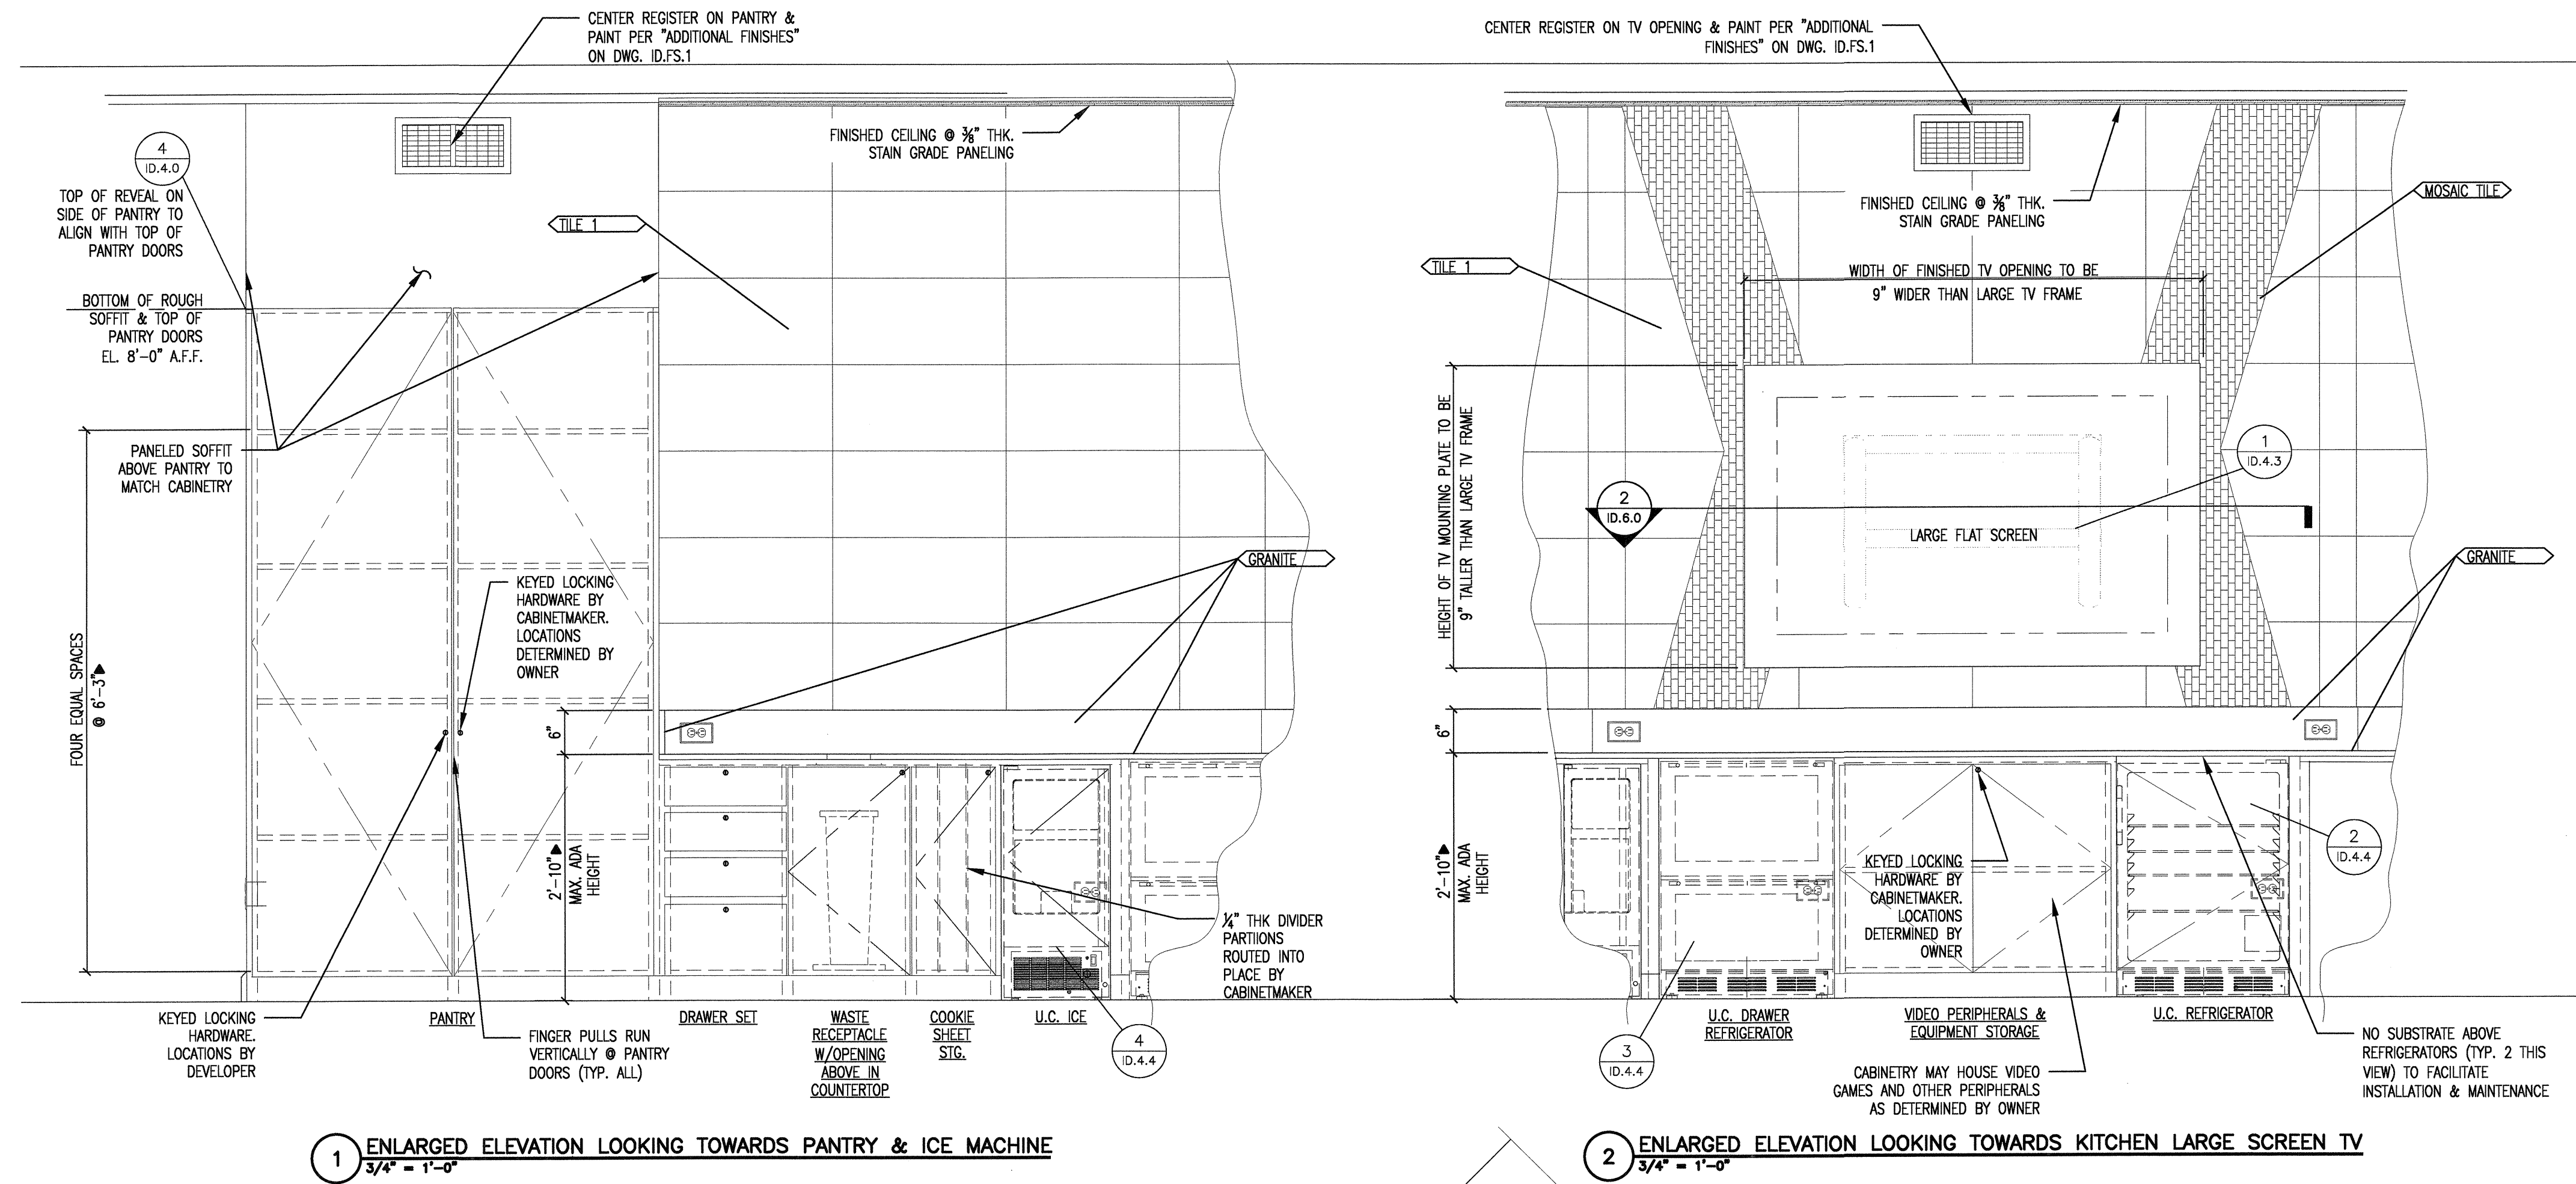


1 ENLARGED ELEVATION LOOKING TOWARDS PANTRY & ICE MACHINE  
3/4" = 1'-0"

2 ENLARGED ELEVATION LOOKING TOWARDS KITCHEN LARGE SCREEN TV  
3/4" = 1'-0"

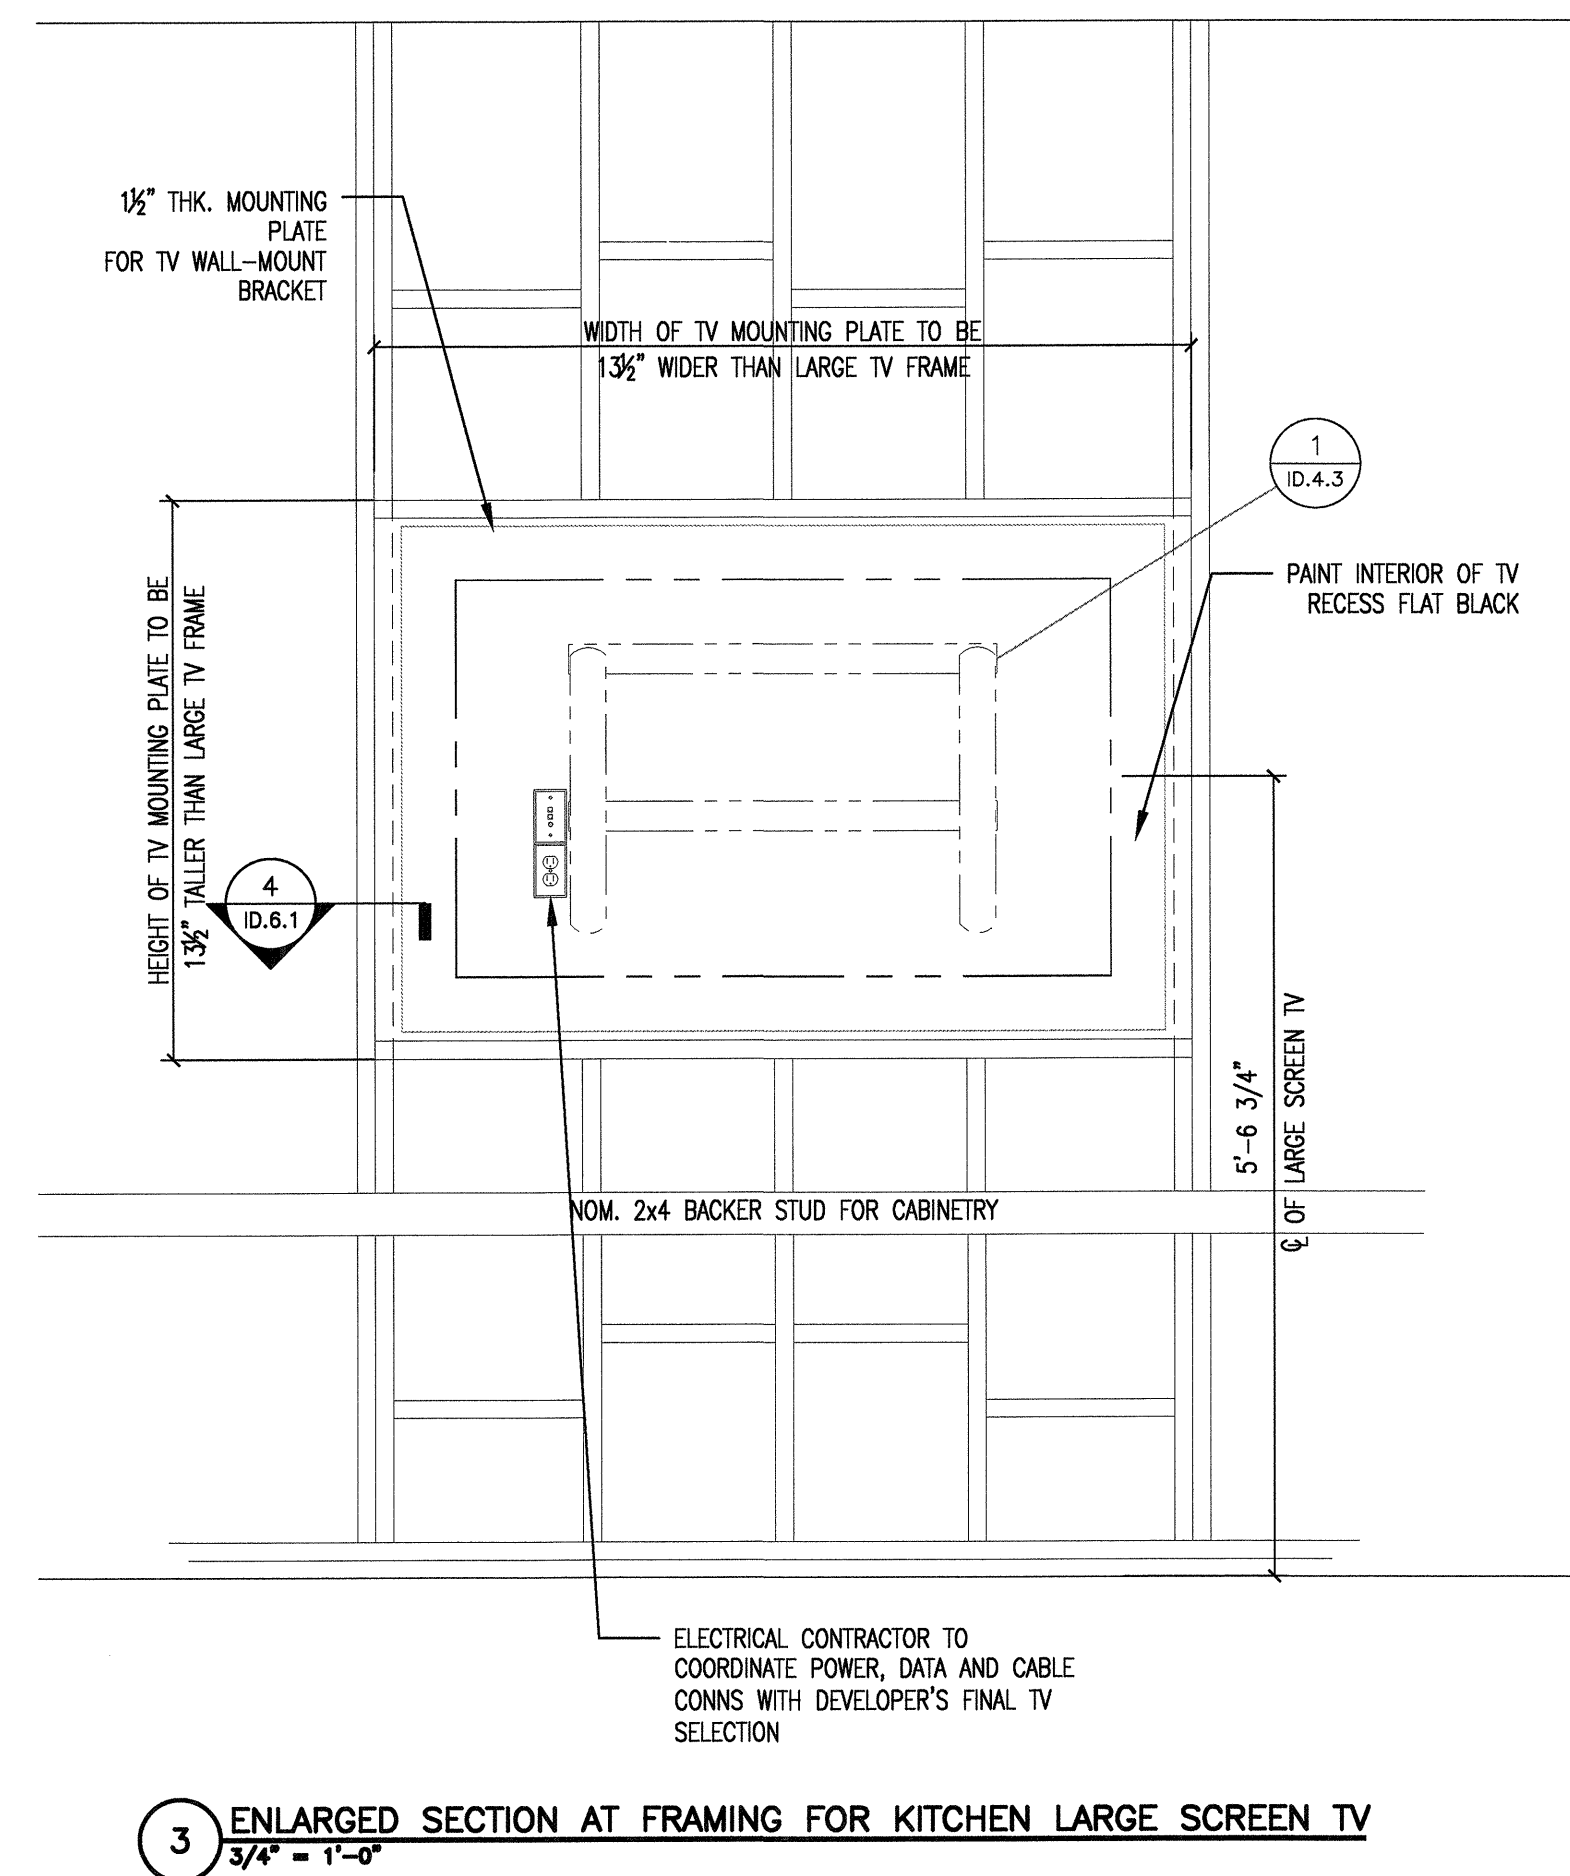


3 ENLARGED SECTION AT FRAMING FOR KITCHEN LARGE SCREEN TV  
3/4" = 1'-0"

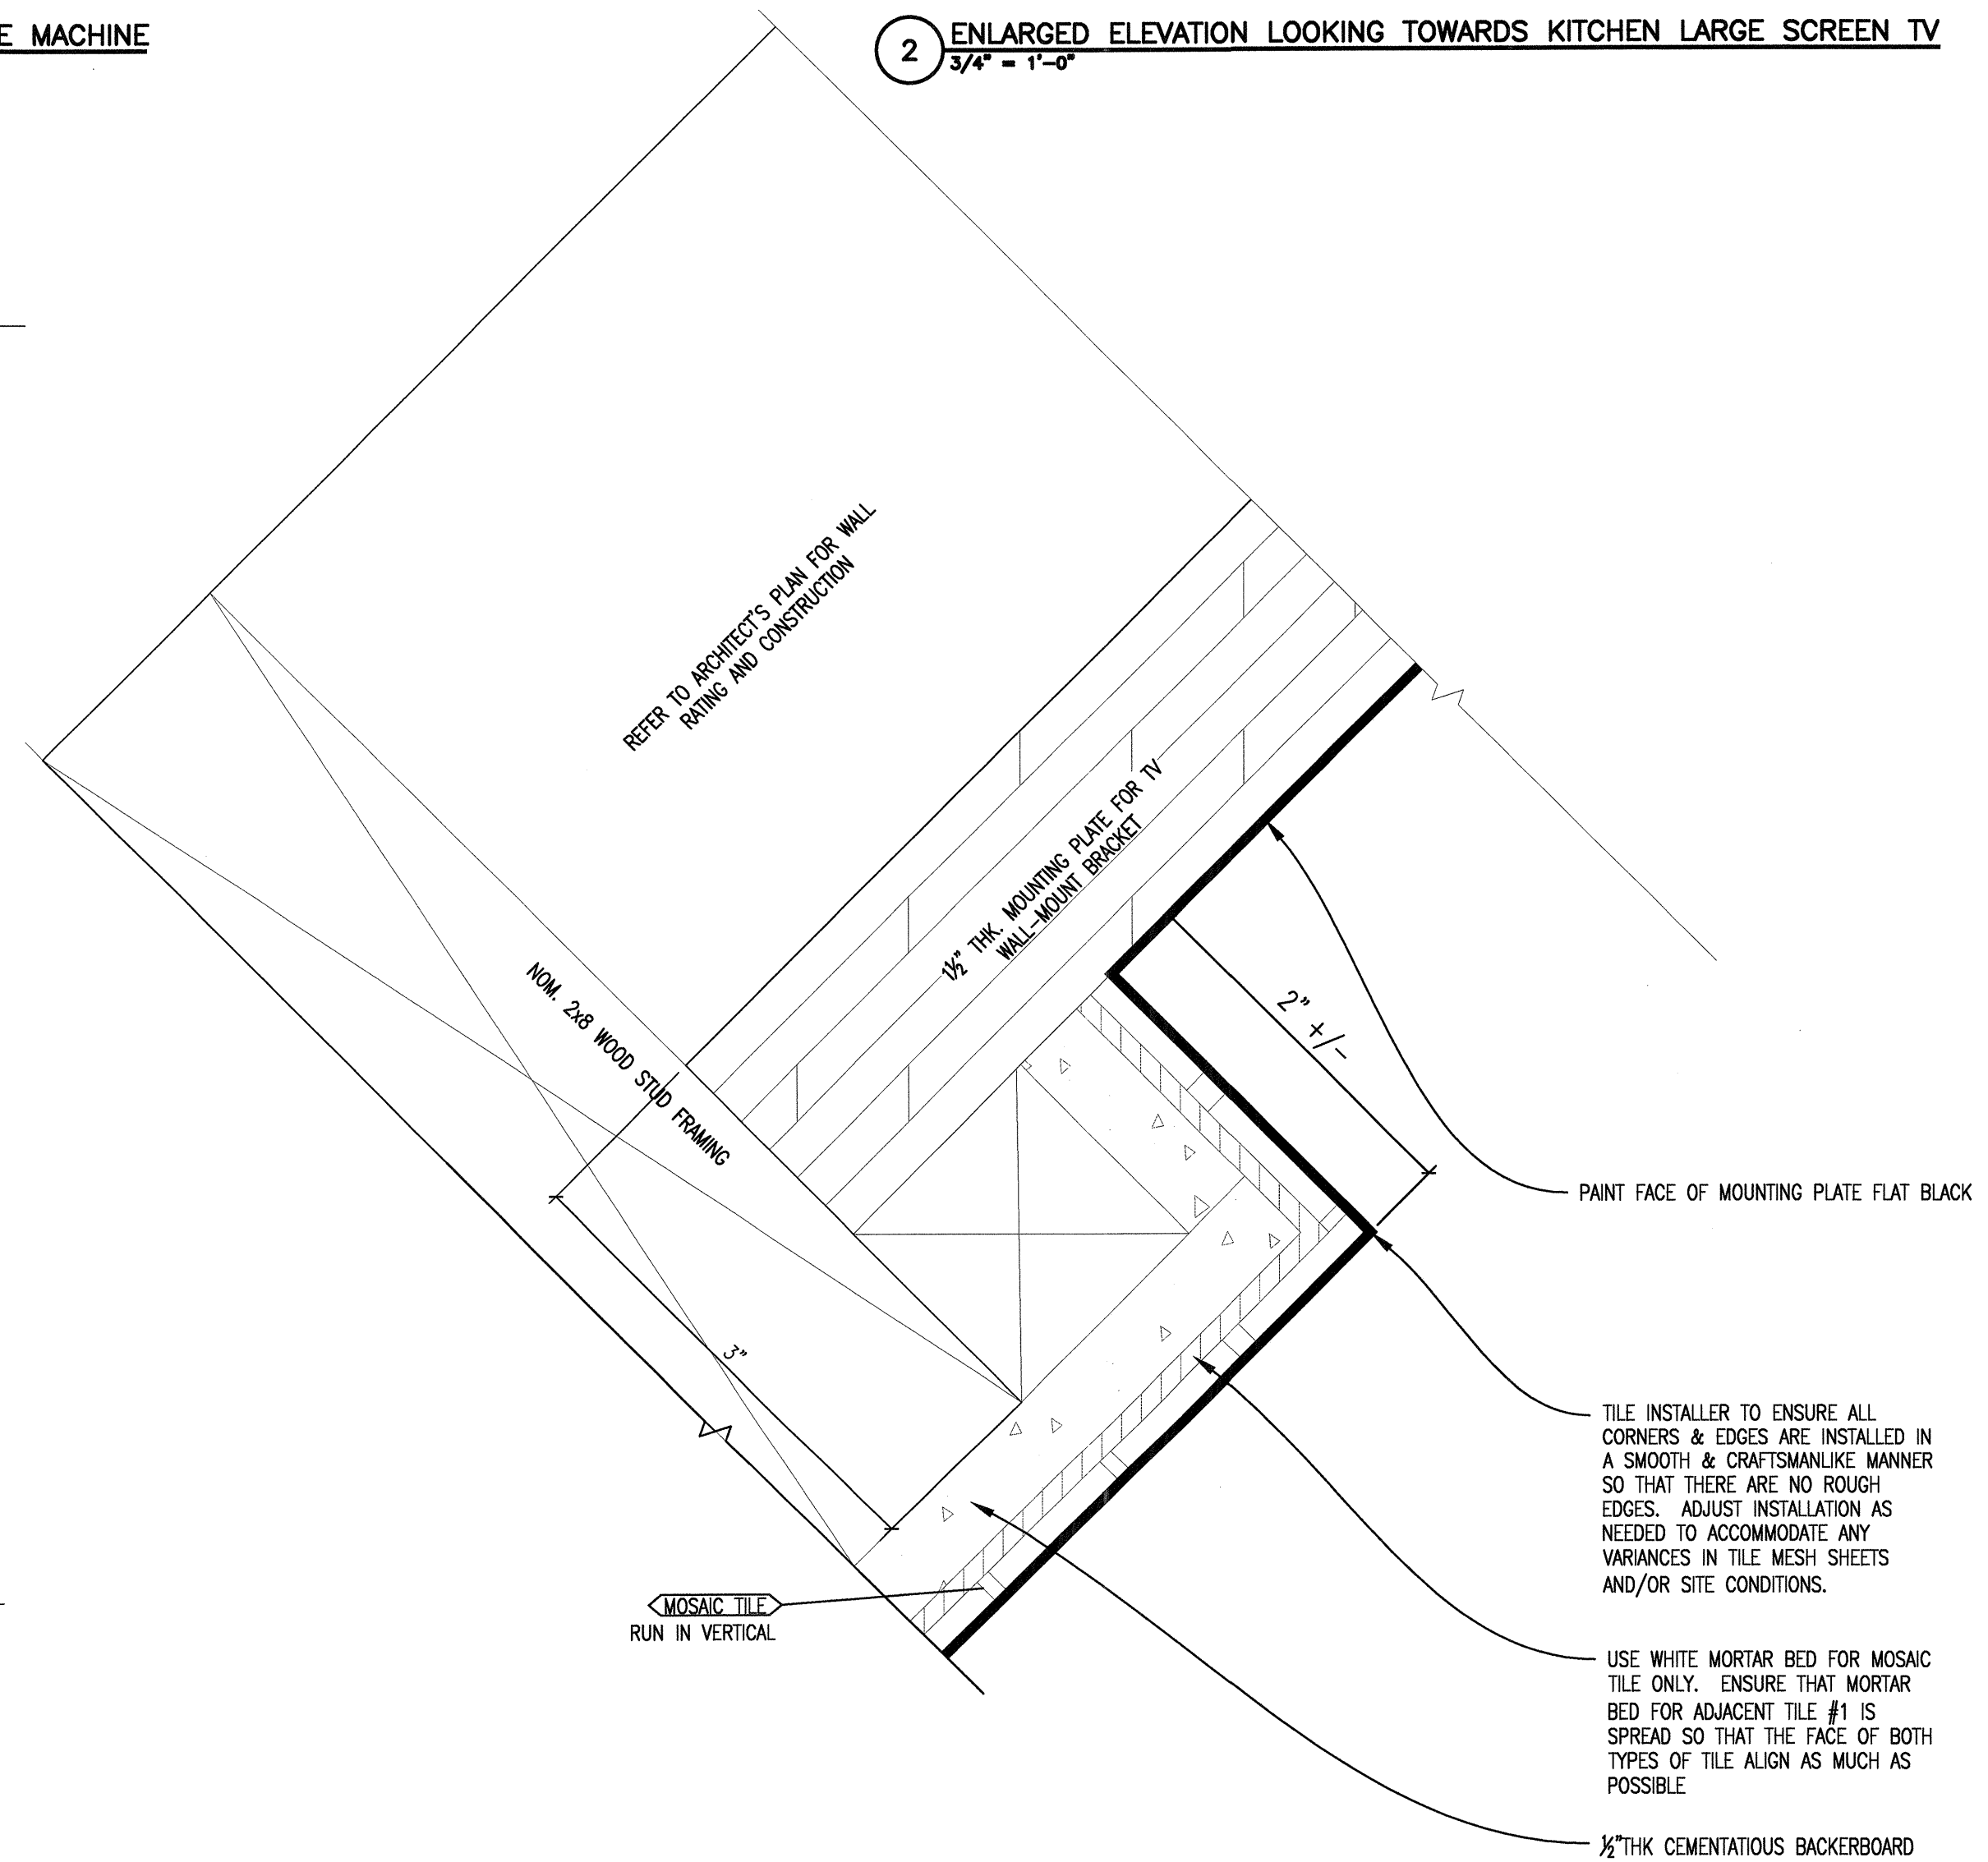

4 TYPICAL CORNER TILE WALL TRANSITION TO TV RECESS @ KITCHEN  
FULL SIZE

△ ADDED FABRICATION DETAILS 5-16-12

© 2012 M. FORD & ASSOCIATES INC.  
THIS DOCUMENT IS PUBLISHED AS AN INSTRUMENT OF SERVICE AND IS GIVEN IN CONFIDENCE. IT REMAINS THE PROPERTY OF M. FORD & ASSOCIATES, INC. THIS DOCUMENT, AND THE INFORMATION CONTAINED WITHIN, MAY NOT BE DUPLICATED OR DISCLOSED WITHOUT WRITTEN CONSENT OF M. FORD & ASSOCIATES, INC. HOUSTON, TEXAS

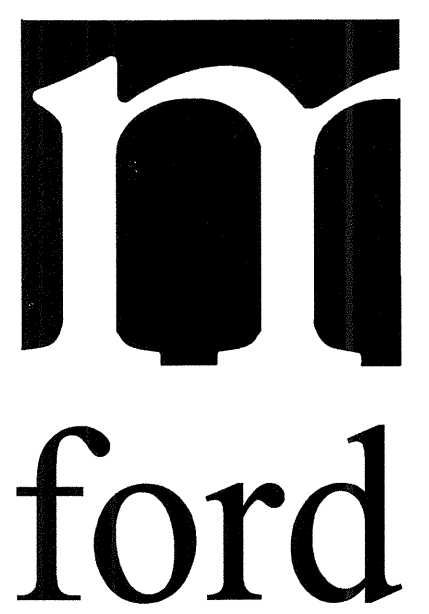

m. ford & associates  
interior design  
99 deterring street  
suite 165  
houston, tx 77007  
phone 713-630-0800  
fax 713-630-0814  
mford@mfordassociates.com  
www.mfordassociates.com

drawn by:  

SHEET NO.

ID.6.1