



REVISED FOR CONSTRUCTION  
MAY 16, 2012


KELLER SPRINGS CLUBHOUSE  
ADDISON, TX

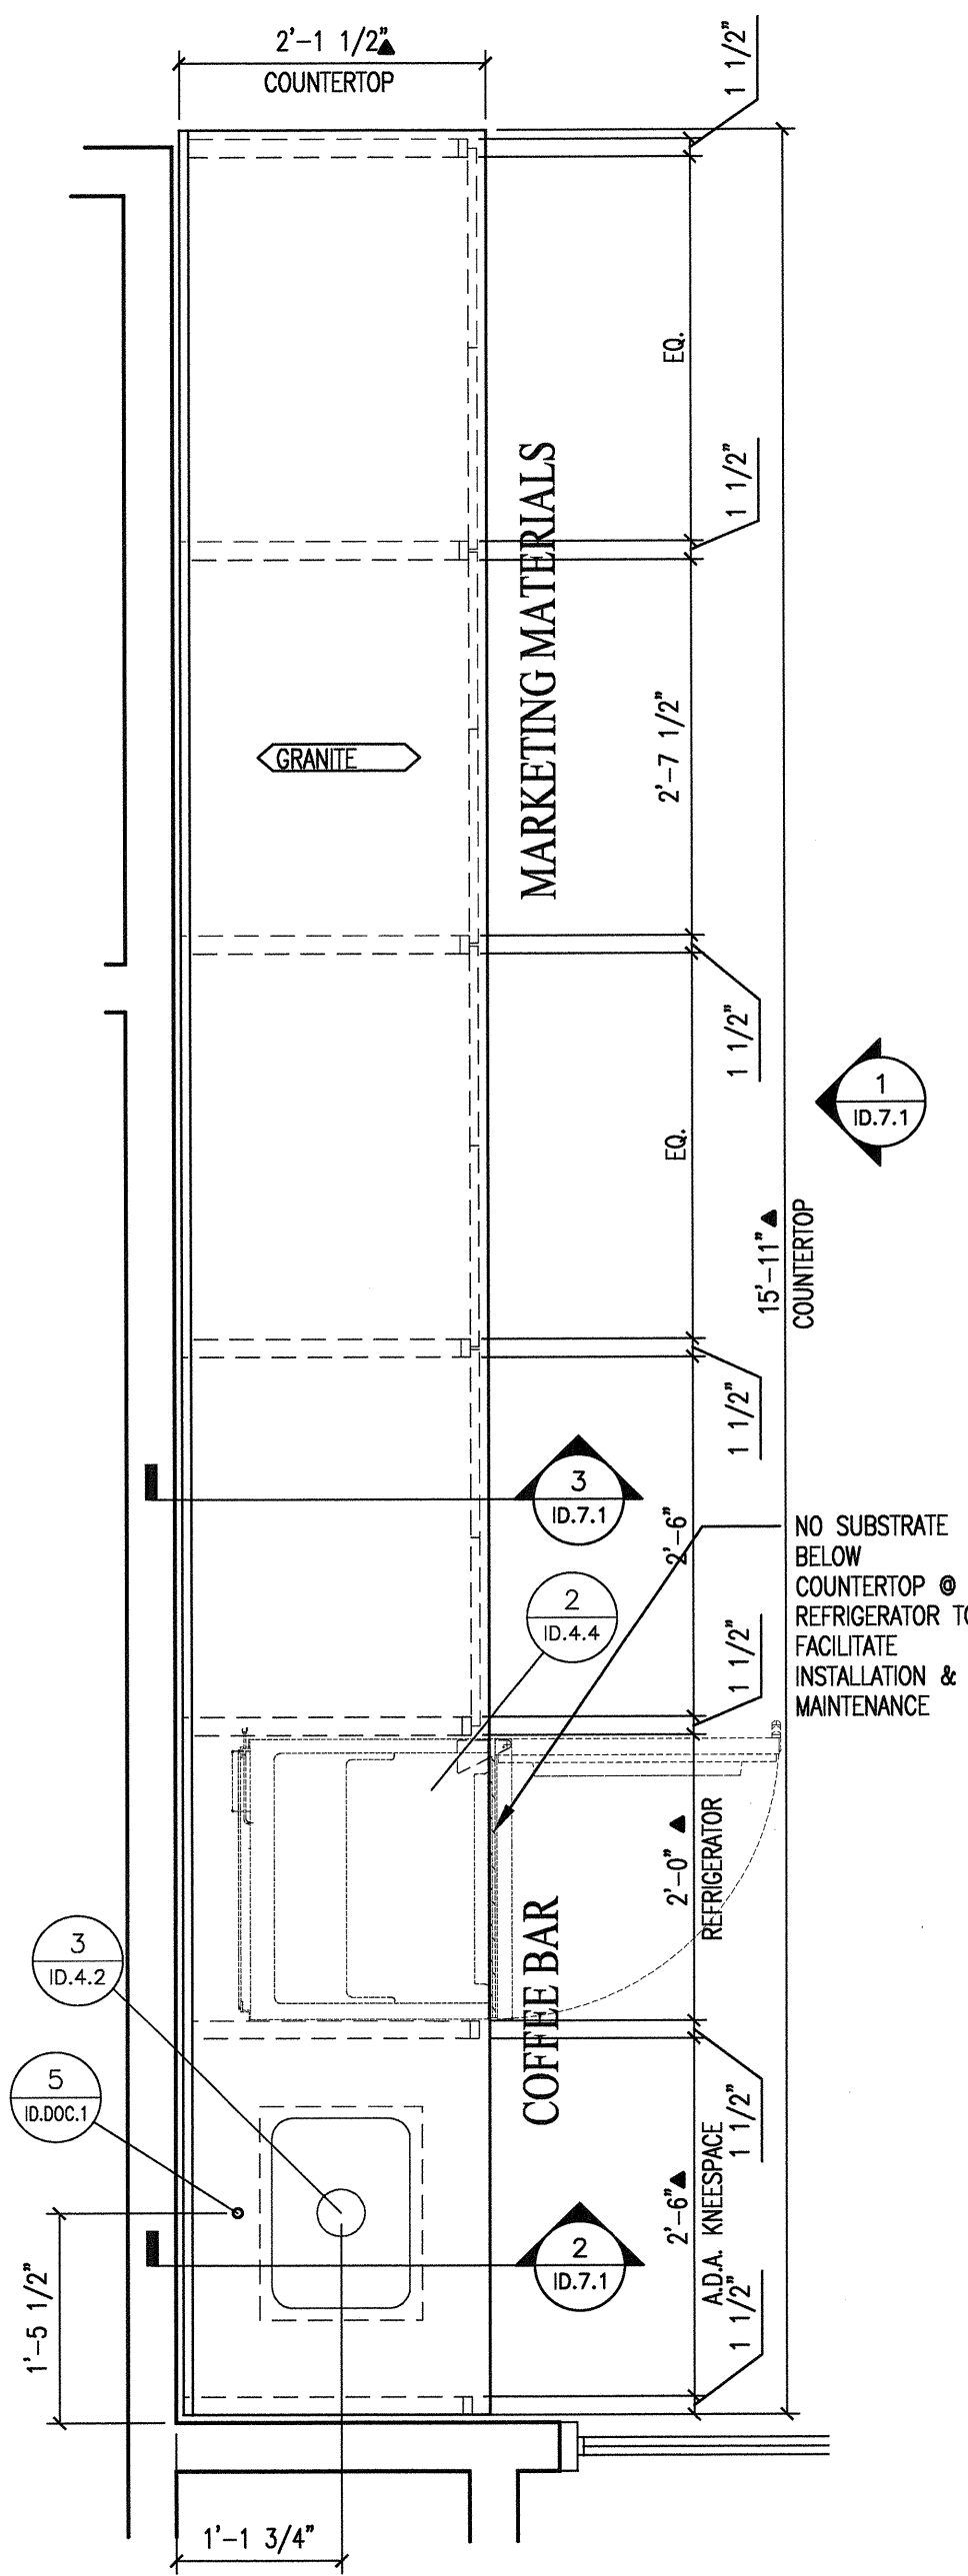


1 ENLARGED PLAN • COFFEE BAR & MARKETING CABINET  
3/4" = 1'-0"

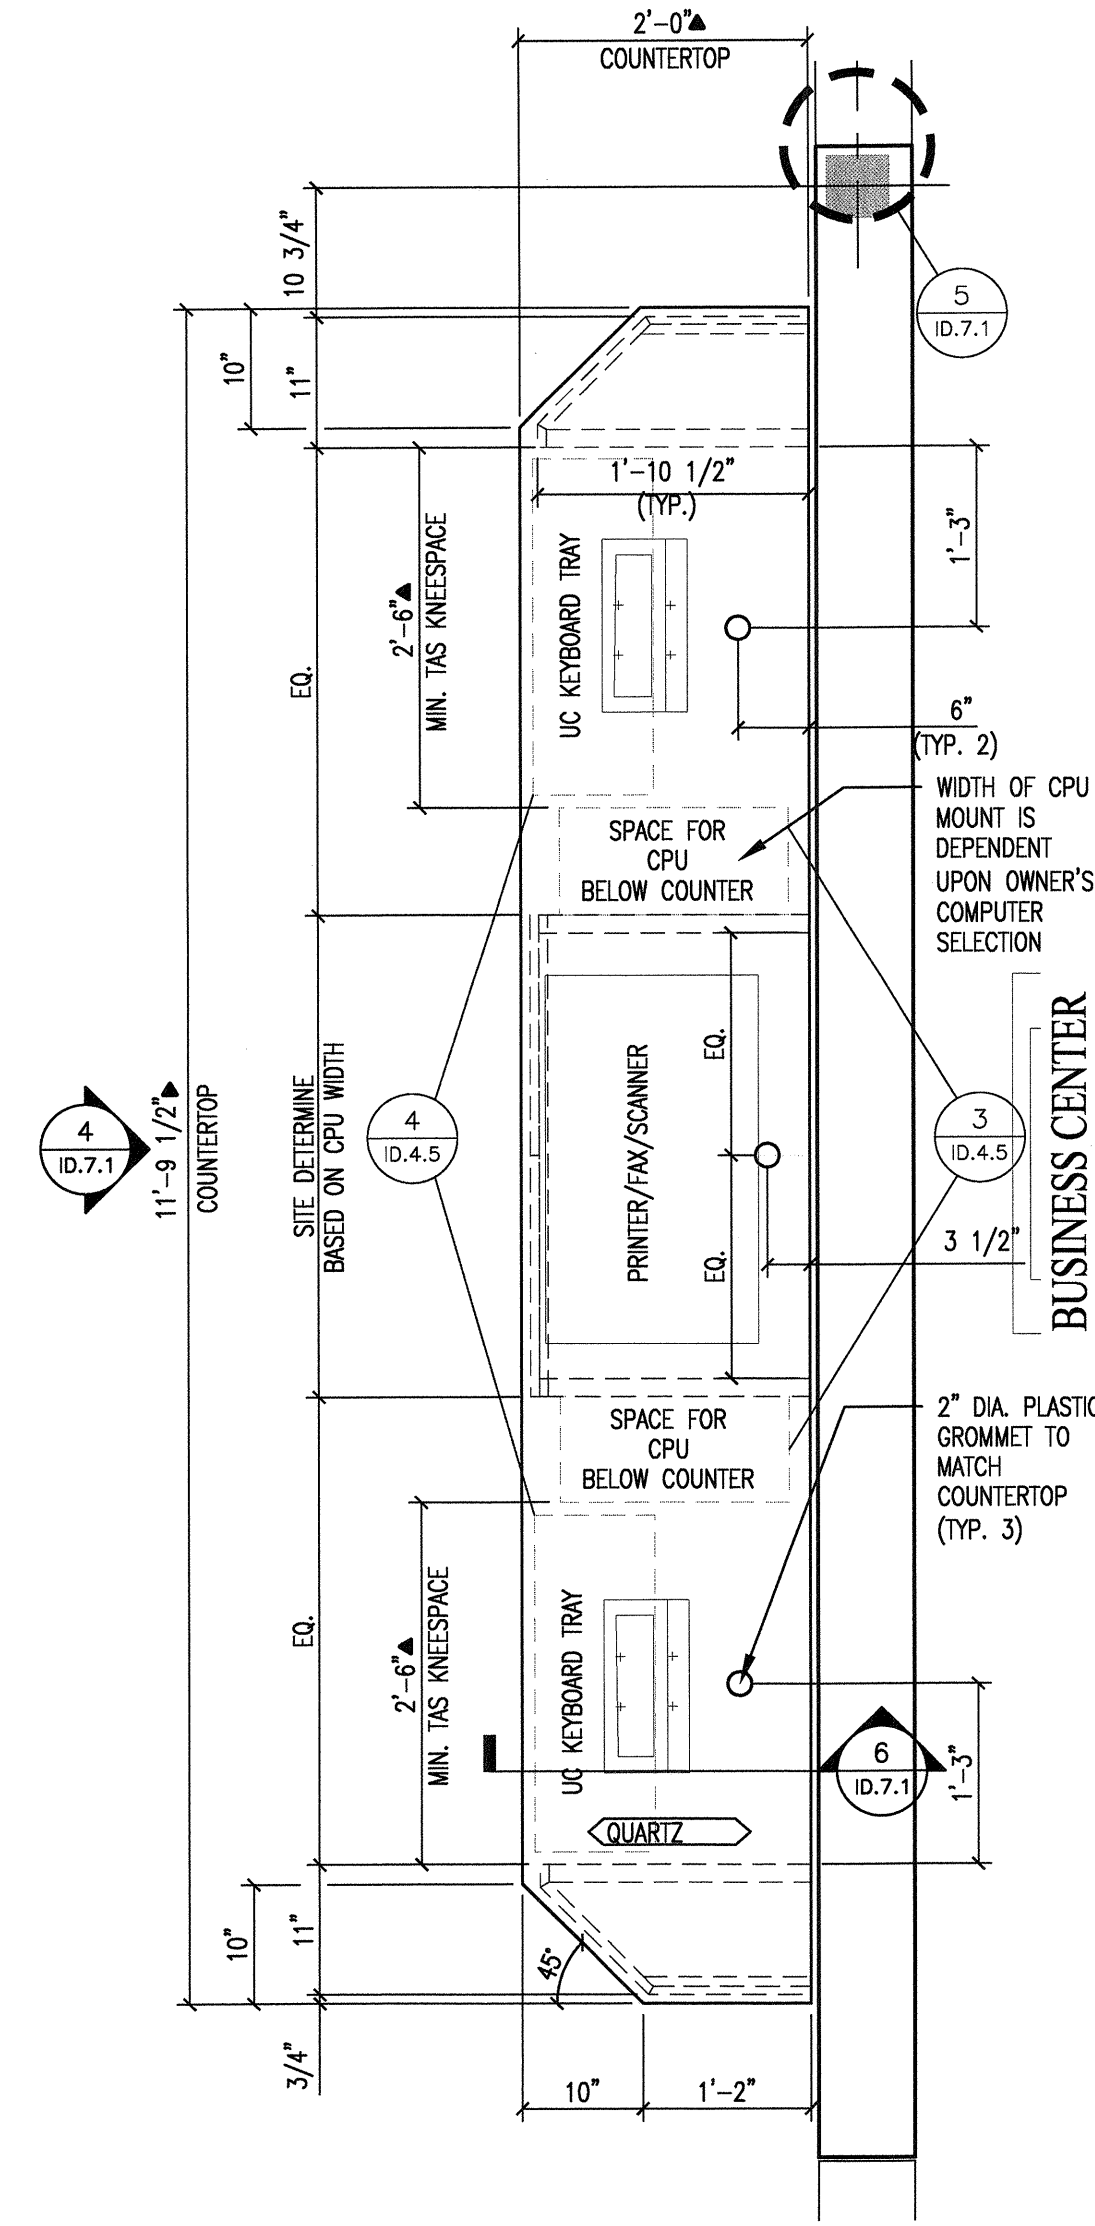


2 ENLARGED PLAN • BUSINESS CENTER  
3/4" = 1'-0"

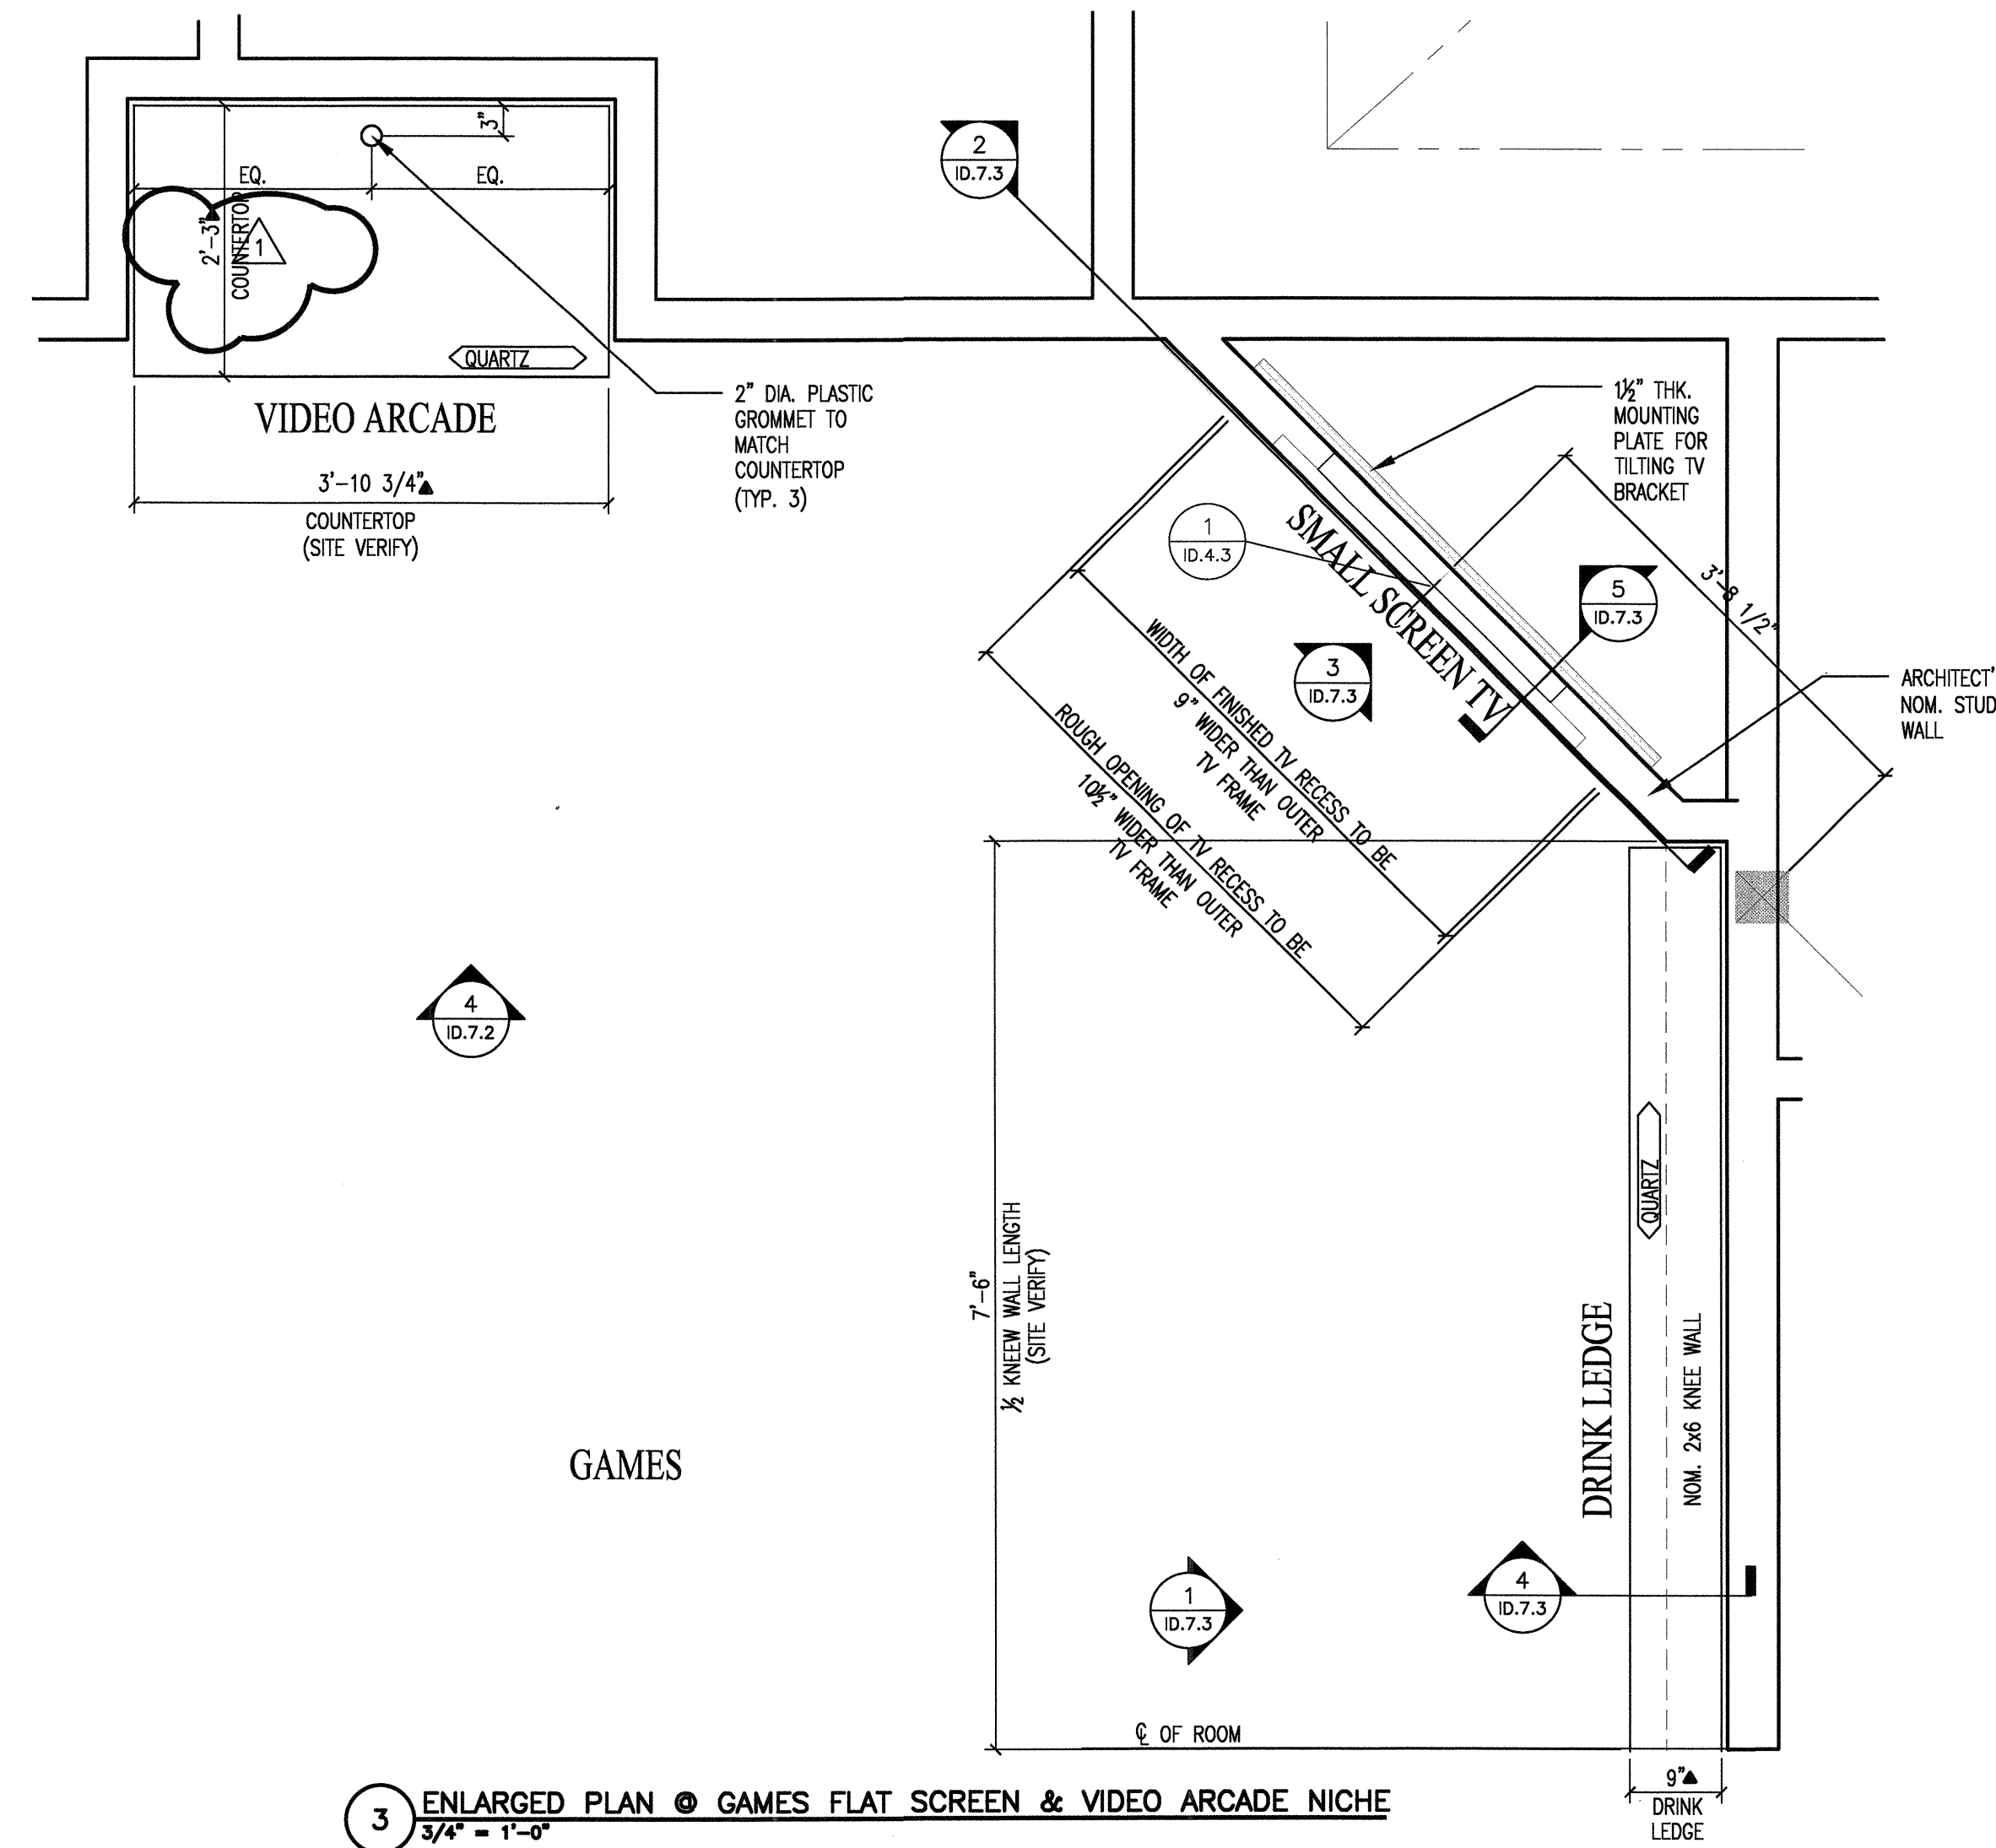

3 ENLARGED PLAN • GAMES FLAT SCREEN & VIDEO ARCADE NICHE  
3/4" = 1'-0"

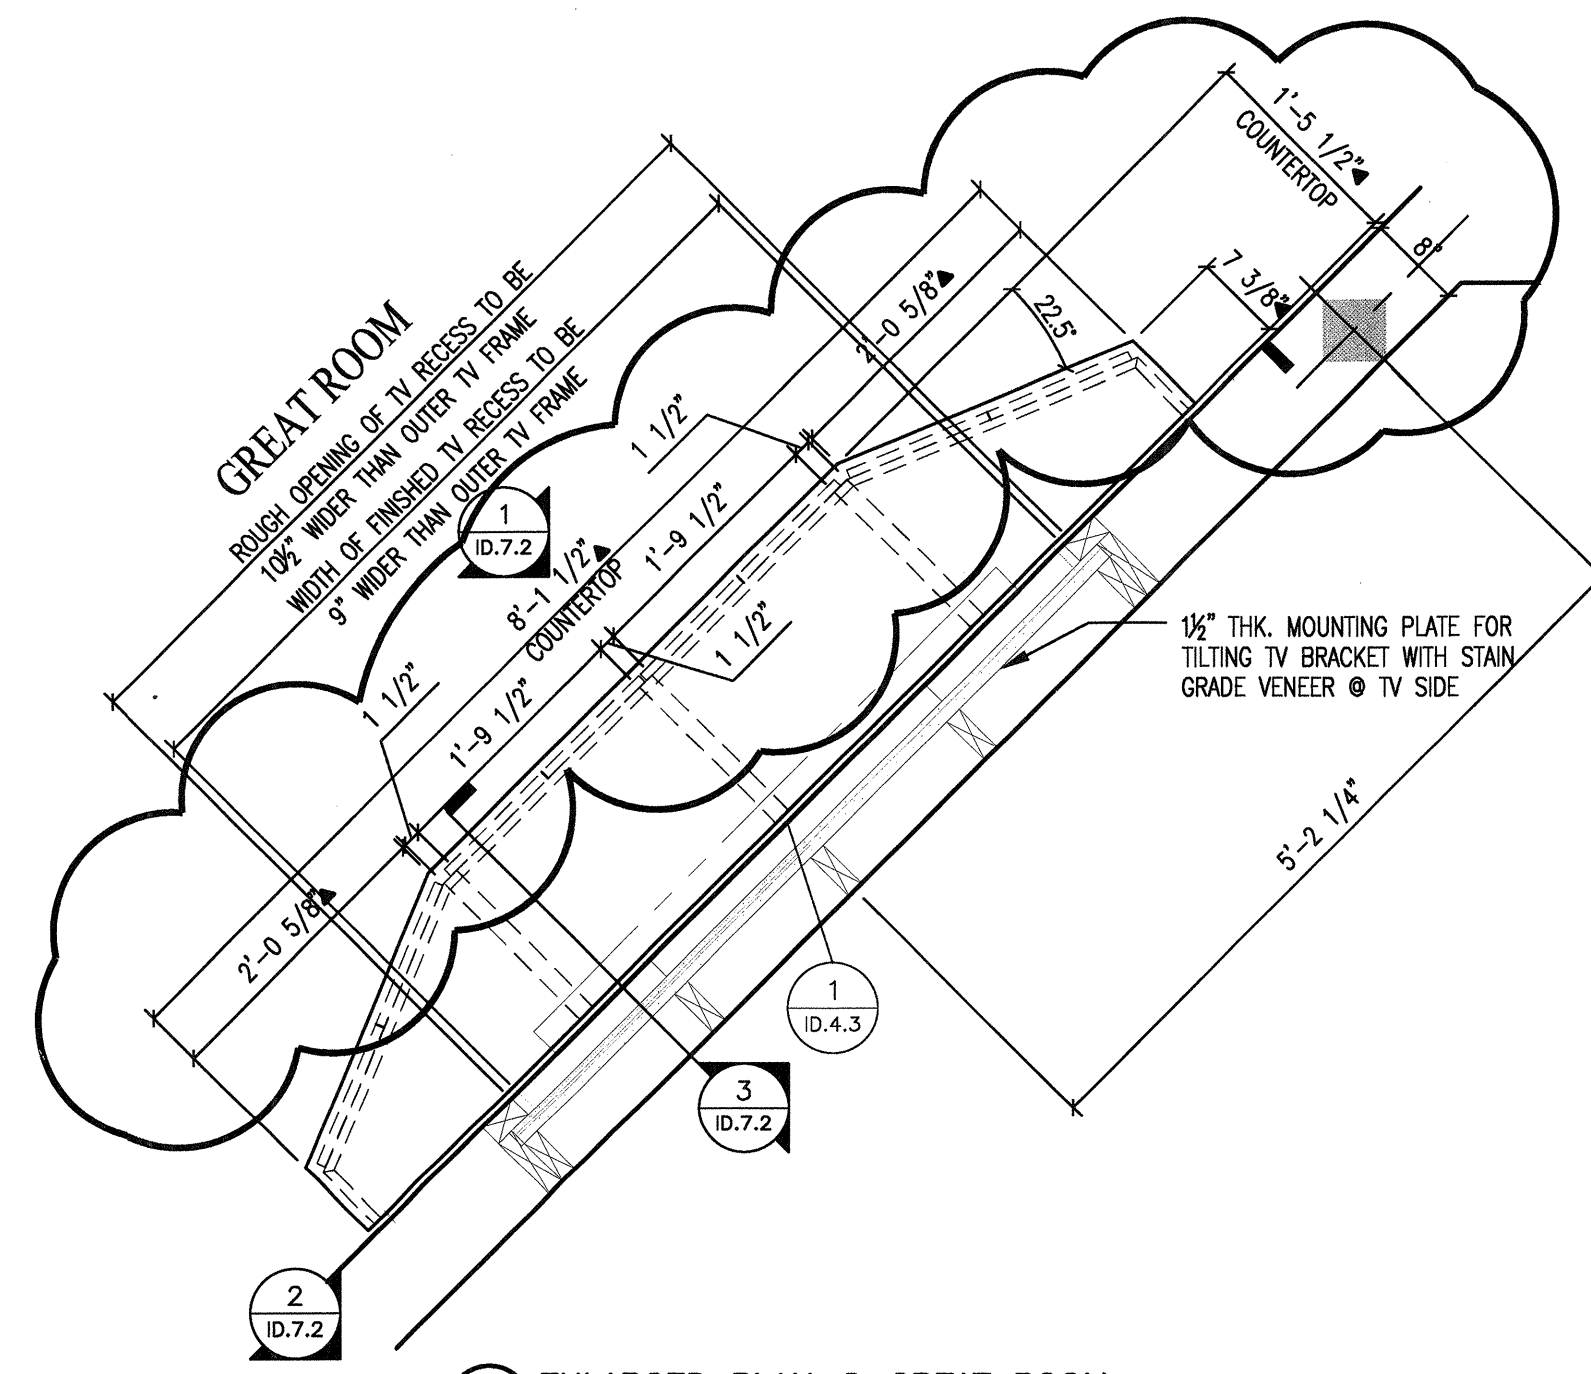

4 ENLARGED PLAN • GREAT ROOM  
3/4" = 1'-0"

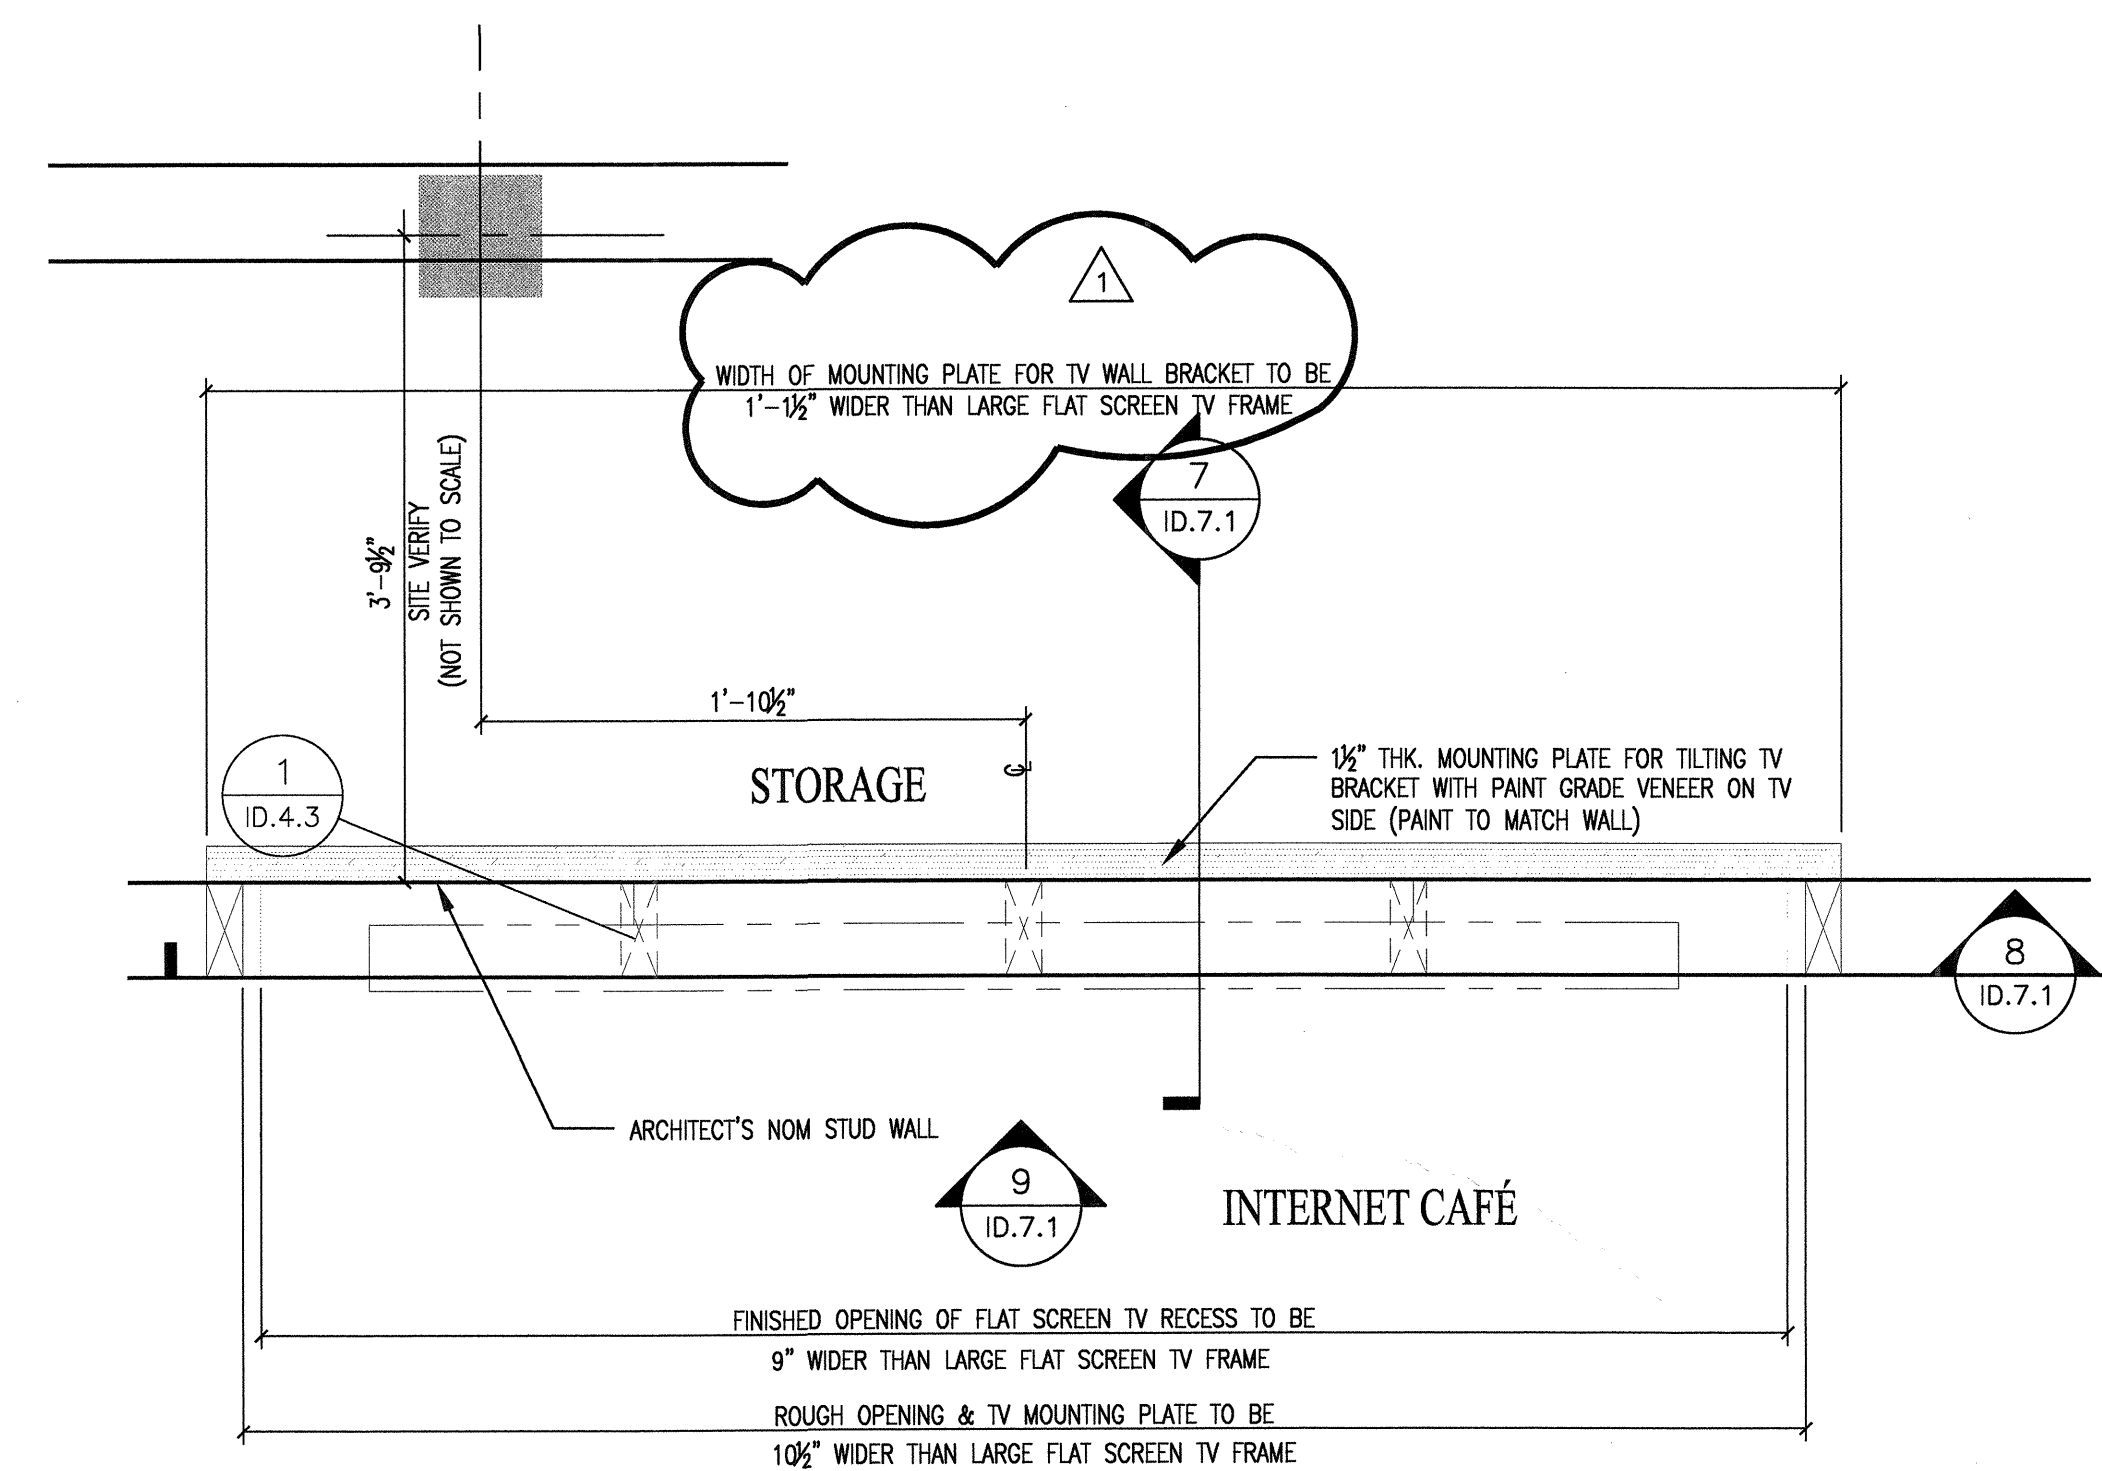

5 ENLARGED PLAN • INTERNET CAFE LARGE FLAT SCREEN TV  
1 1/2" = 1'-0"

1 ADDED FABRICATION DETAILS 5-16-12

© 2012 M. FORD & ASSOCIATES INC.  
THIS DOCUMENT IS PUBLISHED AS AN INSTRUMENT OF SERVICE AND IS GIVEN IN CONFIDENCE. IT REMAINS THE PROPERTY OF M. FORD & ASSOCIATES, INC. THIS DOCUMENT, AND THE INFORMATION CONTAINED WITHIN MAY NOT BE DUPLICATED OR DISCLOSED WITHOUT WRITTEN CONSENT OF M. FORD & ASSOCIATES, INC., HOUSTON, TEXAS



m. ford & associates  
interior design  
99 detersing street  
suite 165  
houston, tx 77007  
phone 713-630-0800  
fax 713-630-0814  
mford@mfordassociates.com  
www.mfordassociates.com

drawn by: Queen of the World

SHEET NO.

ID.7.0

MISC. ENLARGED PLANS

Good Page