



REVISED FOR CONSTRUCTION
MAY 16, 2012

KELLER SPRINGS CLUBHOUSE
ADDISON, TX


ENLARGED ELEVATIONS & SECTIONS @
GREAT ROOM & GAMES

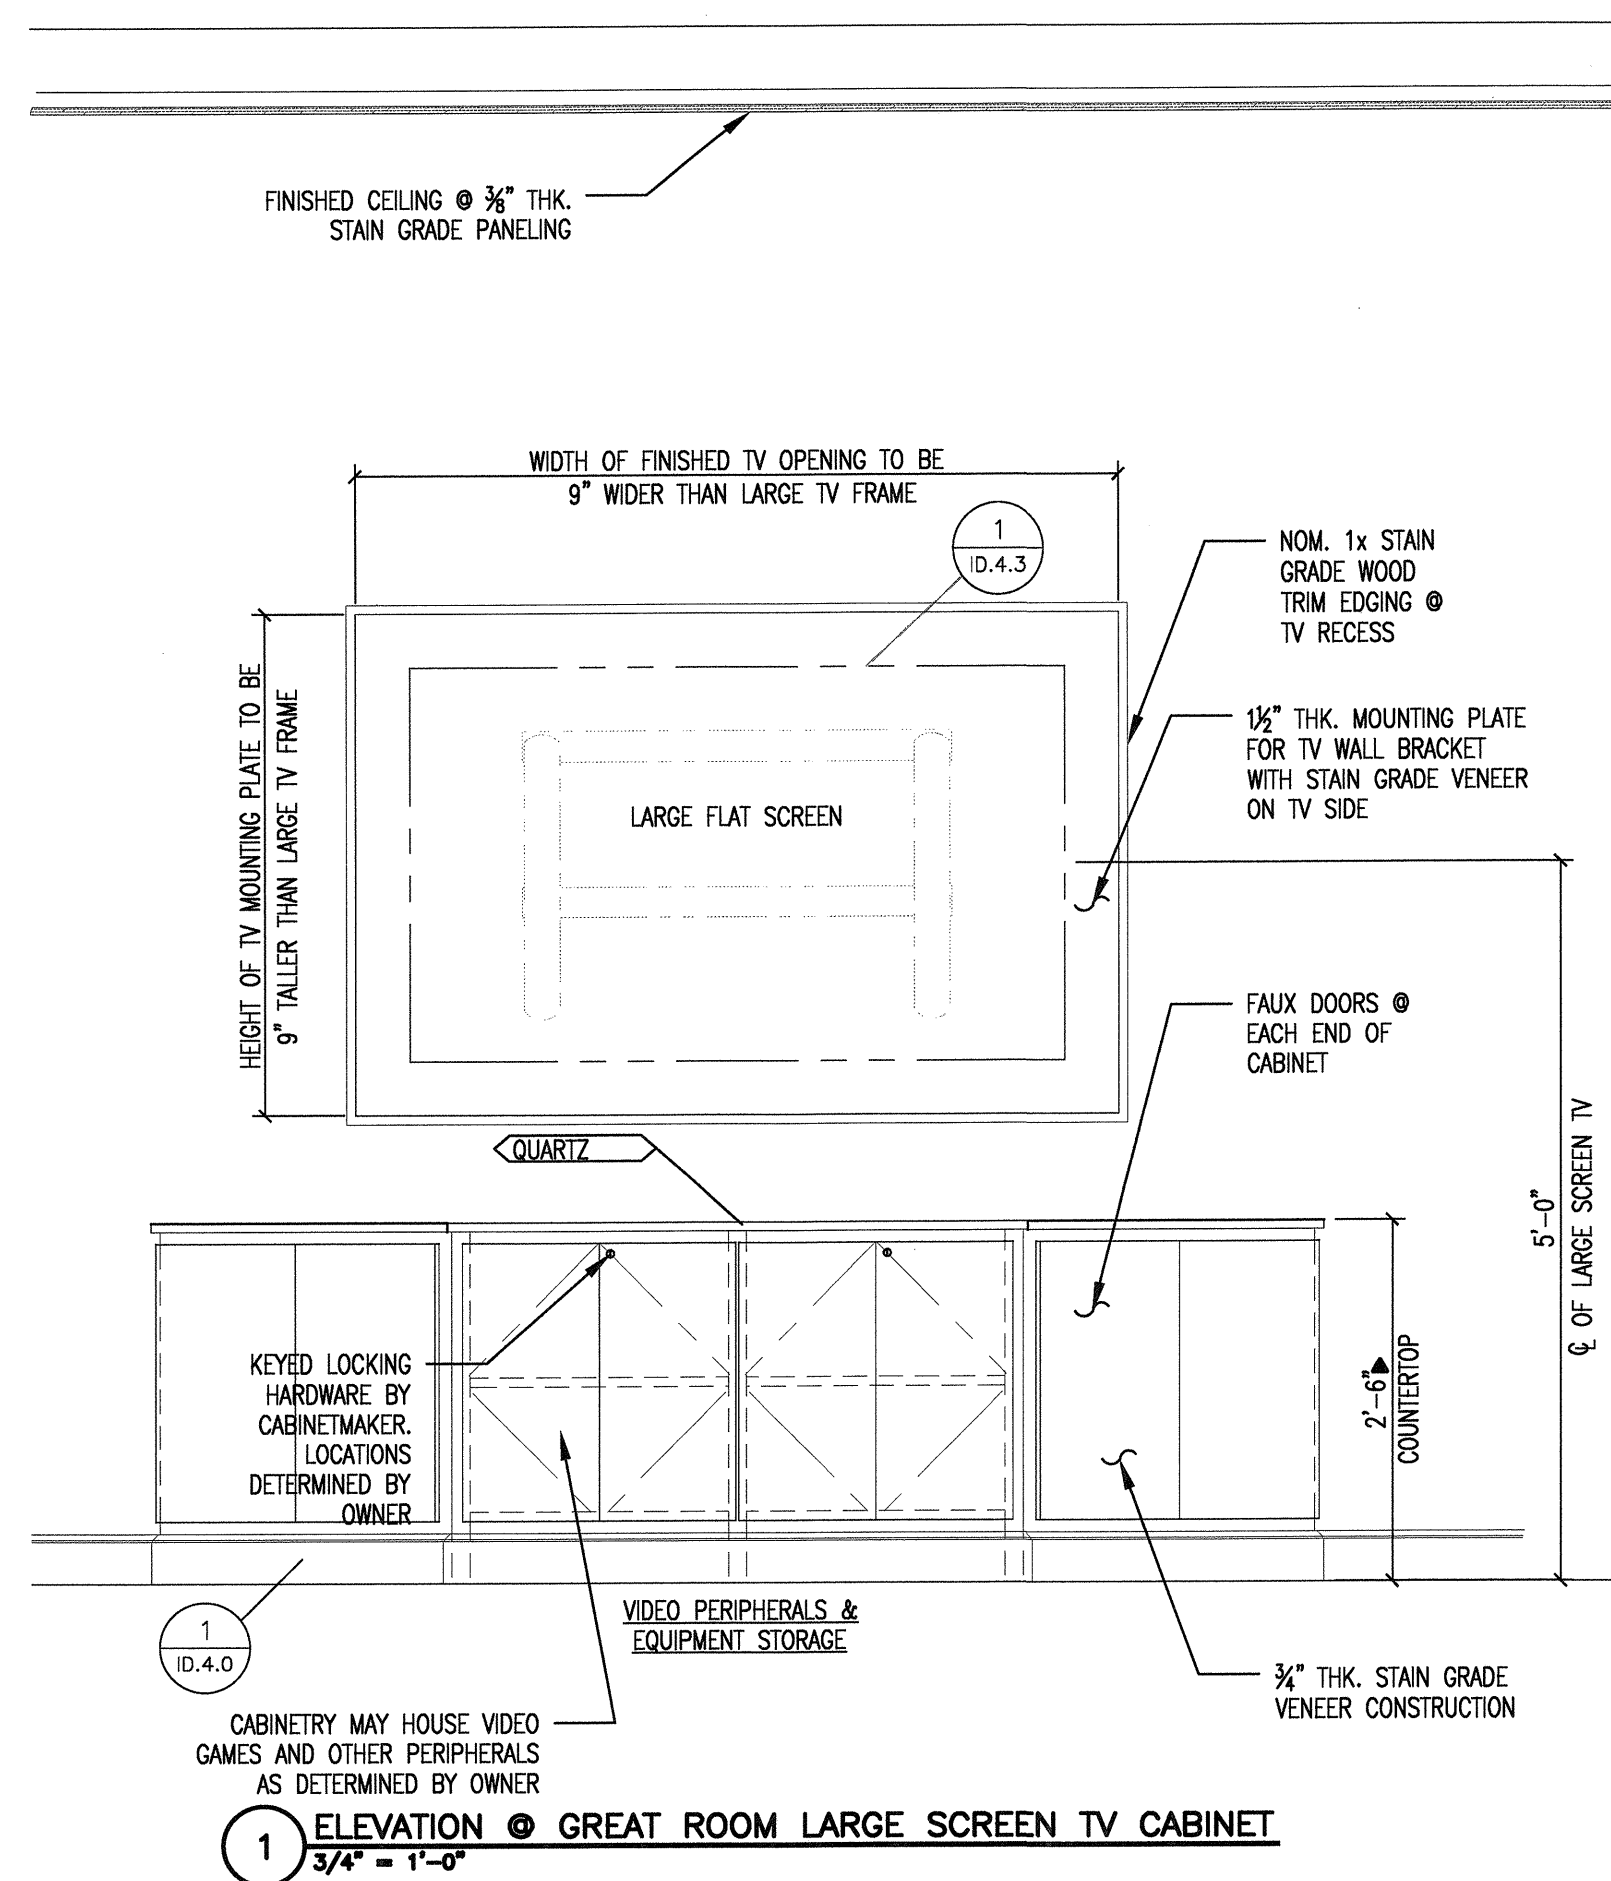


1 ELEVATION @ GREAT ROOM LARGE SCREEN TV CABINET
3/4\"/>

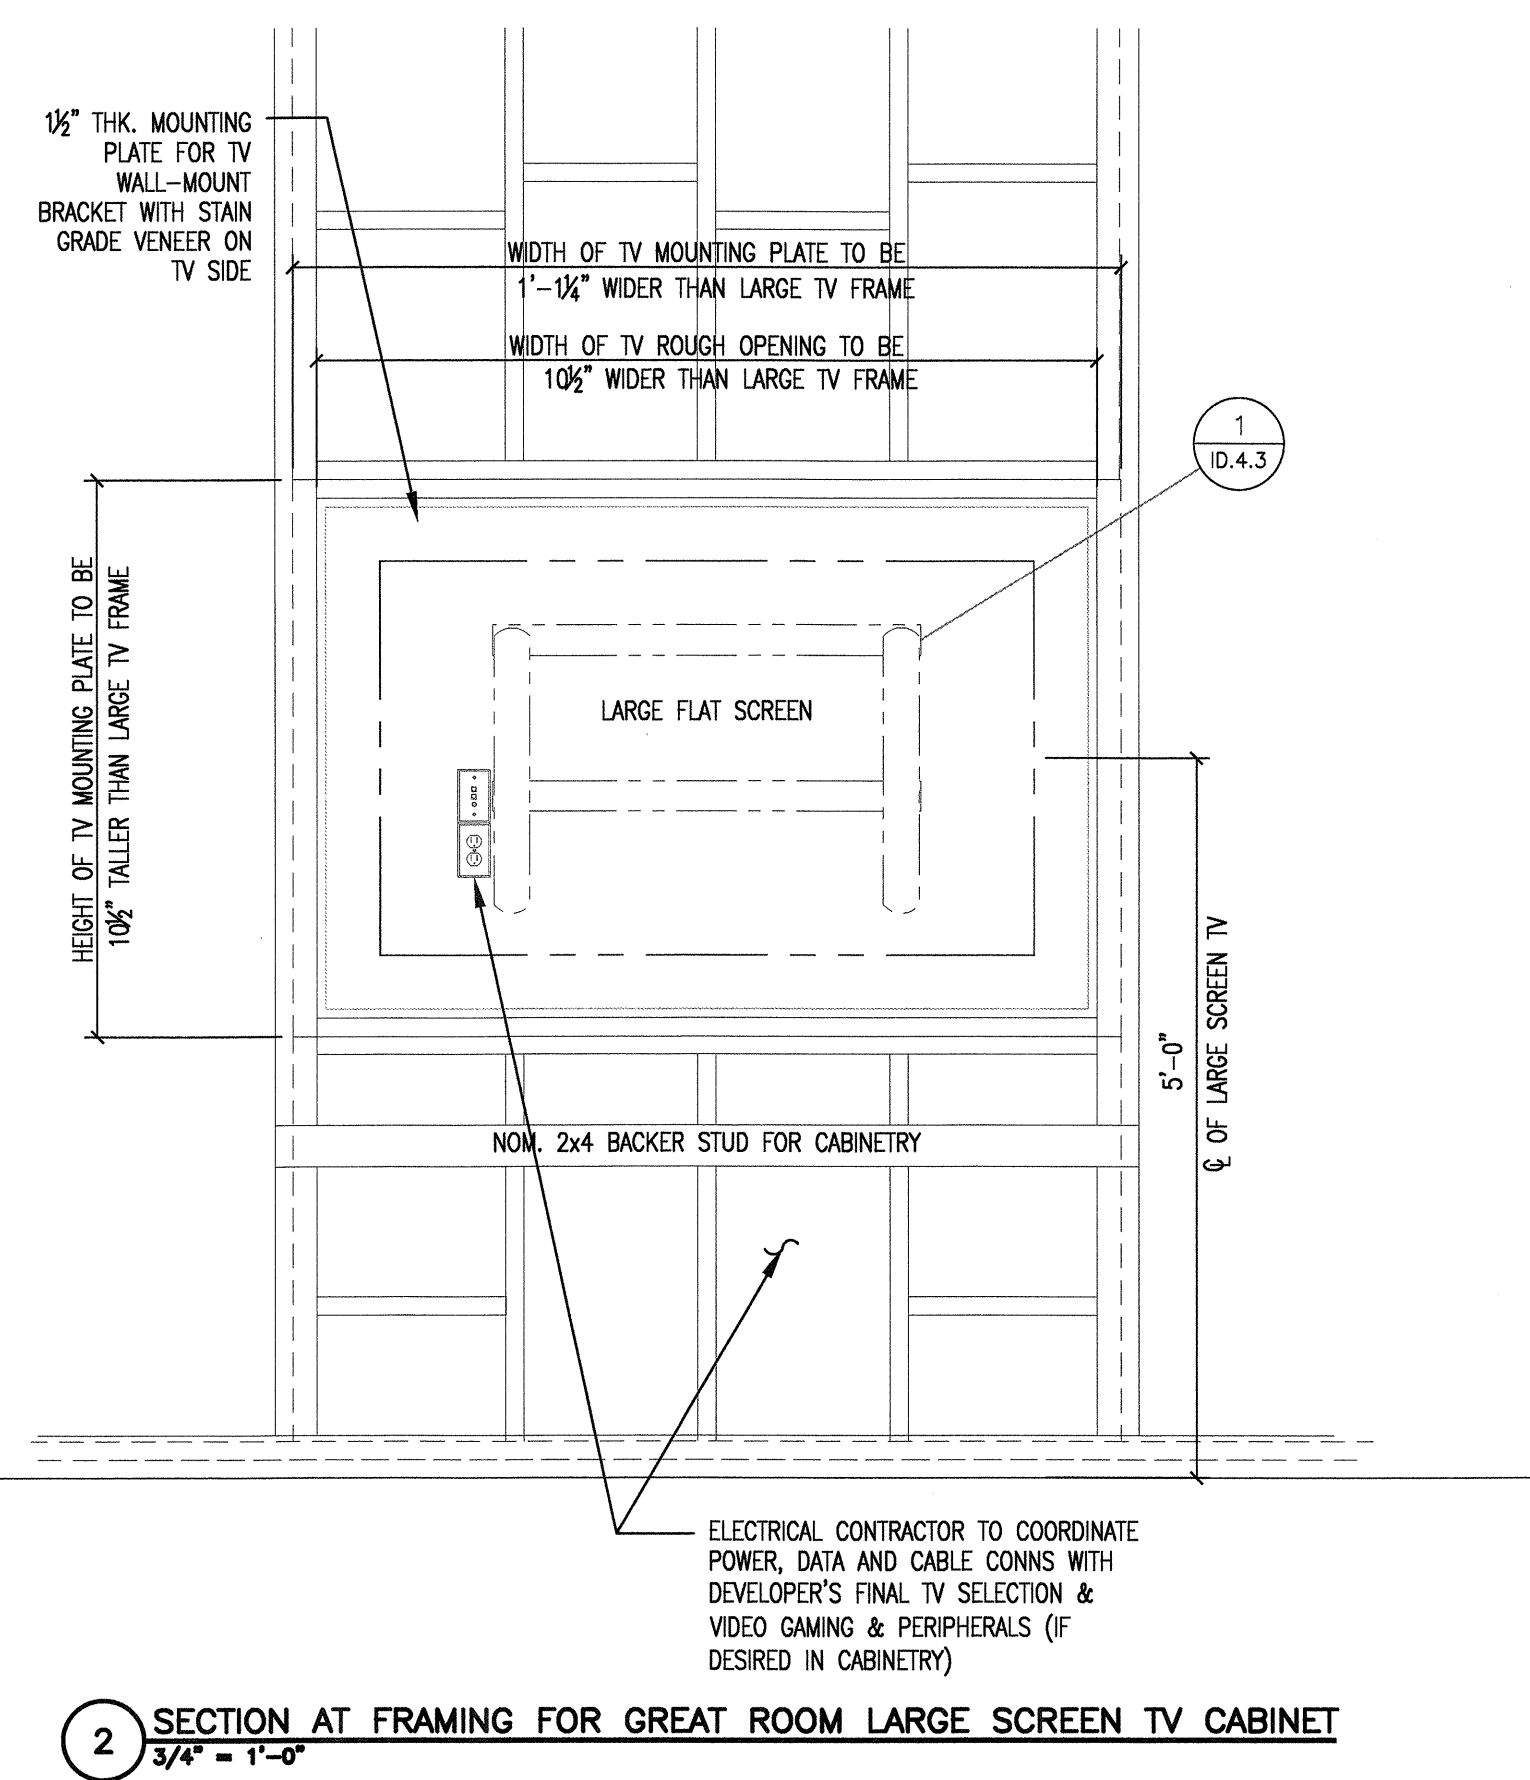

2 SECTION AT FRAMING FOR GREAT ROOM LARGE SCREEN TV CABINET
3/4\"/>

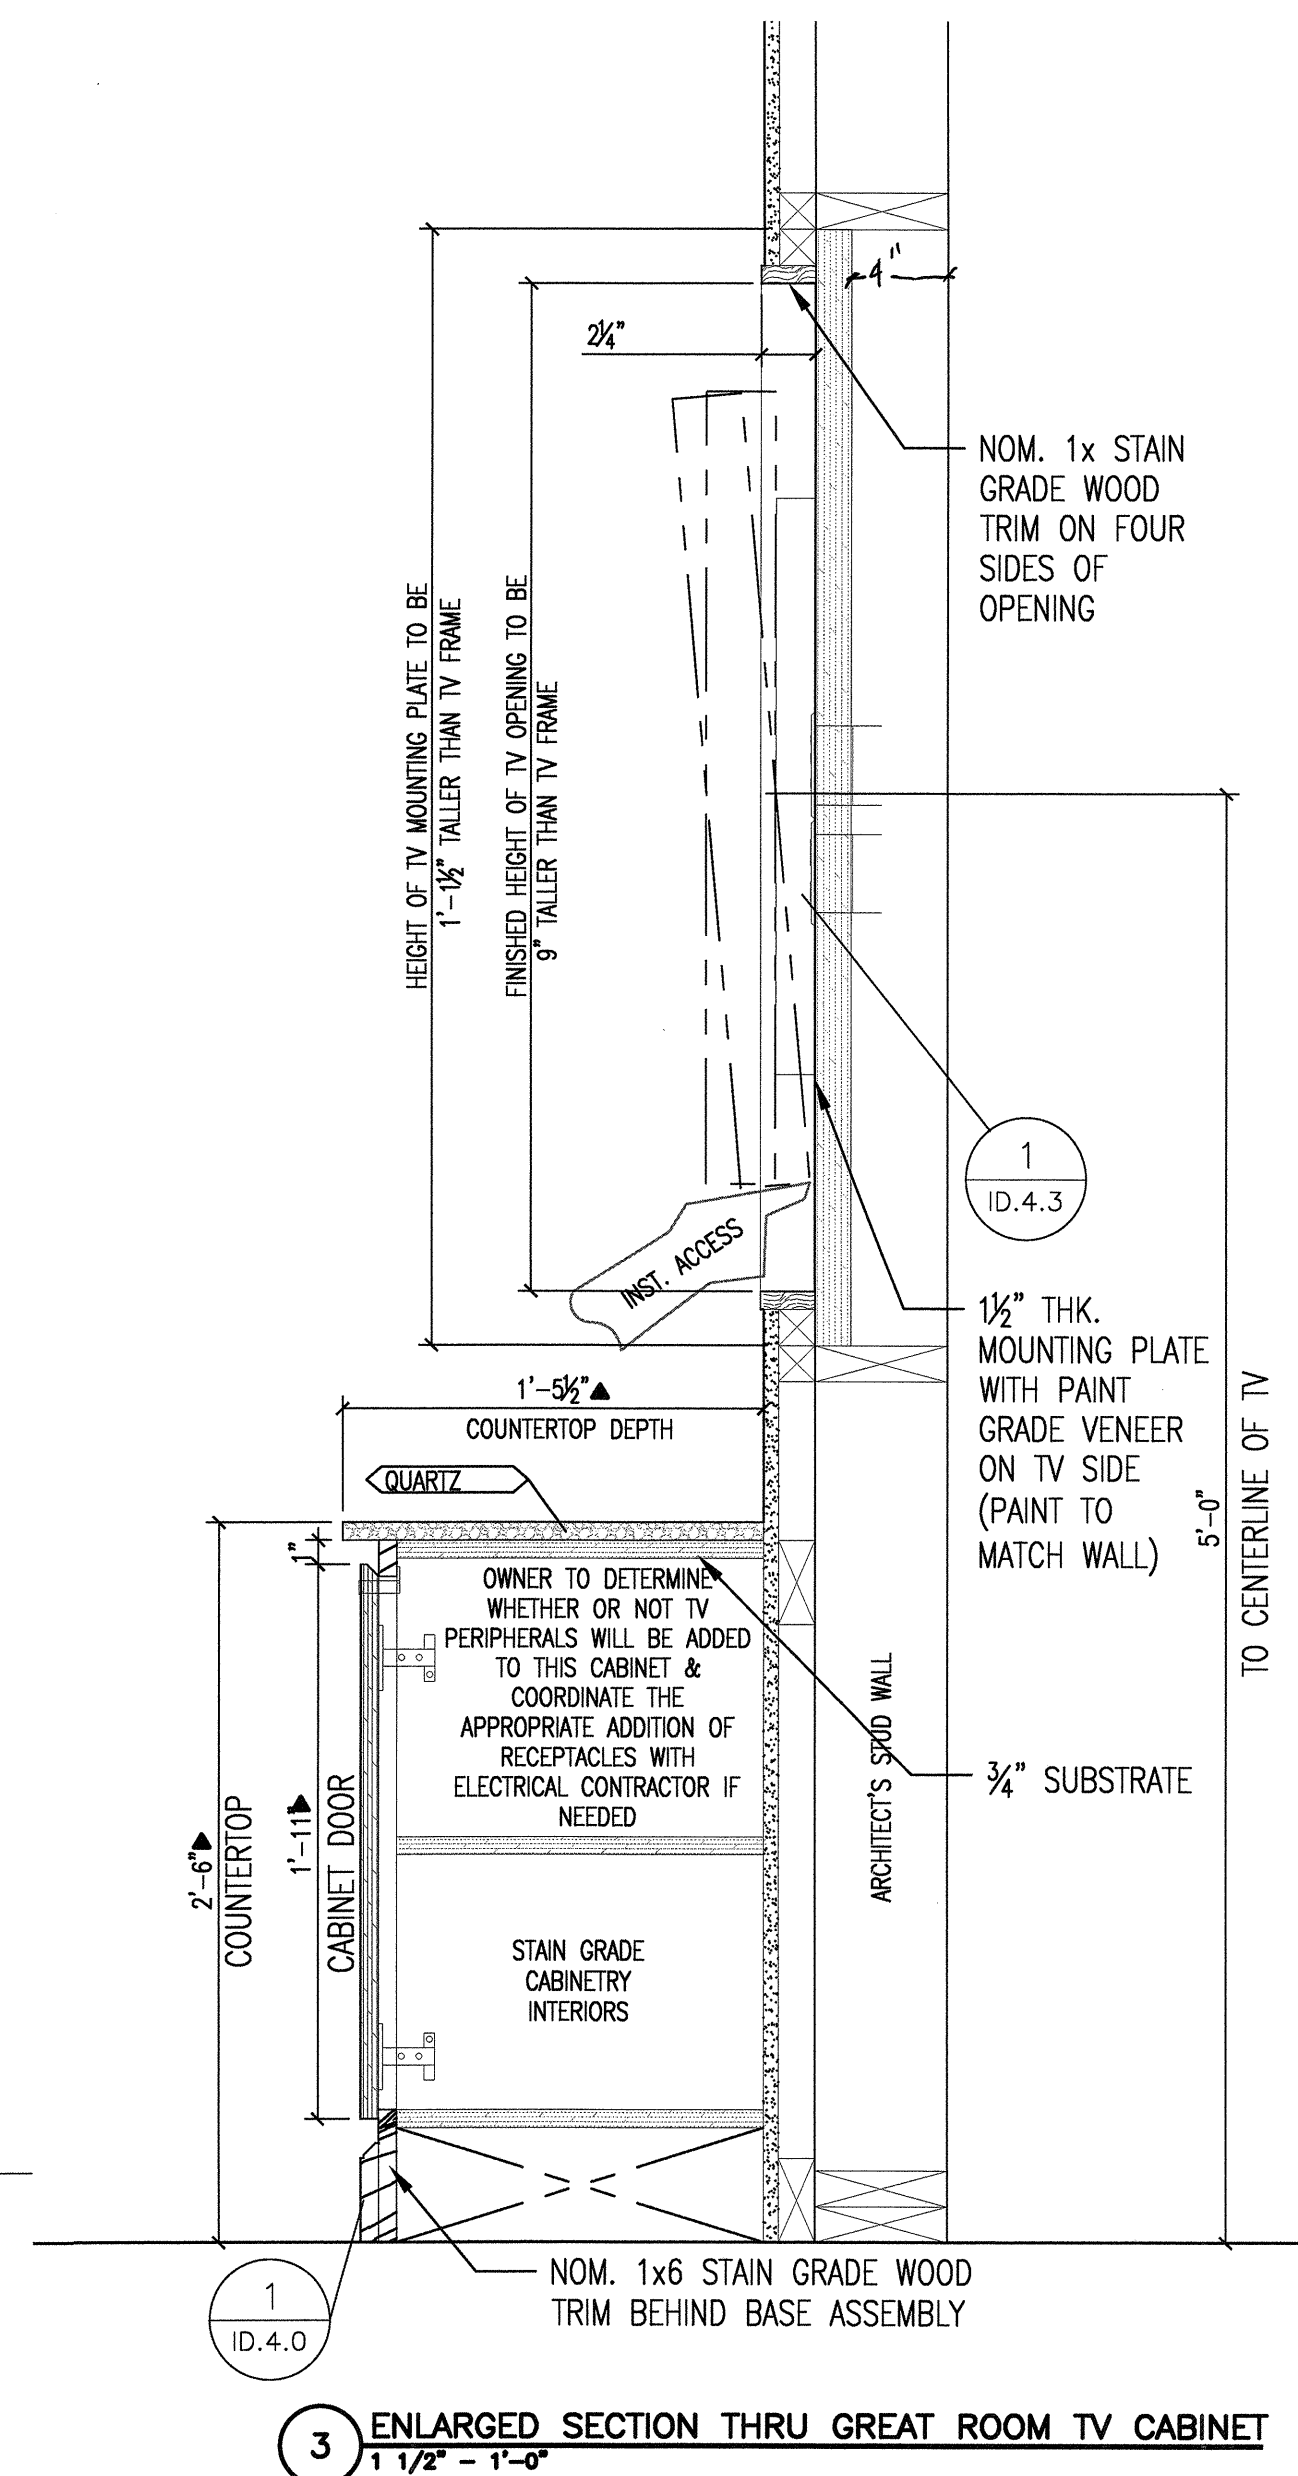

3 ENLARGED SECTION THRU GREAT ROOM TV CABINET
1 1/2\"/>

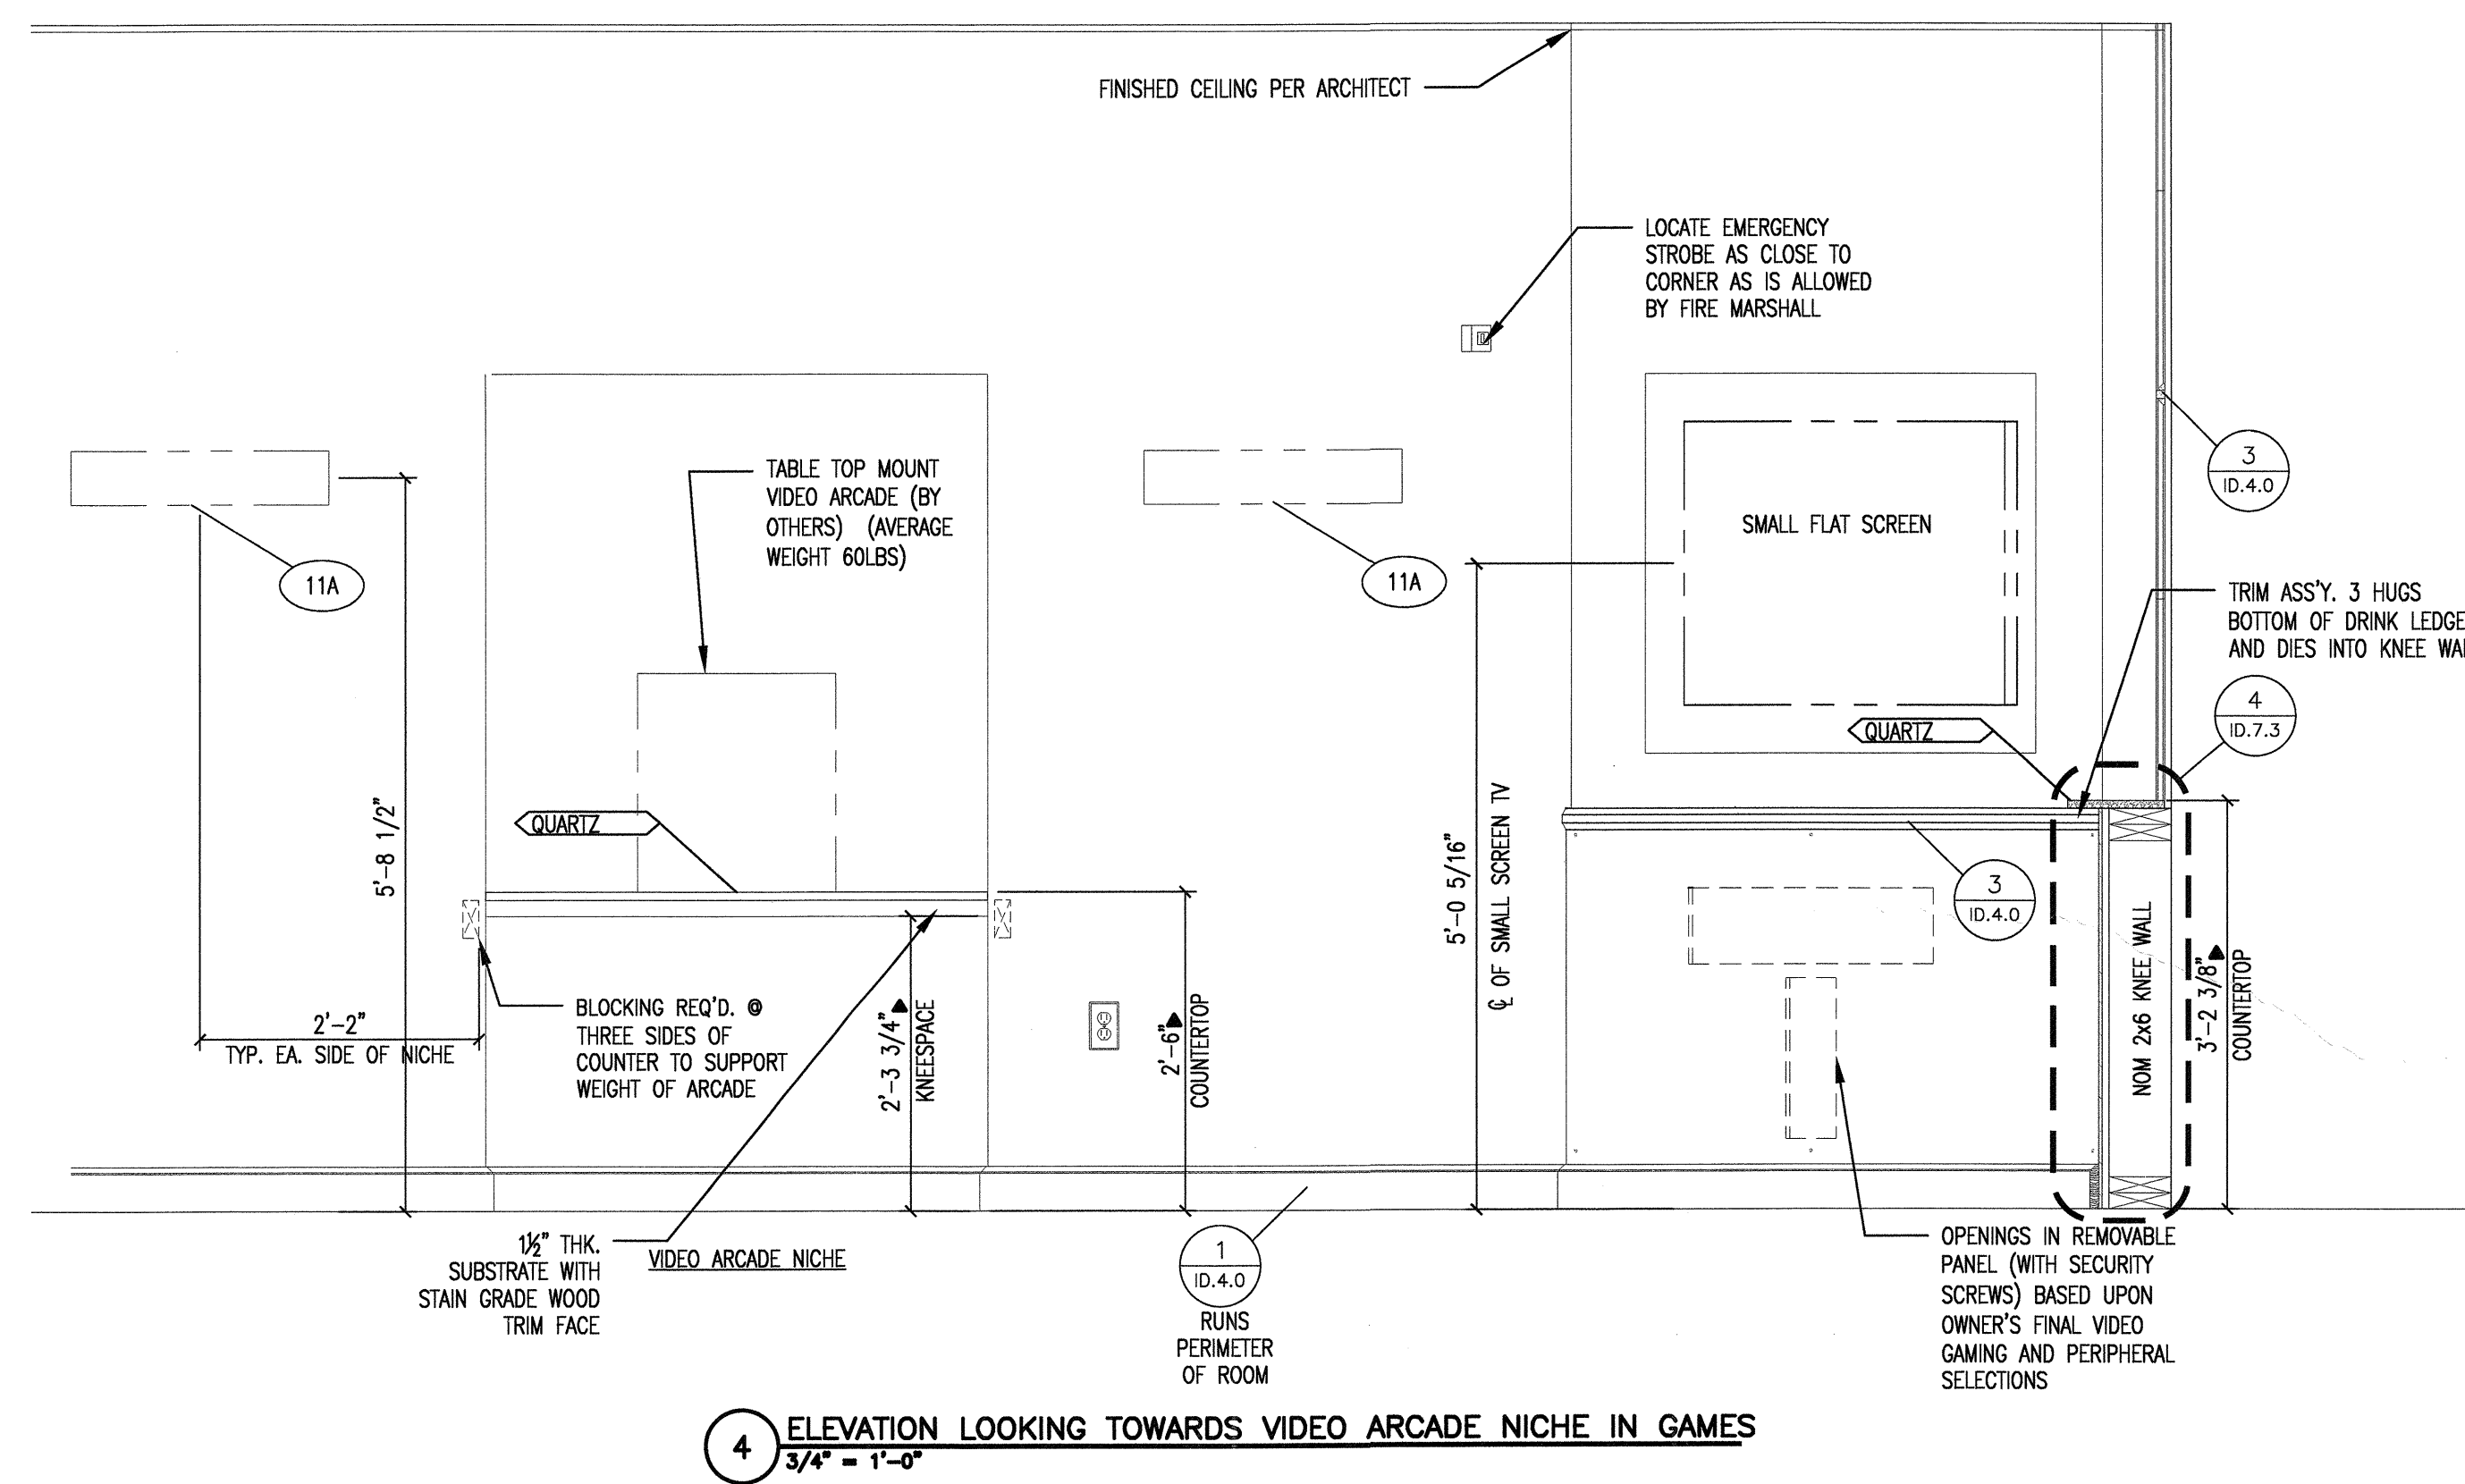

4 ELEVATION LOOKING TOWARDS VIDEO ARCADE NICHE IN GAMES
3/4\"/>

△ ADDED FABRICATION DETAILS 5-16-12

© 2012 M. FORD & ASSOCIATES, INC.
THIS DOCUMENT IS PUBLISHED AS AN INSTRUMENT OF SERVICE AND IS GIVEN IN CONFIDENCE. IT REMAINS THE PROPERTY OF M. FORD & ASSOCIATES, INC. THIS DOCUMENT, AND THE INFORMATION CONTAINED WITHIN, MAY NOT BE REPRODUCED OR DISCLOSED WITHOUT WRITTEN CONSENT OF M. FORD & ASSOCIATES, INC. HOUSTON, TEXAS



m. ford & associates
interior design
99 datering street
suite 165
houston, tx 77007
phone 713-630-0800
fax 713-630-0814
mford@mfordassociates.com
www.mfordassociates.com


SHEET NO.

ID.7.2