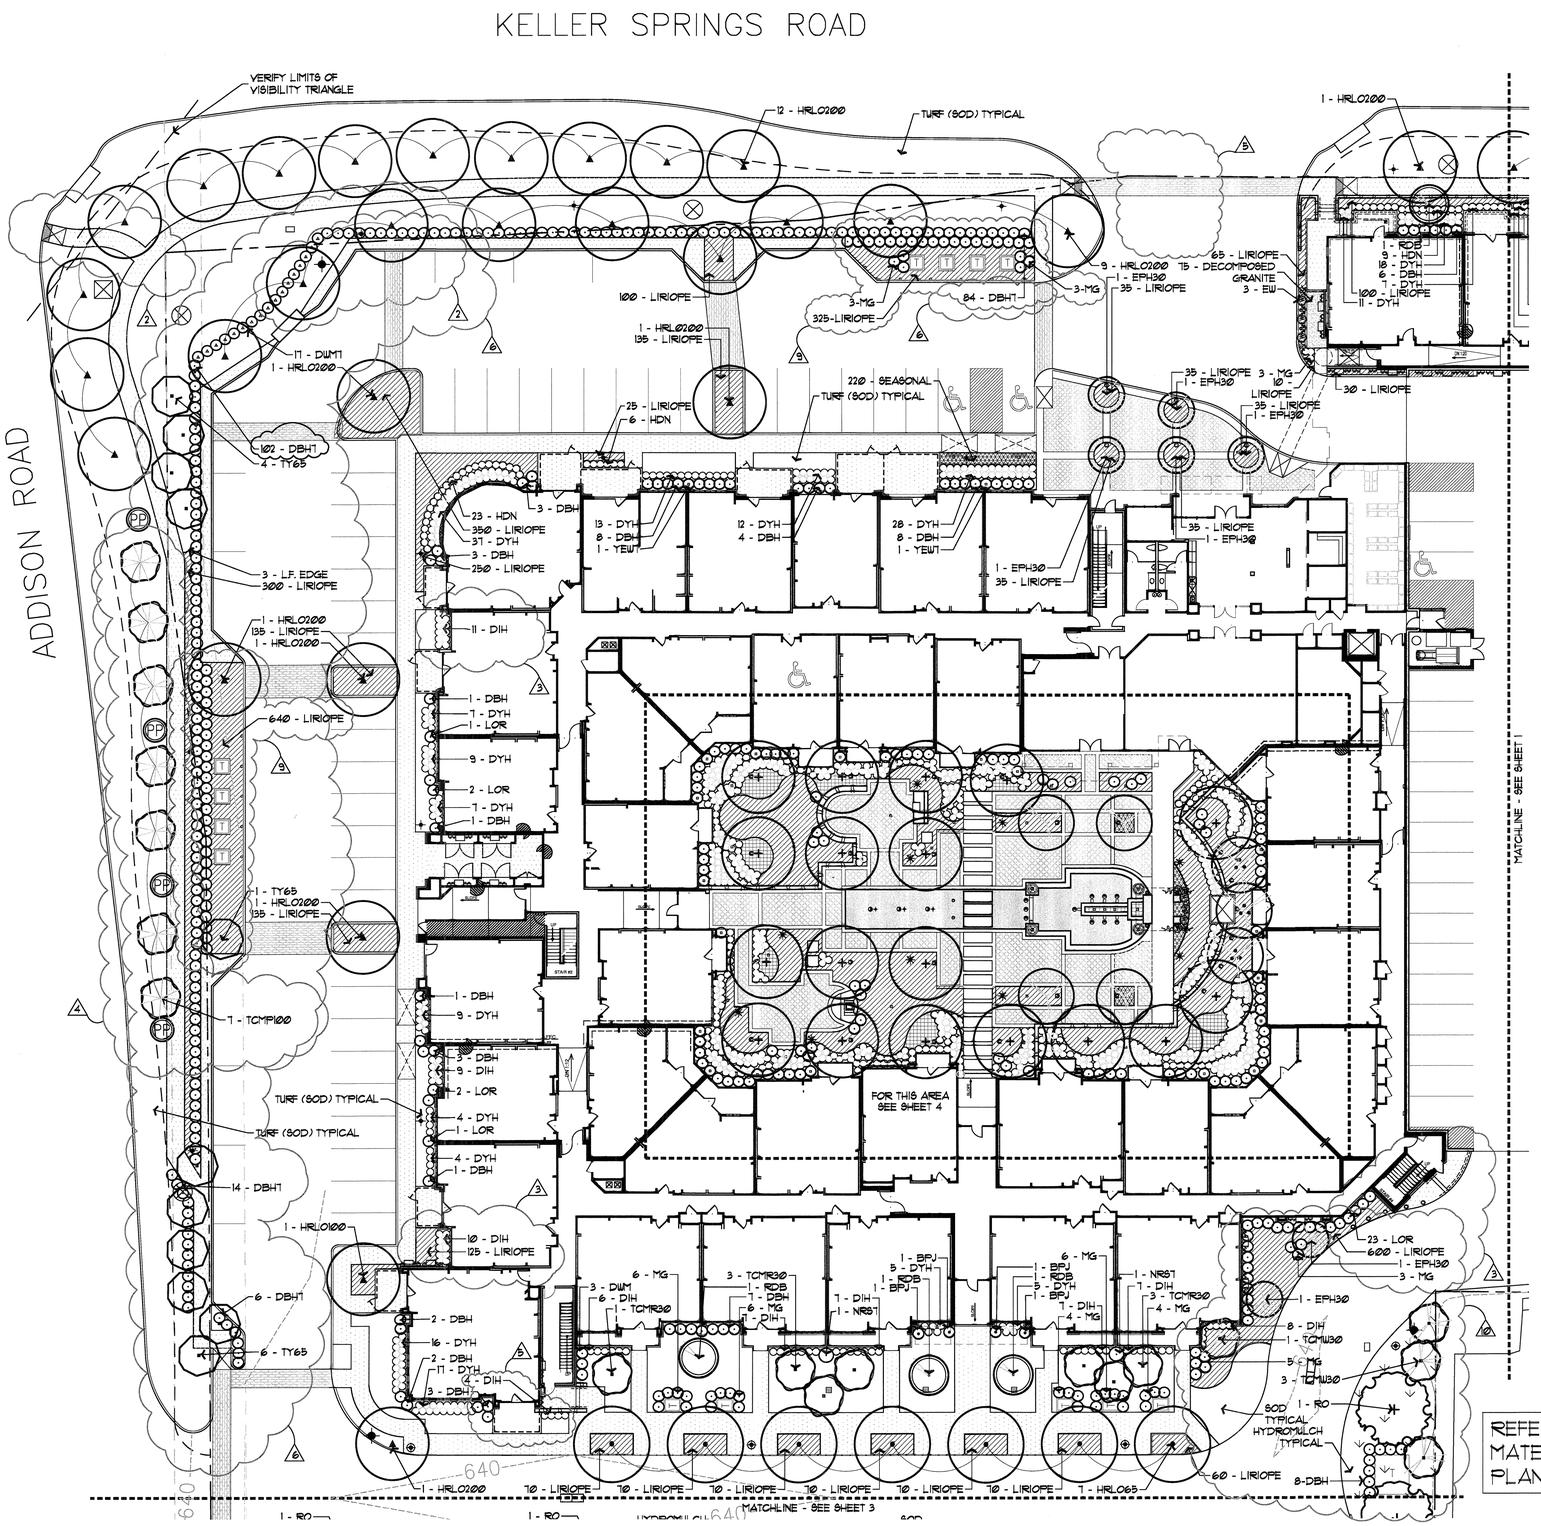

REFERENCE SHEET 3L FOR PLANT MATERIALS LIST AND SHEET 6L FOR PLANTING SPECIFICATIONS.

File Name: Keller Springs planting.dwg
Plot Date: 06/11/2013 – 03:21pm

ENVIRO DESIGN
LANDSCAPE ARCHITECTURE
SITE PLANNING
7424 Greenville Ave. Suite 200 Dallas, TX 75231 (214) 987-3010

REGISTERED LANDSCAPE ARCHITECT
RICHARD B. ARTHUR
1776
STATE OF TEXAS

THIS ELECTRONIC DRAWING FILE IS RELEASED UNDER THE AUTHORITY OF RICHARD B. ARTHUR, REGISTERED LANDSCAPE ARCHITECT, STATE OF TEXAS. MAINTAINED THE SEAL, THE ARCHITECT'S ELECTRONIC DRAWING FILE MAY BE VIEWED AS A REFERENCE DRAWING FOR INFORMATION ONLY. THE ARCHITECT'S ELECTRONIC DRAWING FILE MAY NOT BE USED AS A TO ISSUE BUILDING AND RESTRICTIONS OF THE ARCHITECT'S SEAL OF ARCHITECTURAL CONTRACTORS, THE USER OF THIS DRAWING FILE ASSUMES ALL RISK AND LIABILITY AND ALL RESPONSIBILITY FOR ANY ADDITIONS TO OR USE OF THIS DRAWING FILE THAT IS INCONSISTENT WITH THE ORIGINAL DRAWING. THE USER MUST ADHERE TO REGULATIONS OF THE TEXAS BOARD OF ARCHITECTURAL EXAMINERS. NO PERSON MAY ALTER THIS DRAWING FILE IN ANY WAY. THE ORIGINAL DRAWING FILE WITHOUT THE LANDSCAPE ARCHITECT'S EXPRESS WRITTEN PERMISSION.

REVISIONS

2 03 OCT 11
ADDED SIDEWALK TO STREET AND ADJUSTED SHRUBS TO GO ON BACK SIDE OF FIRE HYDRANT.

3 17 OCT 11
REVISED PLANTING DUE TO BUILDING REVISIONS

4 31 OCT 11
REVISED TREE SPECIES ALONG ADDISON ROAD PER CITY CONCERNS WITH OVER-HEAD POWER LINES

5 02 FEB 12
REVISED PLANTING

6 26 APR 12
REVISED PLANTING DUE TO PARKING/SIDEWALK REVISIONS

9 21 FEB 13
CHANGED PAVED TRANSFORMER AREAS TO BE LANDSCAPED

10 11 JUNE 13
REVISED PLANTING AT SOUTHEAST CORNER OF BUILDING

Keller Springs Lofts

EMBREY PARTNERS, LTD
ADDISON, TEXAS

SCALE
1" = 20'-0'

DATE
19 AUG 2011

TITLE
LANDSCAPE

SHEET
2L OF 6