


KELLER SPRINGS ROAD

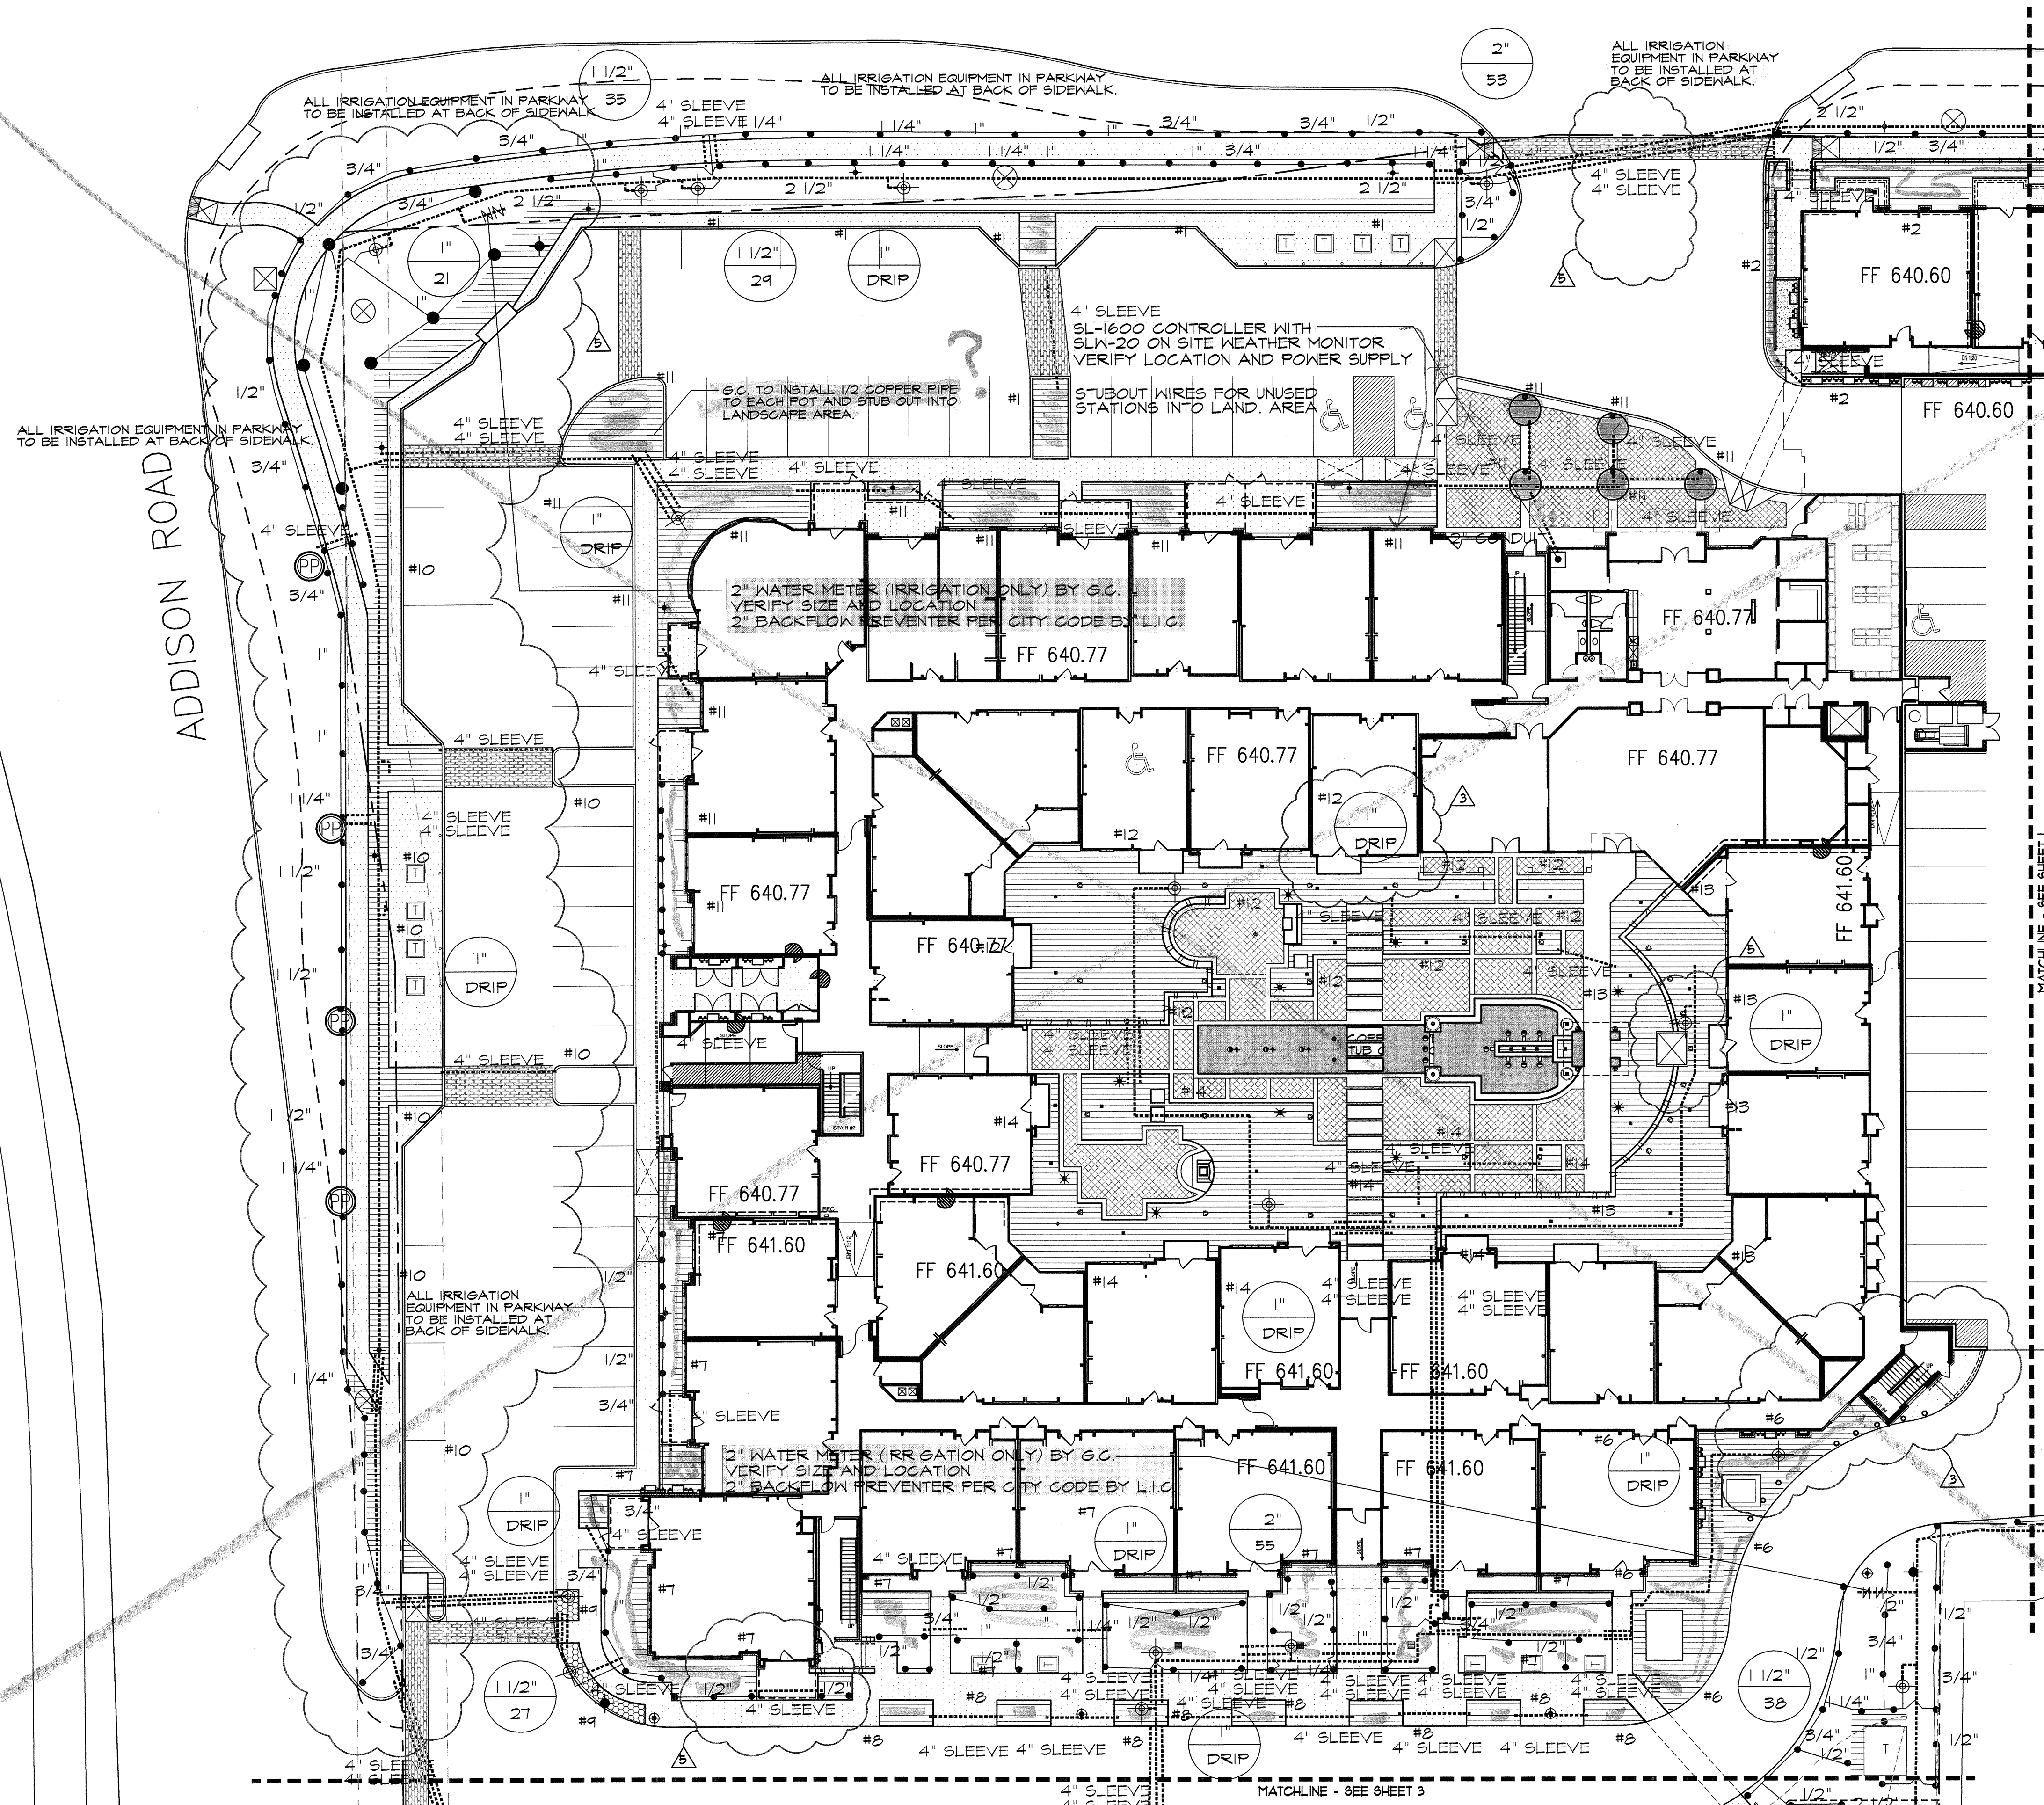

File Name: Keller Springs Irrigation.dwg
 Plot Date: 04/26/2012 - 04:27pm

REFERENCE SHEET 38 FOR IRRIGATION NOTES AND LEGEND
 REFERENCE SHEET 45 FOR IRRIGATION SPECS AND DETAILS

REVISIONS

11 OCT 11	REVISED IRRIGATION DUE TO BUILDING REVISIONS
02 FEB 12	REVISED IRRIGATION DUE TO PARKING ADDITION, RELOCATION OF VAULT IN FRONTAN COURTYARD AND REMOVAL OF MEDIAN AT ENTRY DRIVE OFF OF KELLER SPRINGS ROAD
26 APR 12	REVISED IRRIGATION DUE TO PARKING/SIDEWALK REVISIONS

Keller Springs Lofts
 EMBREY PARTNERS, LTD
 ADDISON, TEXAS

SCALE	1" = 20'-0"
DATE	19 AUG 2011
TITLE	IRRIGATION
SHEET	25 OF 4

