


ACCESSORIES						
KEY	TYPE	STYLE	MODEL	MANUF	COLOR	QUAN
①	BENCH	PERFORATED	B&WPERF3M	WEBCOAT	BY OWNER	1
②	TRASH RECEPTACLE	PERFORATED	TR32AVEPERF W/FLATTOP 32	WEBCOAT	BY OWNER	1
③	DOG BAG DISPENSER	N/A	SELECTED BY OWNER	N/A	N/A	1
④	GALLERY PLANTER		GP-30A	PLANTCONTAINERS.COM	WEATHERED GRAY	8
⑤	GALLERY PLANTER		GP-40A	PLANTCONTAINERS.COM	WEATHERED GRAY	14
⑥	GAS GRILL	BGB SERIES	BGB3-BQ	DCS	STAINLESS	3

MFG. - WEBCOAT
 WWW.WEBCOAT.COM
 (800) 503-9101

MFG. - PLANTCONTAINERS.COM
 WWW.PLANTCONTAINERS.COM
 (866) 342-3330

MFG. - DCS
 WWW.DCSAPPLIANCES.COM
 (800) 433-8466

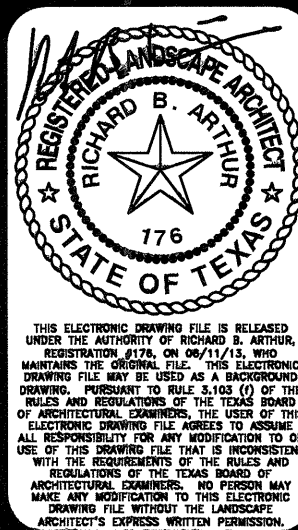

REVISIONS

02 FEB 2012
 GRADE REVISIONS DUE TO CIVIL COORDINATION

11 JUNE 2013
 PARKING ADDITION, DOG PARK RELIGATION, PARAPET/RETAINING WALL ADDITION

SCALE

1" = 20'-0"

DATE

19 AUG 2011

TITLE

CONSTRUCTION

SHEET

3C OF 9

