
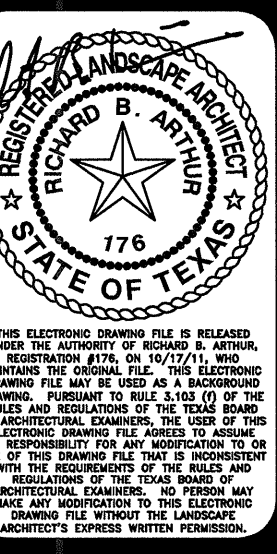


File Name: Keller Springs planting.dwg
 Plot Date: 01/10/2012 - 09:37am

REFERENCE SHEET 3L FOR PLANT MATERIALS LIST AND SHEET 6L FOR PLANTING SPECIFICATIONS.

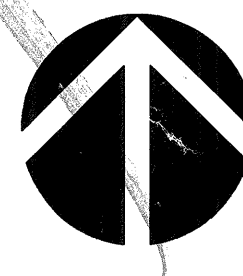

REVISIONS
 IT OCT 11
 REVISED PLANTING DUE TO BUILDING REVISIONS

SCALE
 1/8" = 1'-0"

DATE
 19 AUG 2011

TITLE
 LANDSCAPE

SHEET
 4L OF 6