



File Name: Keller Springs planting.dwg  
 Plot Date: 02/02/2012 03:10pm

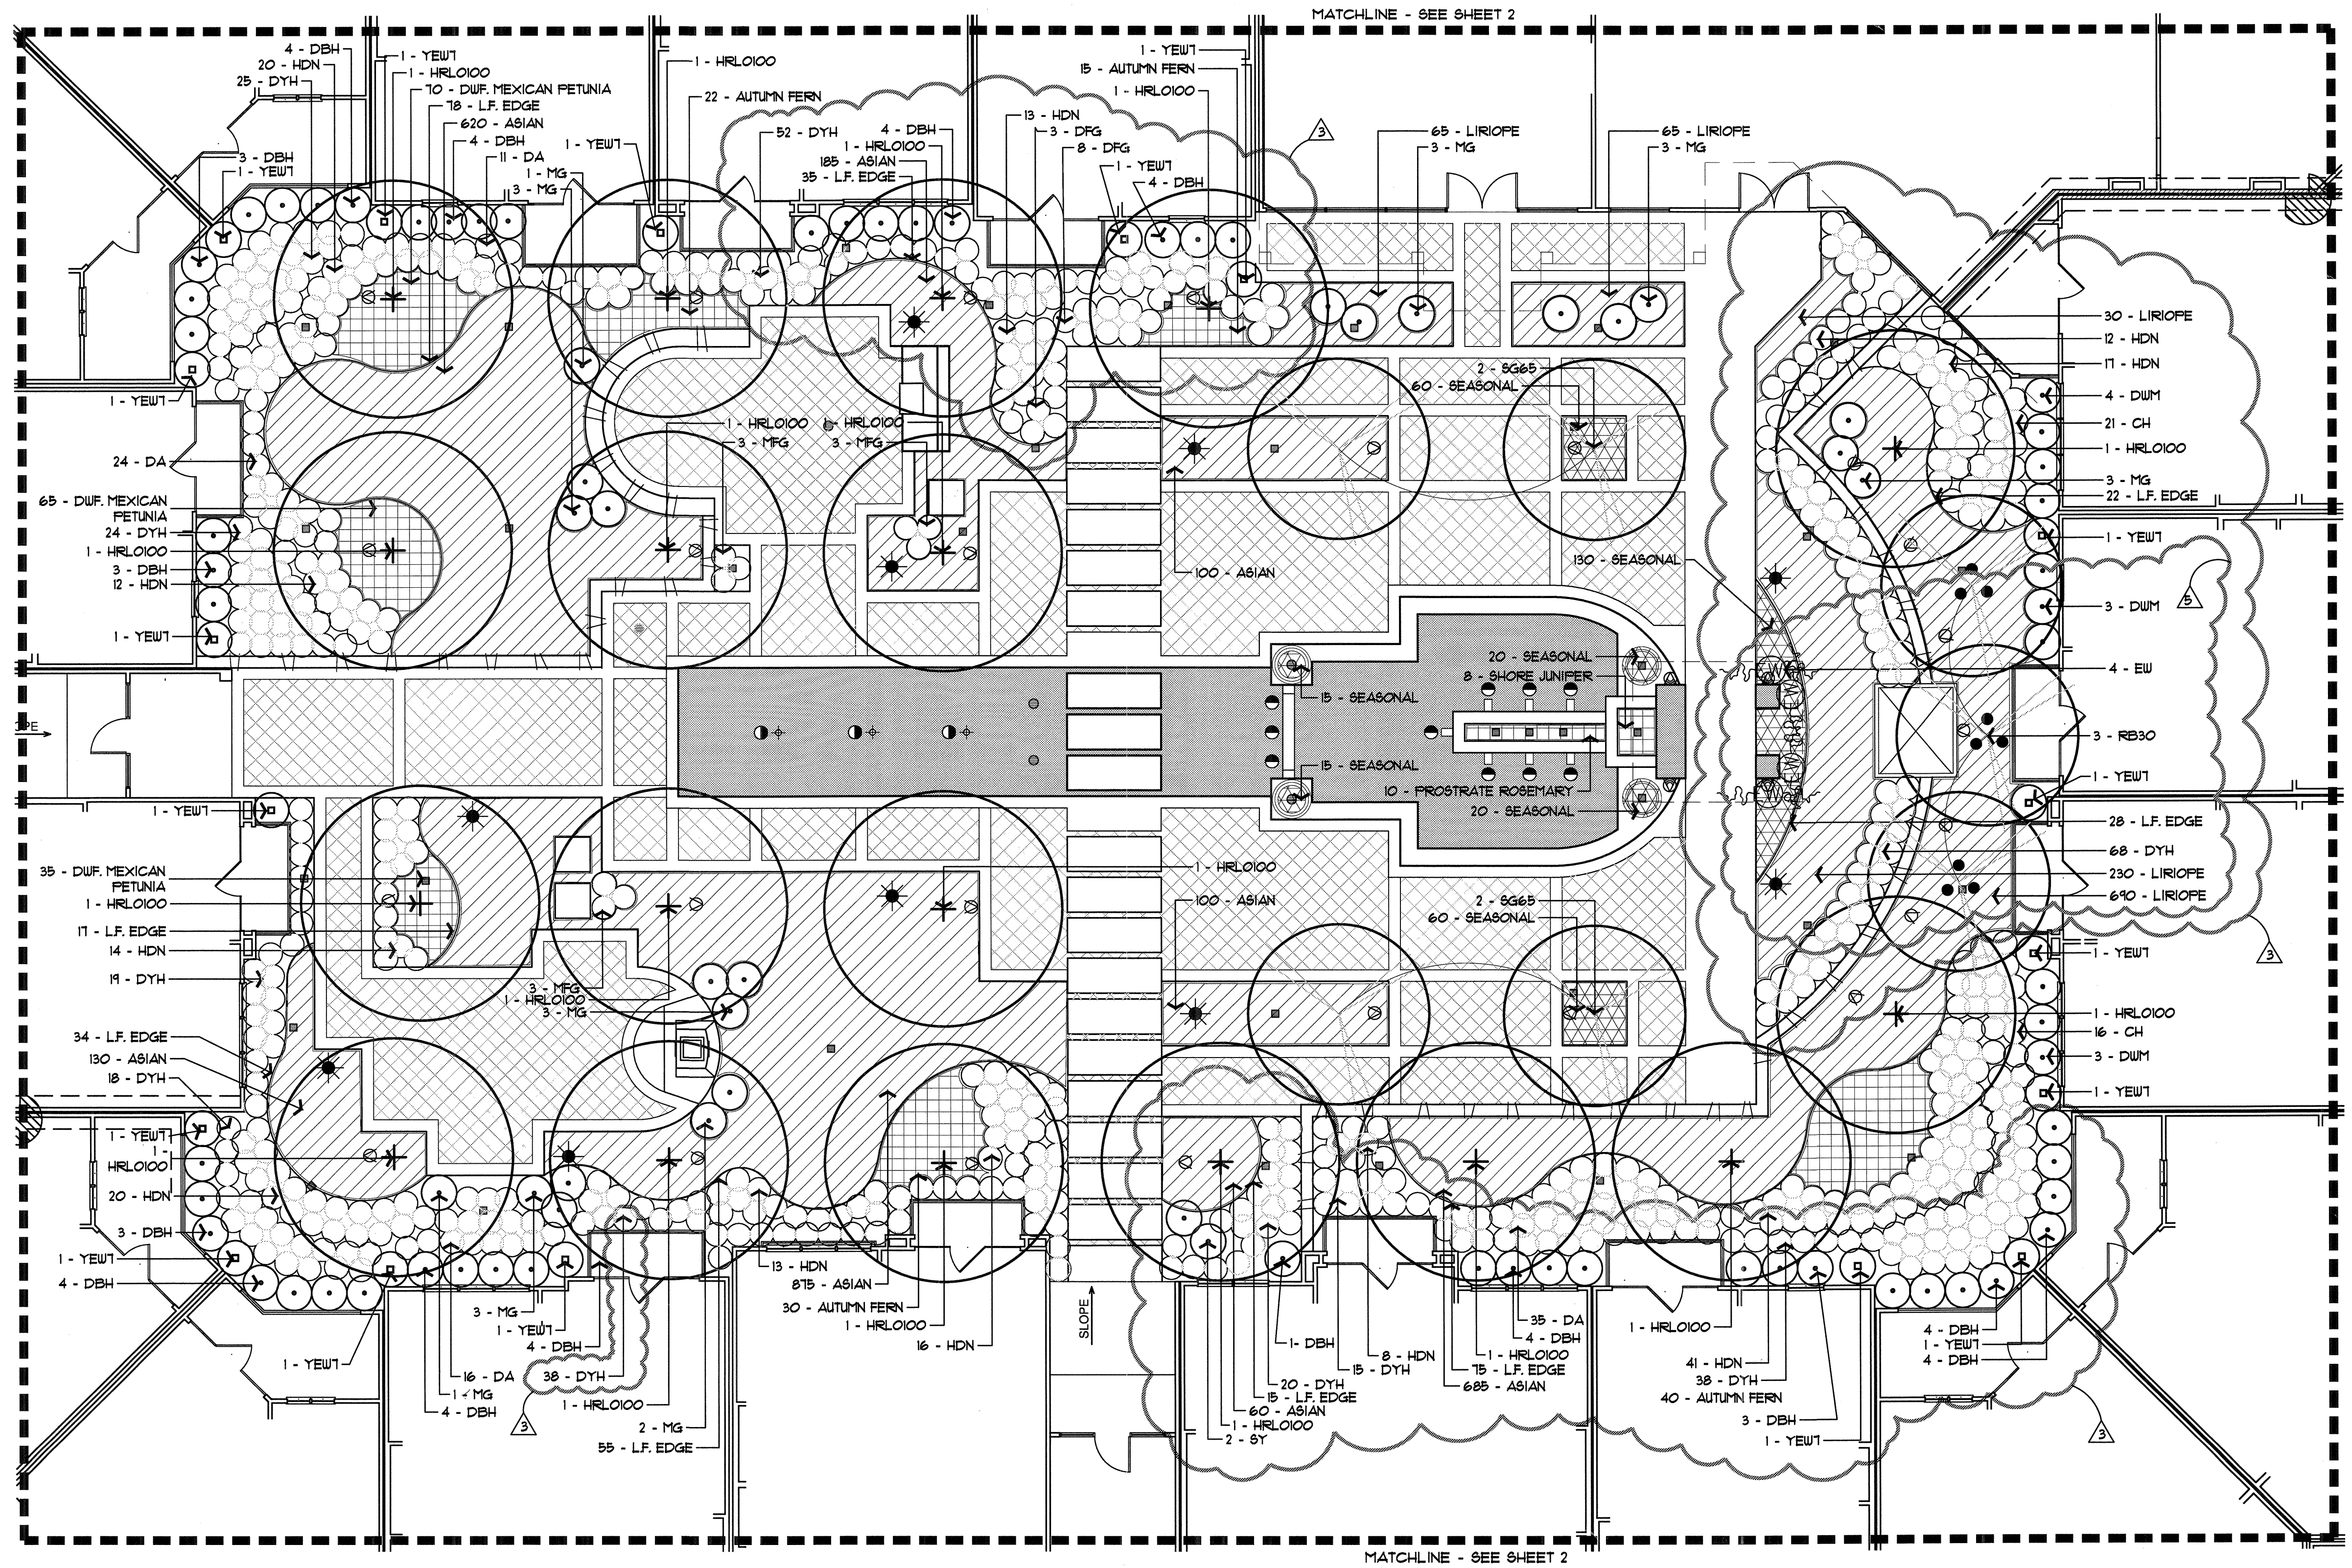

REFERENCE SHEET 3L FOR PLANT MATERIALS LIST AND SHEET 6L FOR PLANTING SPECIFICATIONS.

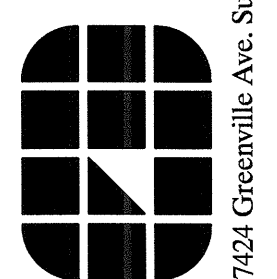

7424 Greenville Ave., Suite 200 Dallas, TX 75231 (214) 987-3010



THIS DOCUMENT IS THE PROPERTY OF ENVIRO DESIGN LANDSCAPE ARCHITECTURE. IT IS TO BE USED ONLY FOR THE PROJECT AND SITE SPECIFICALLY IDENTIFIED HEREON. IT IS NOT TO BE REPRODUCED, COPIED, OR TRANSMITTED IN ANY FORM OR BY ANY MEANS, ELECTRONIC OR MECHANICAL, INCLUDING PHOTOCOPYING, RECORDING, OR BY ANY INFORMATION STORAGE AND RETRIEVAL SYSTEM, WITHOUT THE WRITTEN PERMISSION OF ENVIRO DESIGN LANDSCAPE ARCHITECTURE.

REVISIONS

- 11 OCT 11 REVISED PLANTING DUE TO BUILDING REVISION
- 02 FEB 12 REVISED PLANTING DUE TO RELOCATION OF VAULT

Keller Springs Lofts  
 EMBREY PARTNERS, LTD  
 ADDISON, TEXAS

SCALE

1/8" = 1'-0"

DATE

19 AUG 2011

TITLE

LANDSCAPE

SHEET

4L OF 6

