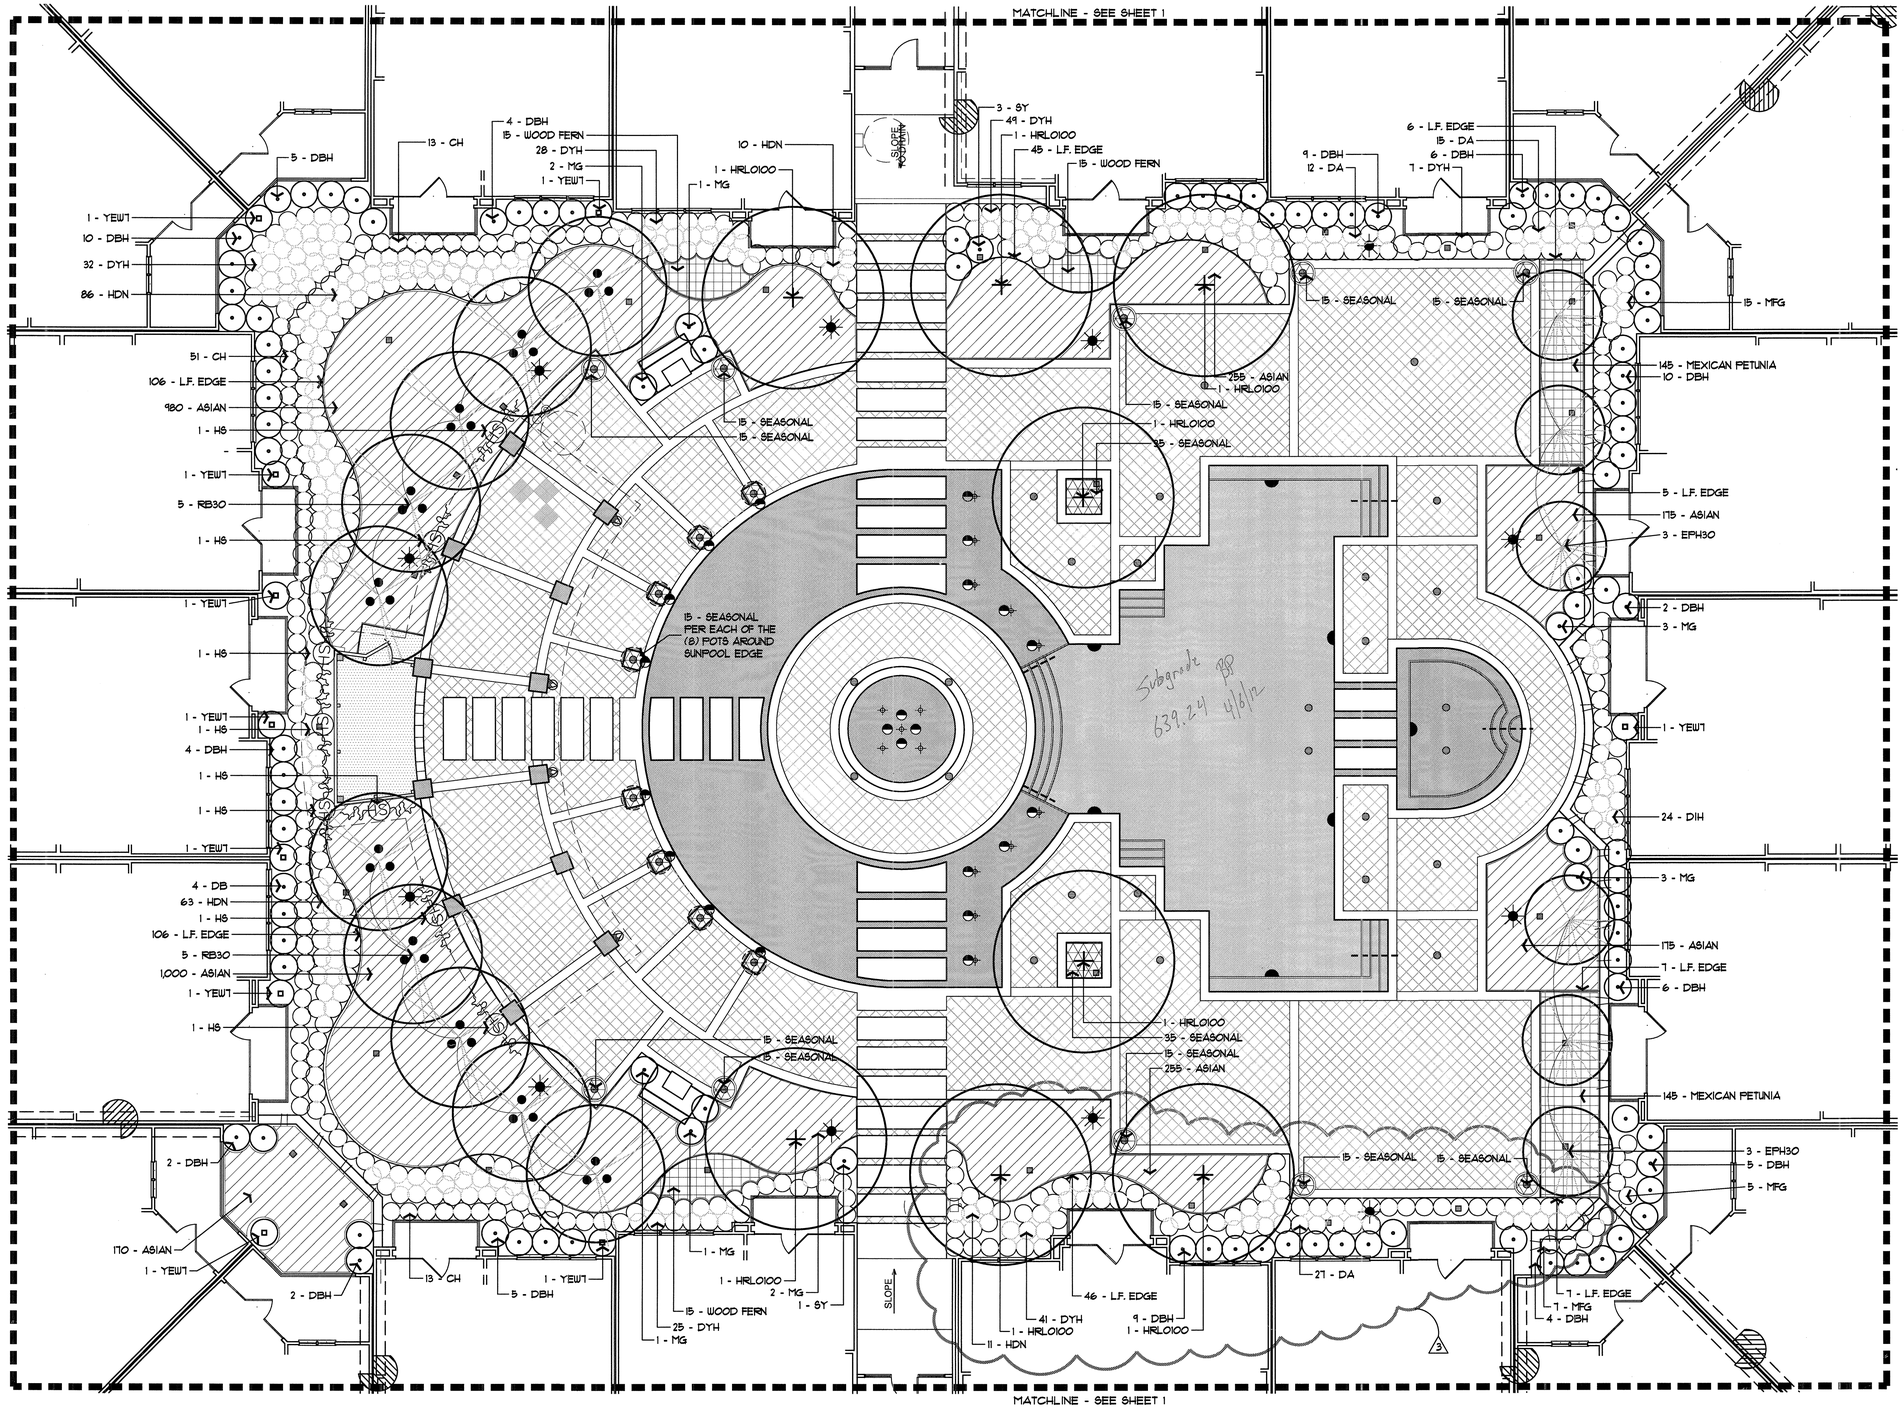

REFERENCE SHEET 3L FOR PLANT MATERIALS LIST AND SHEET 6L FOR PLANTING SPECIFICATIONS.

File Name: Keller Springs planting.dwg
Plot Date: 10/25/2011 – 10:43am

ENVIRO DESIGN
LANDSCAPE ARCHITECTURE
SITE PLANNING
7424 Greenville Ave. Suite 200 Dallas, TX 75231 (214) 987-3010

REGISTERED LANDSCAPE ARCHITECT
RICHARD B. ARTHUR
176
STATE OF TEXAS

THIS ELECTRONIC DRAWING FILE IS RELEASED UNDER THE AUTHORITY OF RICHARD B. ARTHUR, REGISTERED LANDSCAPE ARCHITECT, STATE OF TEXAS, MEMBER THE AMERICAN SOCIETY OF LANDSCAPE ARCHITECTS. THIS ELECTRONIC DRAWING FILE MAY BE USED AS A WORKING DOCUMENT ONLY WHEN IT IS IN COMPLIANCE WITH THE RULES AND REGULATIONS OF THE TEXAS BOARD OF LANDSCAPE ARCHITECTURE. THIS FILE MAY NOT BE REPRODUCED OR TRANSFERRED TO ANY OTHER PARTY. ALL RESPONSIBILITY FOR ANY MODIFICATION TO OR REPRODUCTION OF THIS DRAWING FILE MUST BE WITH THE REQUIREMENTS OF THE RULES AND REGULATIONS OF THE TEXAS BOARD OF LANDSCAPE ARCHITECTURE. USE OF THIS FILE WITHOUT WRITTEN ARCHITECT'S CONSENT IS PROHIBITED.

REVISIONS

3 17 OCT 11
REVISED PLANTING DUE TO BUILDING REVISIONS

Keller Springs Lofts

EMBREY PARTNERS, LTD
ADDISON, TEXAS

SCALE
1/8" = 1'-0"

DATE
19 AUG 2011

TITLE
LANDSCAPE

SHEET
5L OF 6