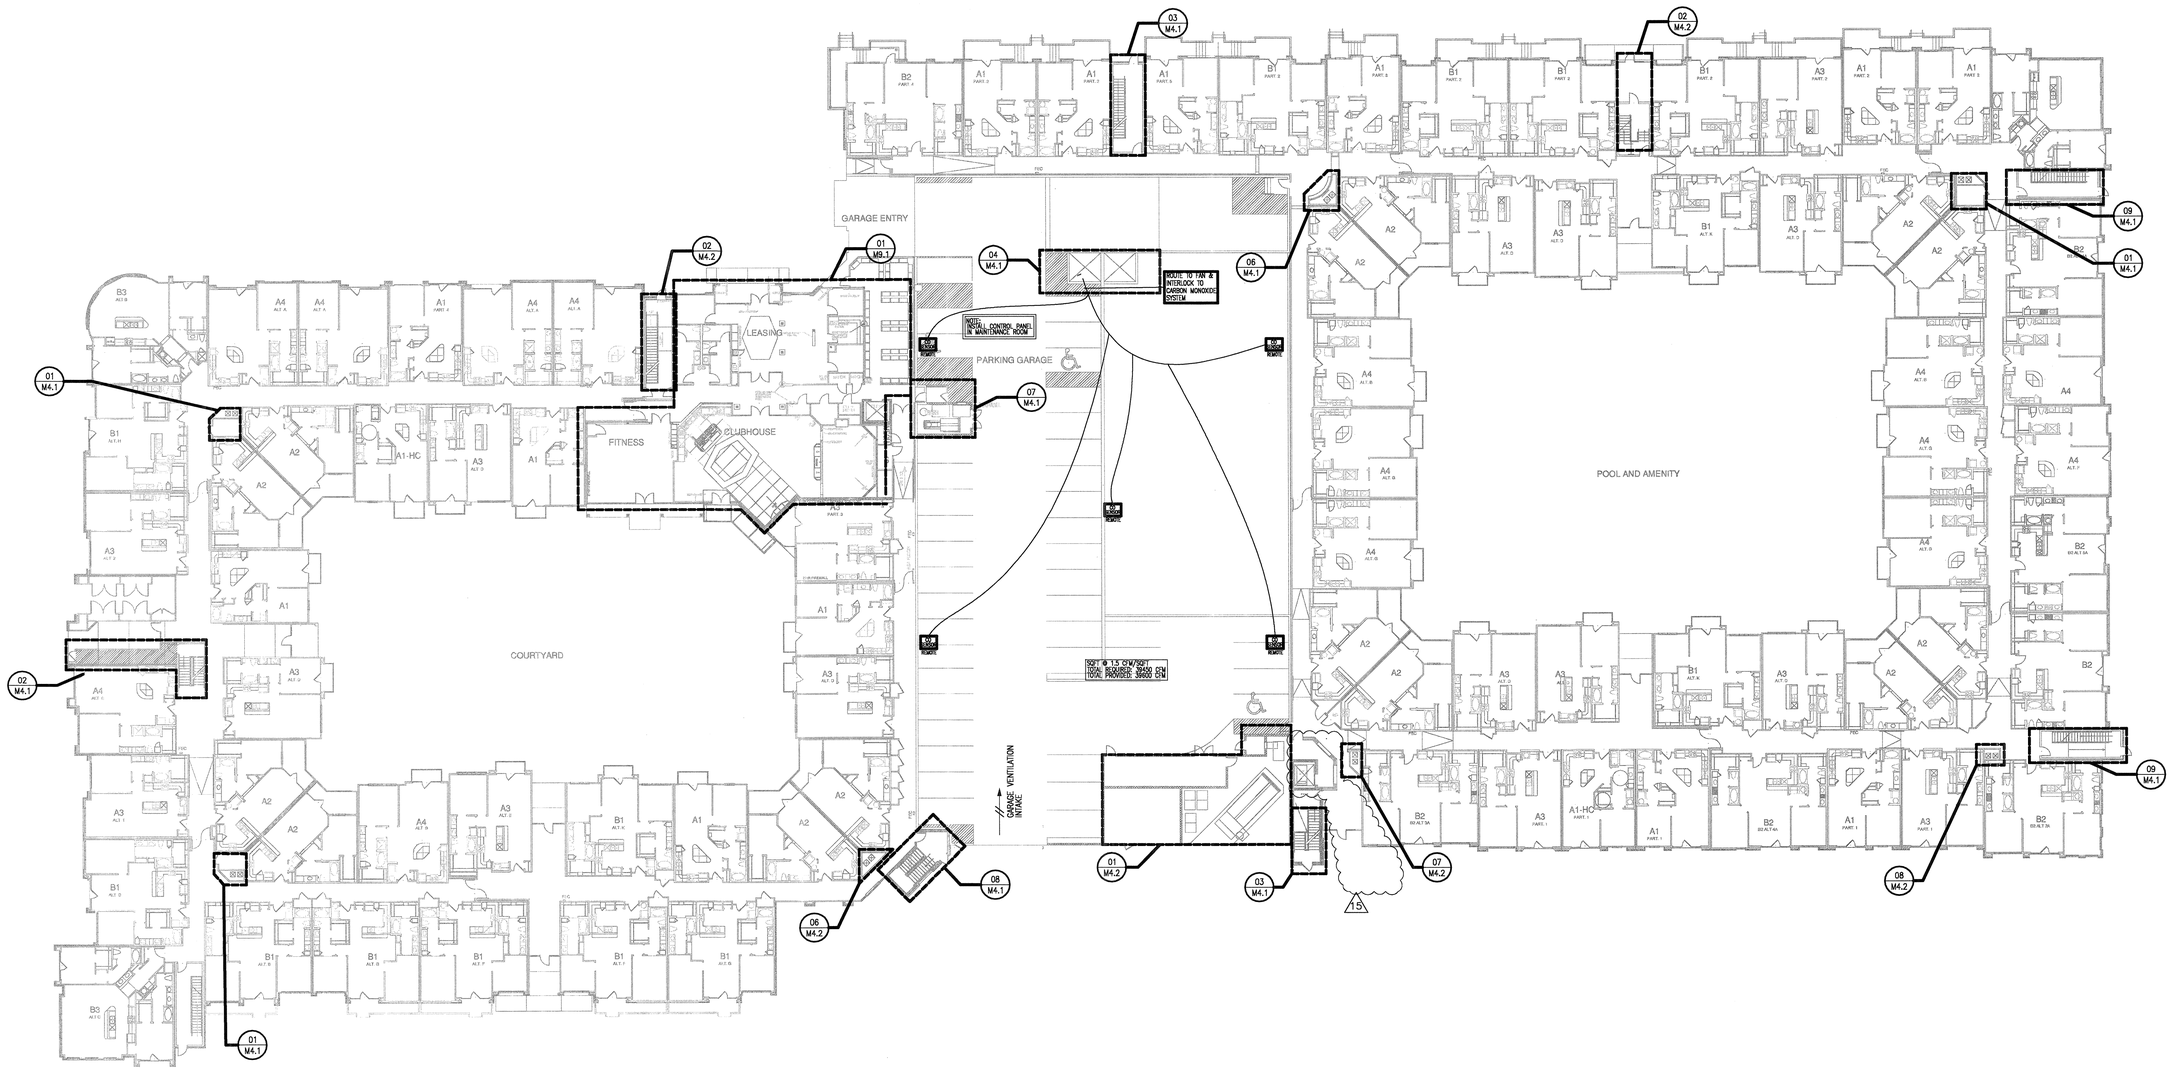

1 OVERALL FIRST FLOOR PLAN

SCALE: NOT TO SCALE

ANDREW H. SMITH
89855
LICENSED
PROFESSIONAL ENGINEER
4-19-13

REVISIONS

1	9–2–2011	DESIGN REVISIONS
2	9–13–2011	ANSI/FHA COMMENTS
3	9–23–2011	DESIGN REVISIONS
4	10–17–2011	CONSTRUCTION ISSUE
5	12–21–2011	DESIGN REVISIONS
6	1–17–2012	DESIGN REVISIONS
7	2–15–2012	TRANSFORMER REVISIONS
8	3–27–2012	CLUBHOUSE REVISIONS
9	4–17–2012	COORDINATION
10	5–15–2012	COORDINATION
11	5–30–2012	SITE COORDINATION
12	6–01–12	LIGHTING REVISIONS
13	6–29–12	SITE COORDINATION
14	9–05–12	CLUB REVISIONS
15	4–19–13	EL. LOBBY REVIONS

KELLER SPRINGS LOFTS

LOFT APARTMENTS IN ADDISON, TEXAS

BGO architects
4144 N. Central Expy.
Suite 855
Dallas, TX 75204
214.520.8878
bgoarchitects.com

DATE
08–05–11

PROJECT
11129

SHEET NUMBER
M-3.1
FIRST FLOOR BUILDING MECHANICAL

Jordan & Skala Engineers
17855 N. Dallas Parkway, Suite 320
Dallas, TX 75287-6857
V: (469) 385-1616 F: (469)385-1615
Texas Firm Registration # F-4990

Project Number - 113-0355
Drawn By: CJH
Checked By: AHS