KEYNOTES: (APPLIES TO THIS SHEET ONLY)

1. ROUTE 1" CONDENSATE DRAIN TO HUB DRAIN BELOW ROOF. SEE PLUMBING PLANS FOR EXACT LOCATIONS
2. ALL OUTSIDE AIR INTAKES SHALL MAINTAIN 10'-0" FROM EXHAUST TERMINATIONS AND PLUMBING VENTS.

NOTES:

1. INSTALL CONDENSERS ON CURB (BY OTHERS).
2. THERE SHALL BE NO ROOF PENETRATIONS WITHIN 4'-0" OF A FIREWALL.
3. COORDINATE REFRIGERANT LINESET HOODS AND LINESET ROUTING PRIOR TO CONSTRUCTION.
4. ALL EQUIPMENT INSTALLED WITHIN 10'-0" OF A ROOF EDGE SHALL HAVE GUARDS TO COMPLY WITH 2009 IMC SECTION 304.11.

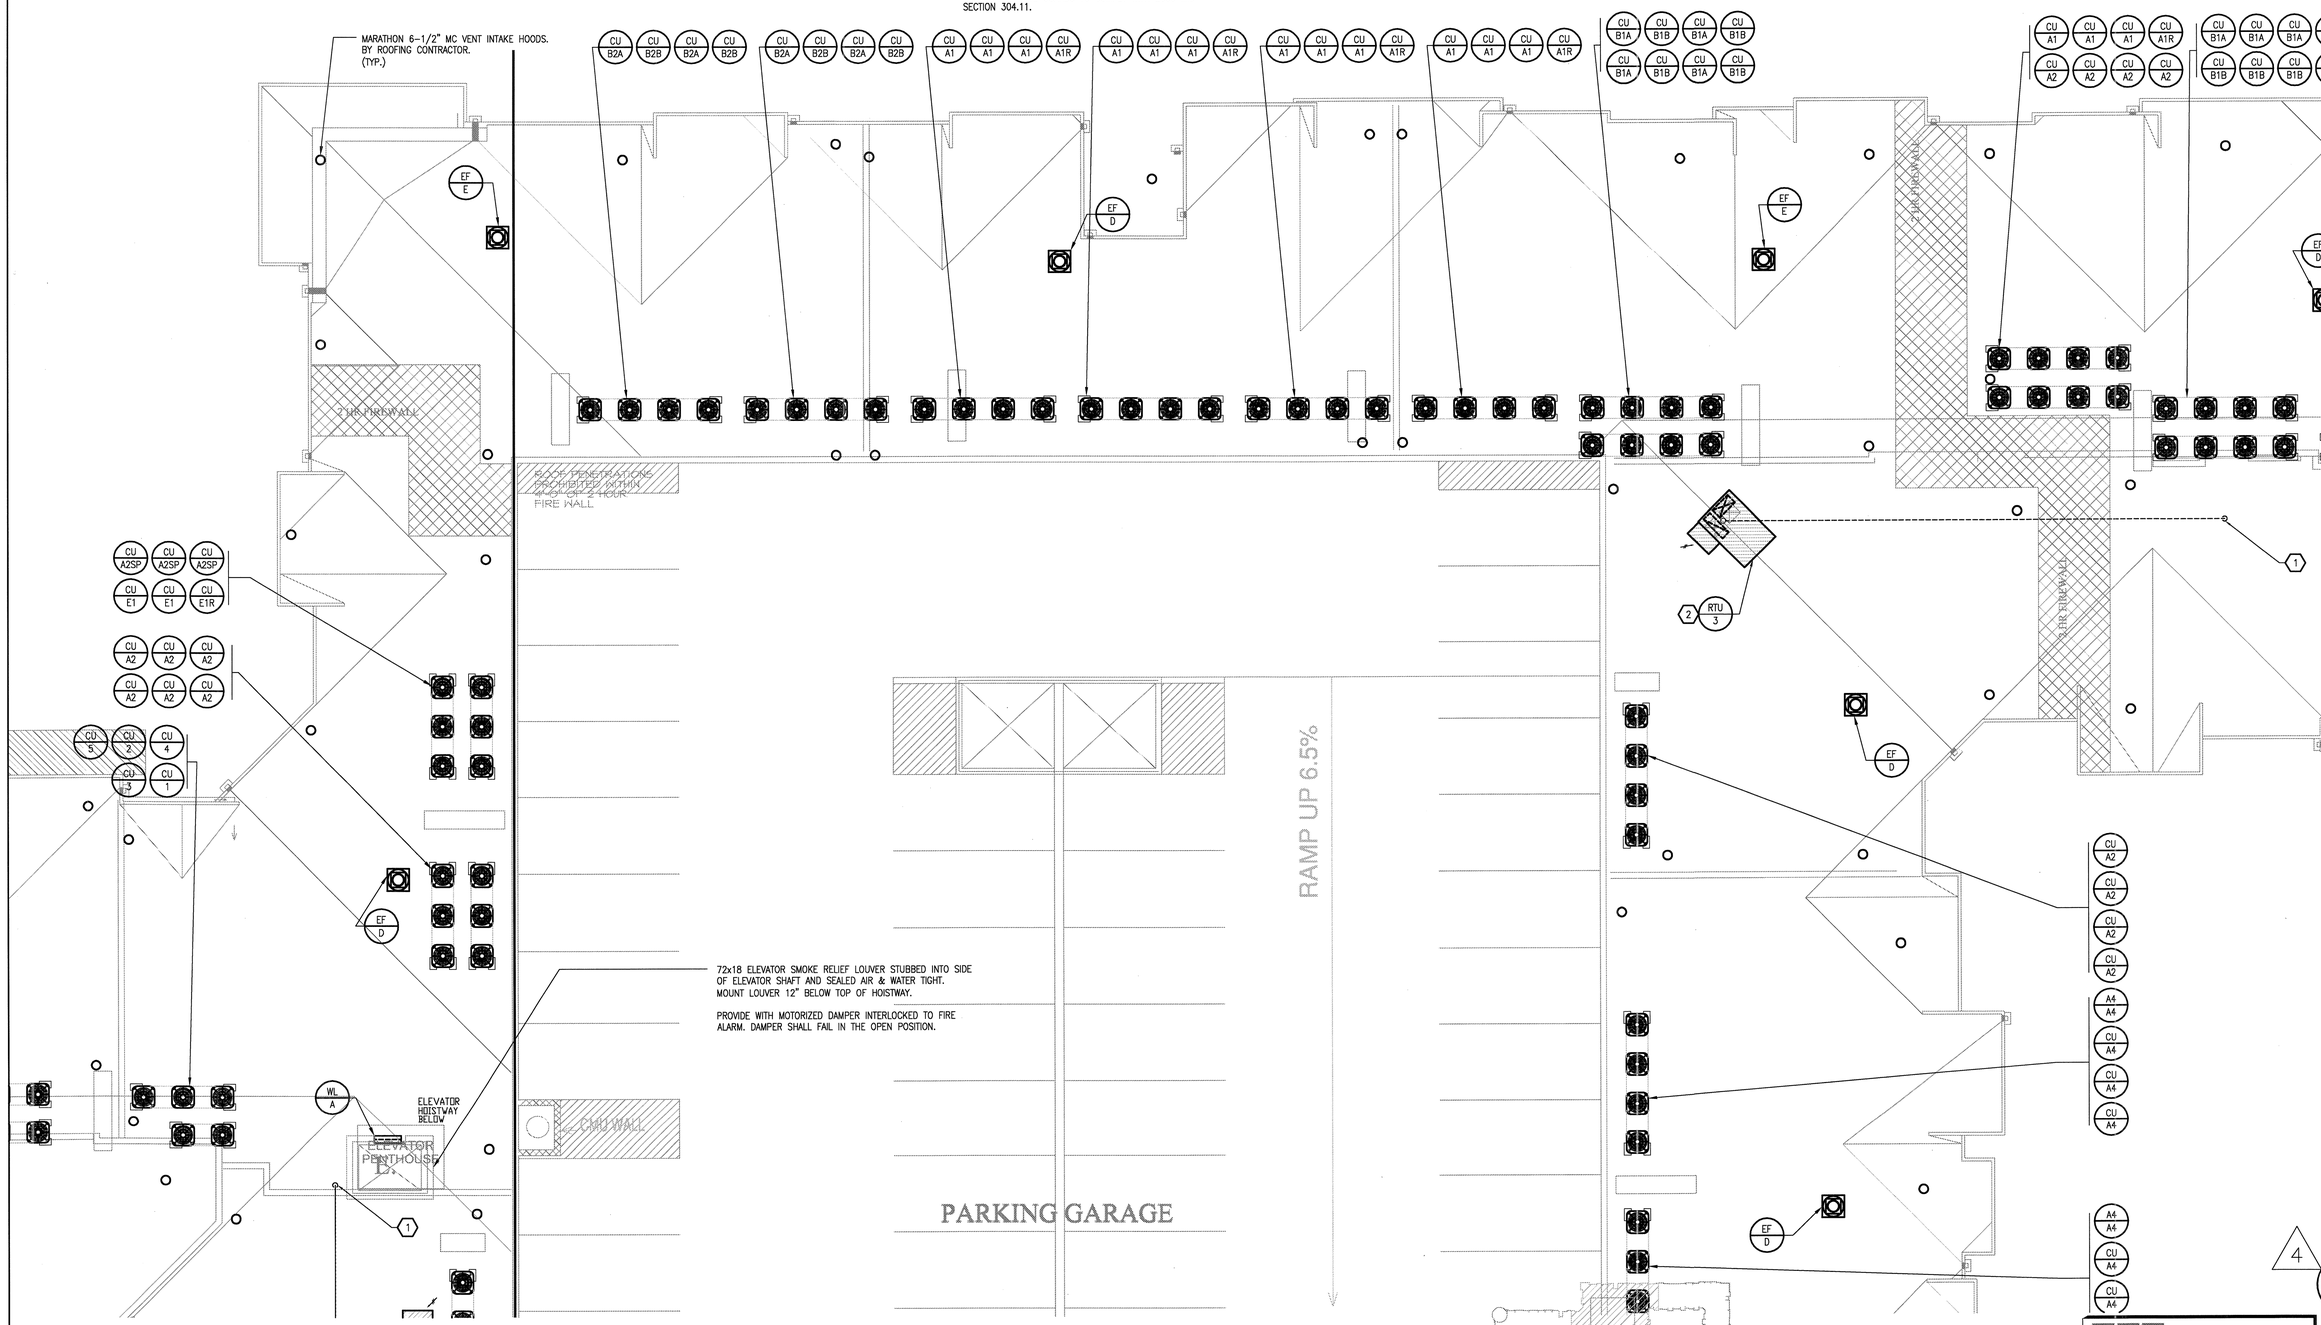

1 DIVISION 'C' ROOF PLAN
SCALE: 1/8" = 1'-0"

HON PAN WONG
108965
LICENSED
PROFESSIONAL ENGINEER
STATE OF TEXAS

REVISIONS

1	9-2-2011	DESIGN REVISIONS
2	9-13-2011	ANSI/FHA COMMENTS
3	9-23-2011	DESIGN REVISIONS
4	10-17-2011	CONSTRUCTION ISSUE

KELLER SPRINGS LOFTS

LOFT APARTMENTS IN ADDISON, TEXAS

BGO architects
4144 N. Central Expy.
Suite 855
Dallas, TX 75204
214.520.8878
bgoarchitects.com

DATE
08-05-11

PROJECT
11129

SHEET NUMBER
M-3.5C
ROOF PLAN
DIVISION C
MECHANICAL

Jordan & Skala Engineers
14240 Midway Road, Suite 350
Dallas, TX 75244-5138
V: (469) 385-1616, F: (469) 385-1615
Project Number - 113-0355
Drawn By: CJH
Texas Firm Registration # F-4990
Checked By: AHS