

REVISIONS

1	9-2-2011	DESIGN REVISIONS
2	9-13-2011	ANSI/FHA COMMENTS
3	9-23-2011	DESIGN REVISIONS
4	10-17-2011	CONSTRUCTION ISSUE

KELLER SPRINGS LOFTS
 LOFT APARTMENTS IN ADDISON, TEXAS



4144 N. Central Expy.
 Suite 855
 Dallas, TX 75204
 214.520.8878
 bgoarchitects.com


DATE
08-05-11

PROJECT
 11129

SHEET NUMBER

P-3.0C

JSE Jordan & Skala Engineers
 14240 Midway Road, Suite 300
 Dallas, TX 75244-5138
 V: (469) 385-1676 F: (469) 385-1615
 Project Number - 113-0355 Texas Firm Registration # F-4990
 Drawn By: CV Checked By: RC

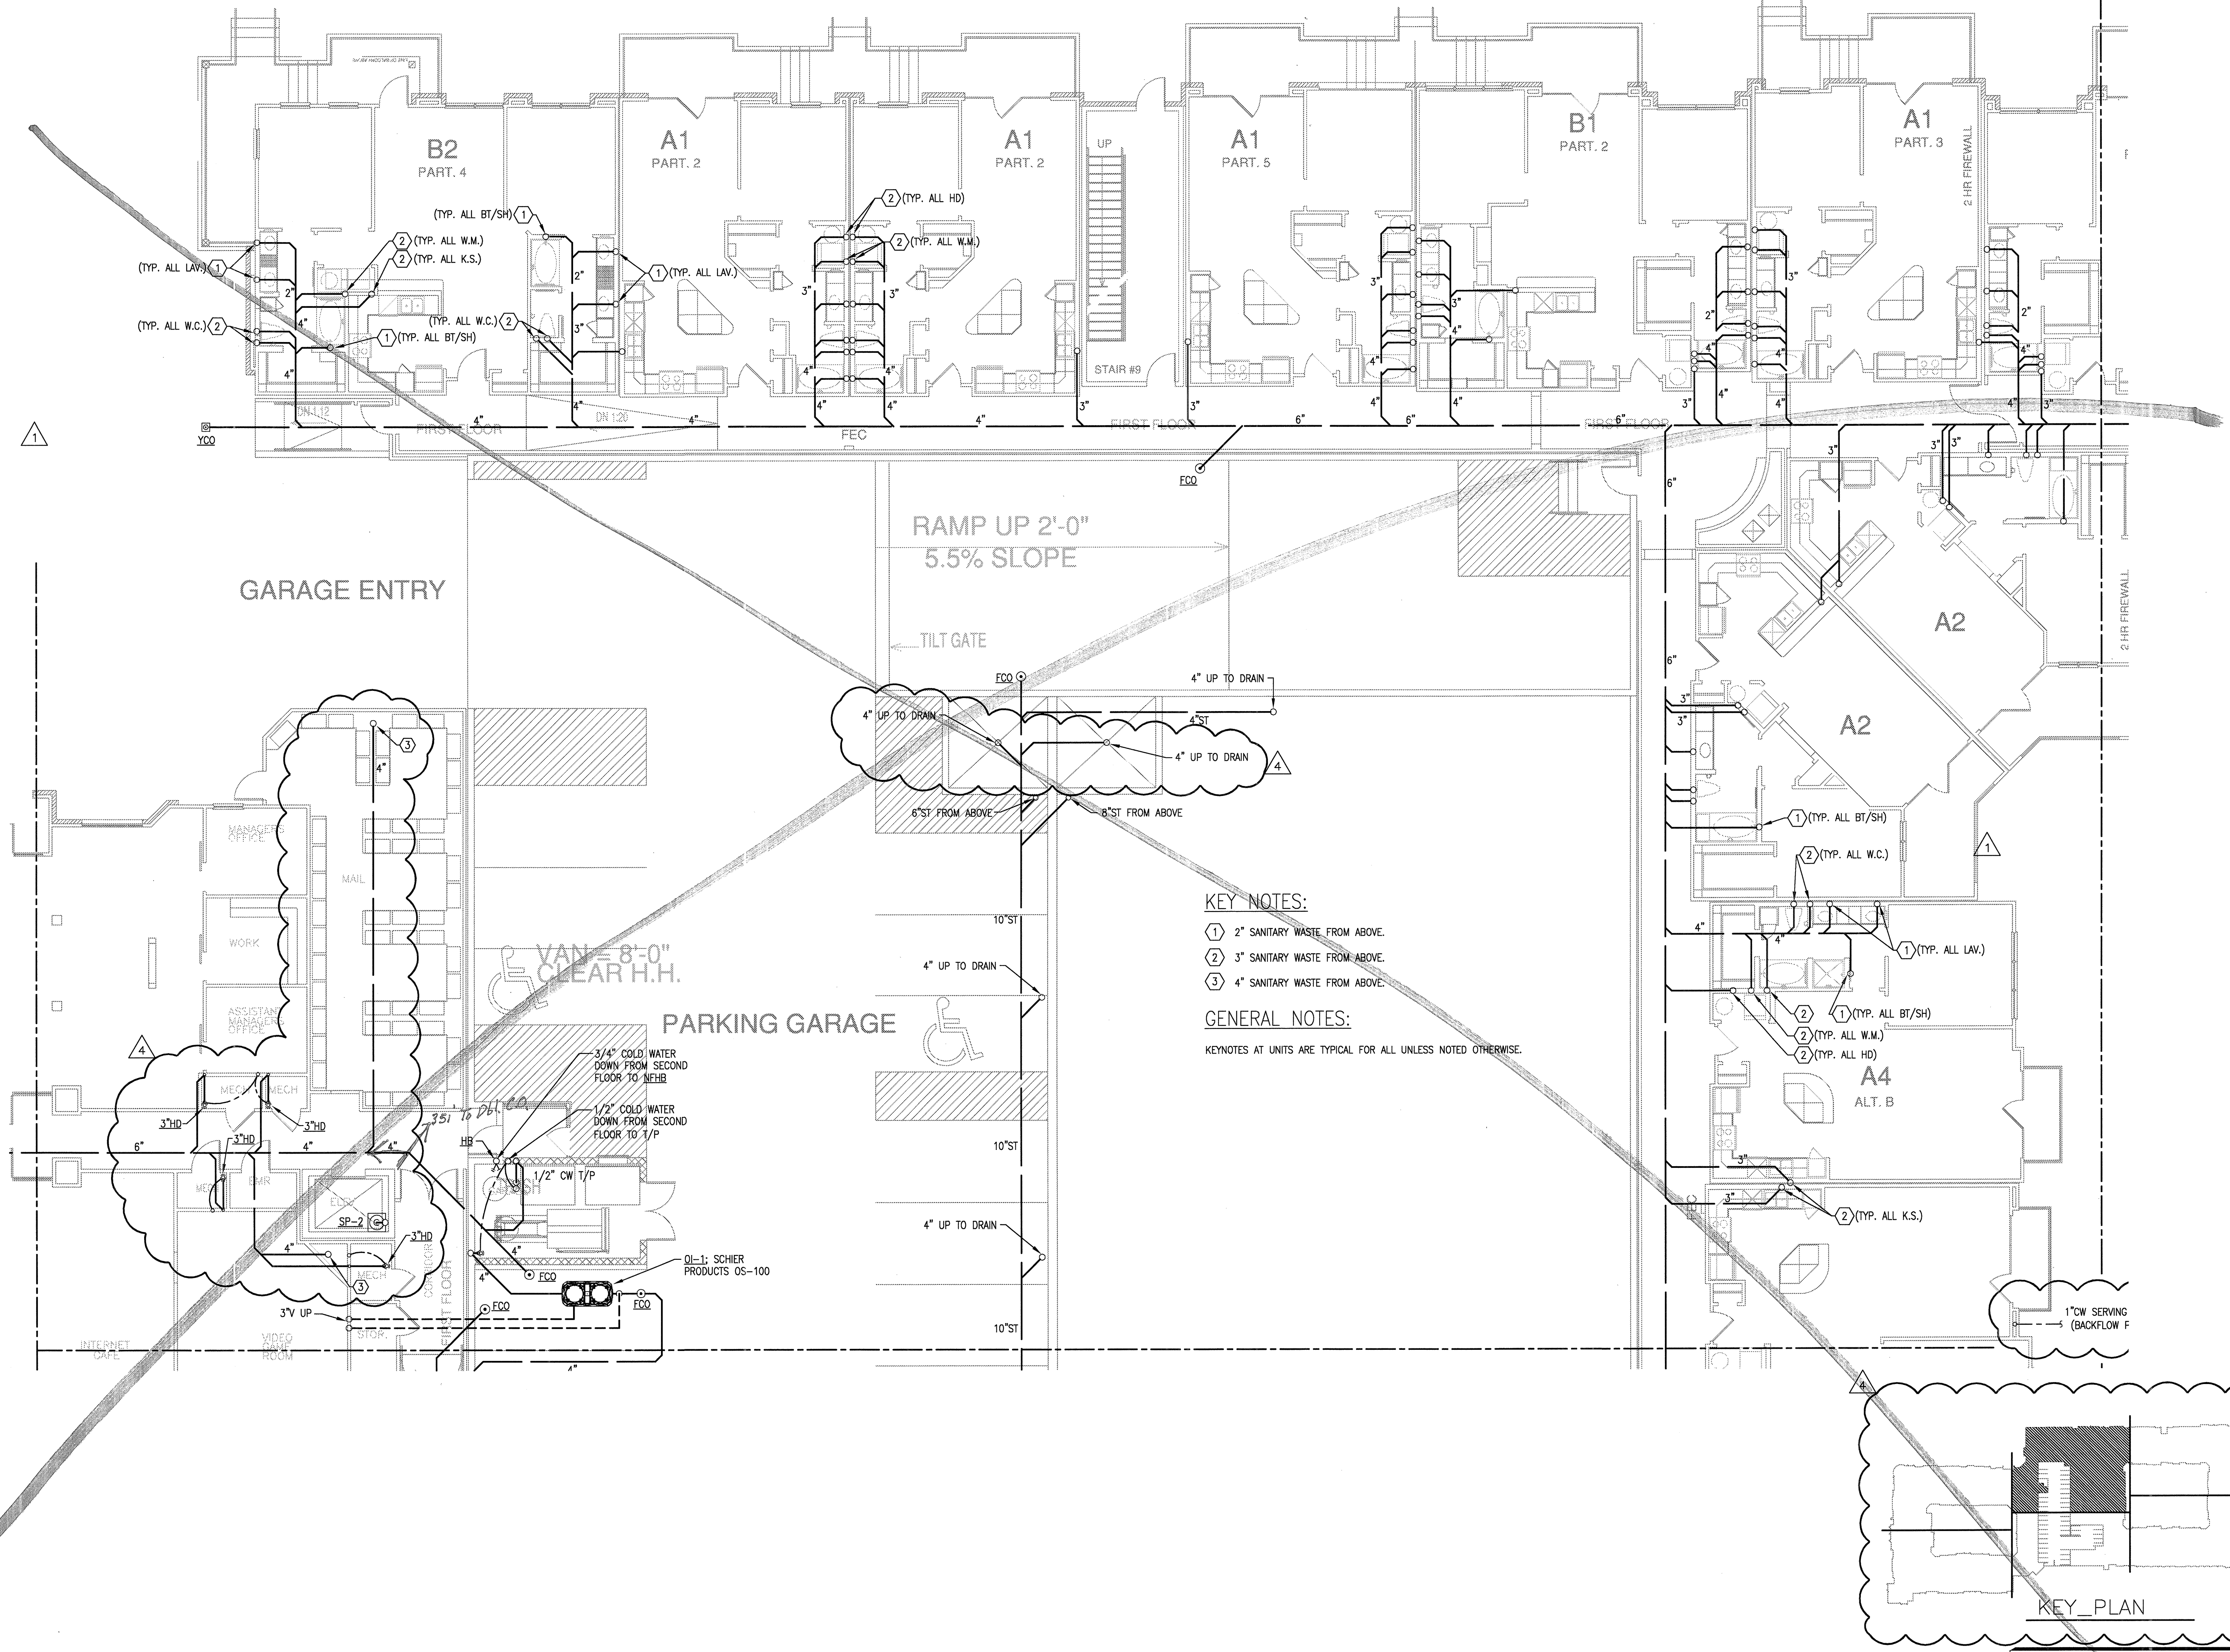

1 DIVISION 'C' UNDERFLOOR PLAN
 SCALE: 1/8" = 1'-0"