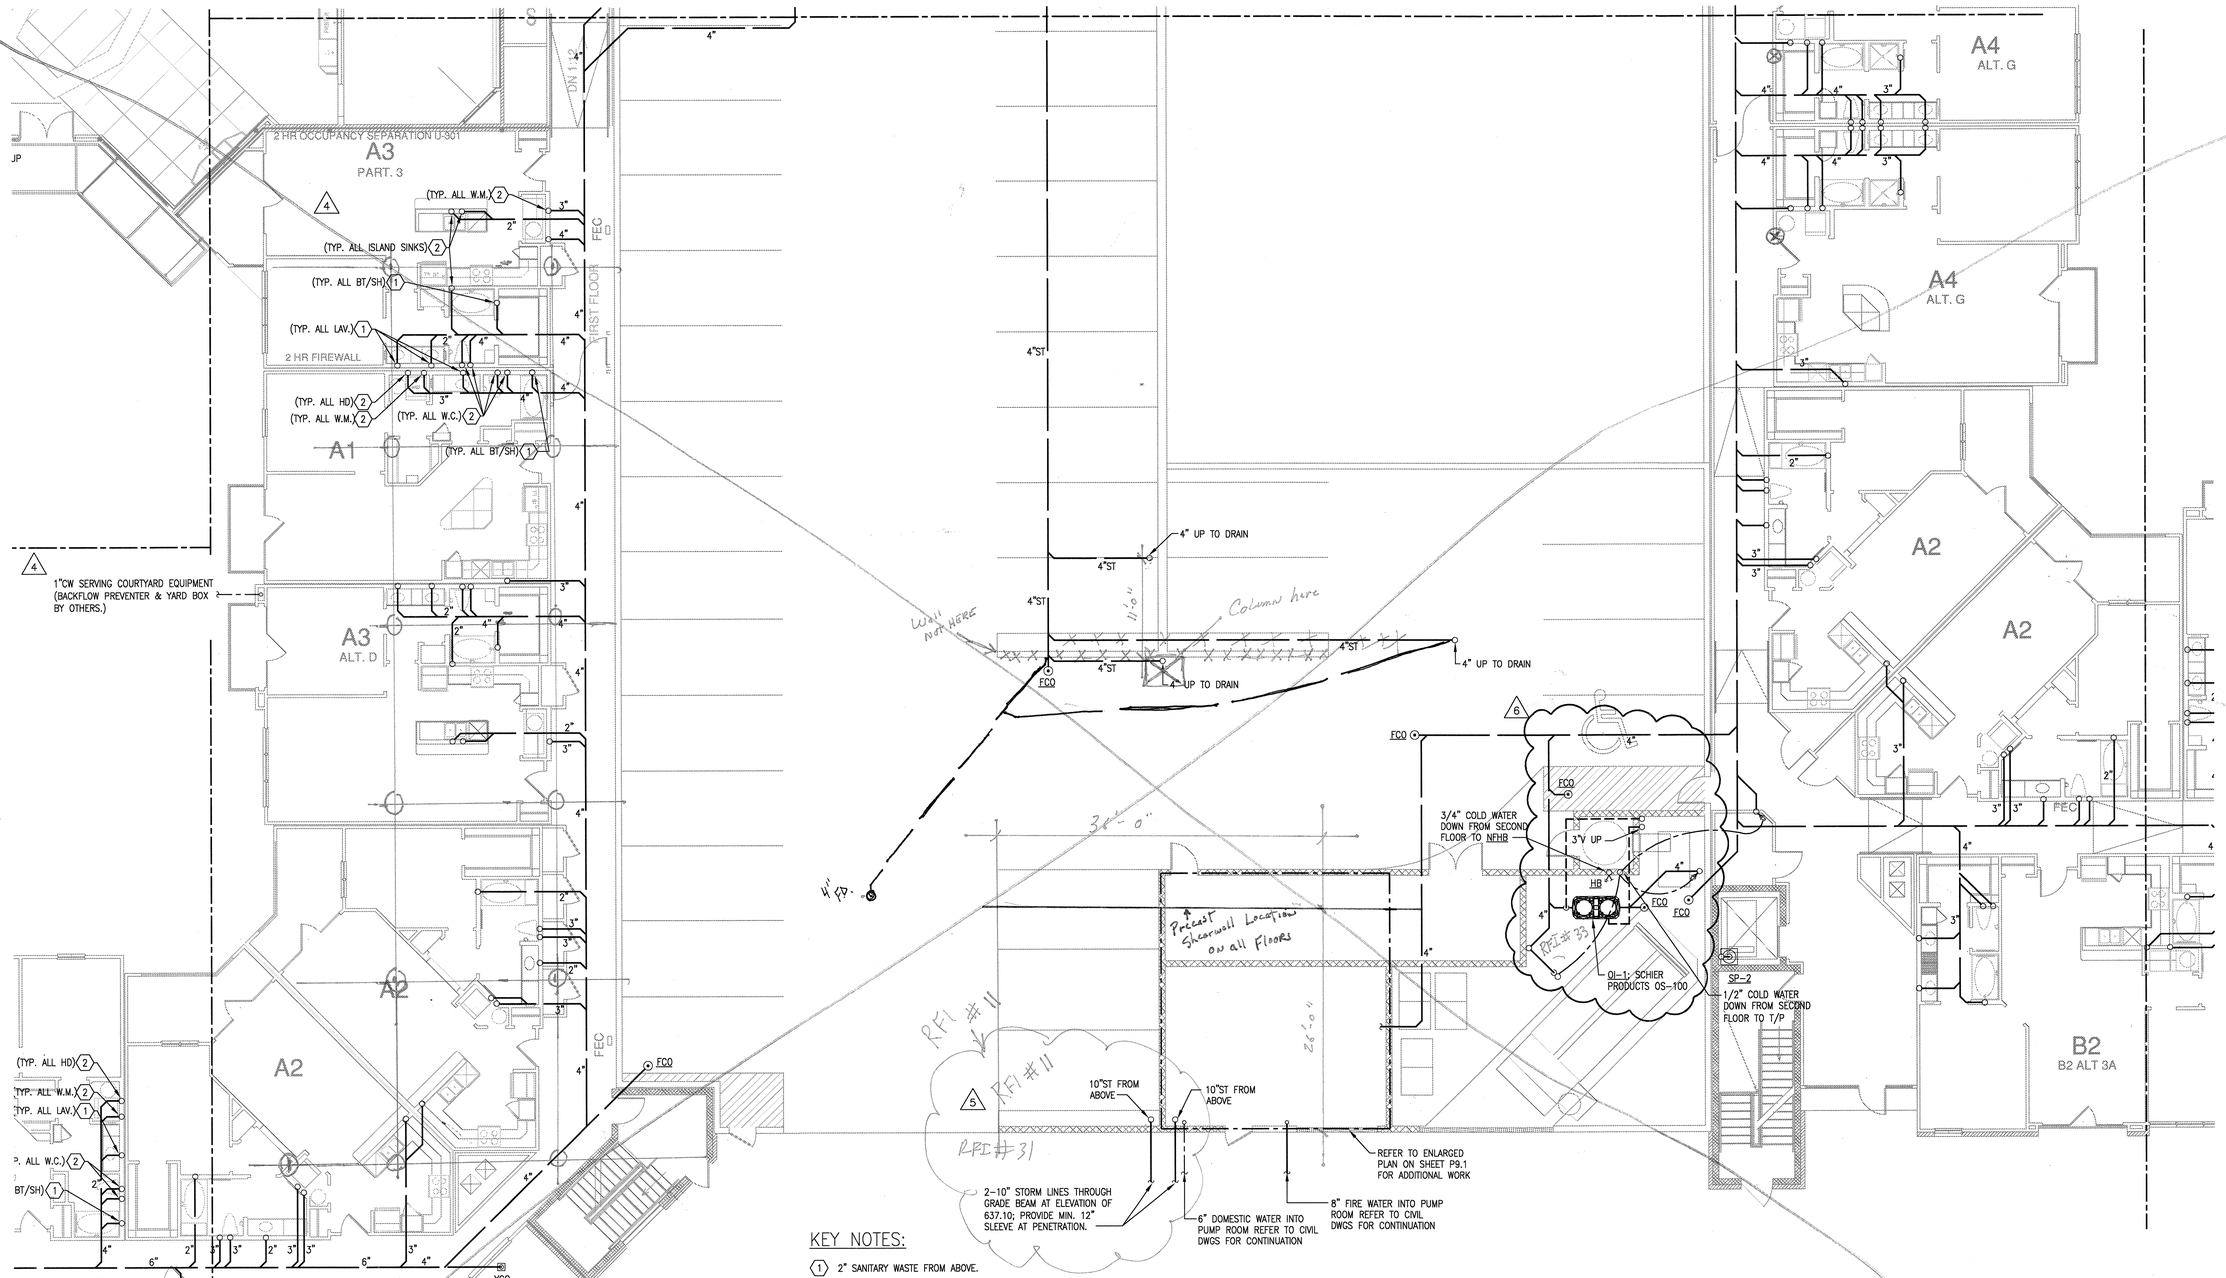


## KEY NOTES:

1. 2" SANITARY WASTE FROM ABOVE.
2. 3" SANITARY WASTE FROM ABOVE.
3. 4" SANITARY WASTE FROM ABOVE.

## GENERAL NOTES:

KEYNOTES AT UNITS ARE TYPICAL FOR ALL UNLESS NOTED OTHERWISE.

1 DIVISION 'D' UNDERFLOOR PLAN
SCALE: 1/8" = 1'-0"




STATE OF TEXAS
JON PAN WONG
103955
LICENSED
PROFESSIONAL ENGINEER
1-17-12

REVISIONS

| | | |
|---|---|---|
| 1 | 9-2-2011 | DESIGN REVISIONS |
| 2 | 9-13-2011 | ANSI/FHA COMMENTS |
| 3 | 9-23-2011 | DESIGN REVISIONS |
| 4 | 10-17-2011 | CONSTRUCTION ISSUE |
| 5 | 12-21-2011 | DESIGN REVISIONS |
| 6 | 1-17-2012 | DESIGN REVISIONS |

# KELLER SPRINGS LOFTS

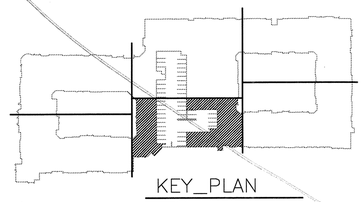LOFT APARTMENTS IN ADDISON, TEXAS

BGO architects
4144 N. Central Expy.
Suite 855
Dallas, TX 75204
214.520.8878
bgoarchitects.com

DATE
08-05-11

PROJECT
11129

SHEET NUMBER
**P-3.0D**

JSE Jordan & Skala Engineers
14240 Midway Road, Suite 320
Dallas, TX 75244-5138
V: (469) 385-1616 F: (469) 385-1615
Project Number - 113-0355
Drawn By: CV
Texas Firm Registration # F-4990
Checked By: RC