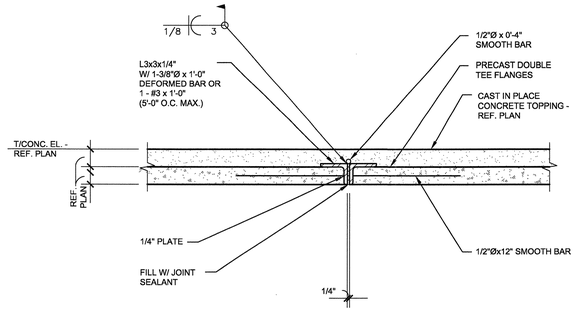

1 SG4.03 **DETAIL**
SCALE: 1 1/2"=1'-0"

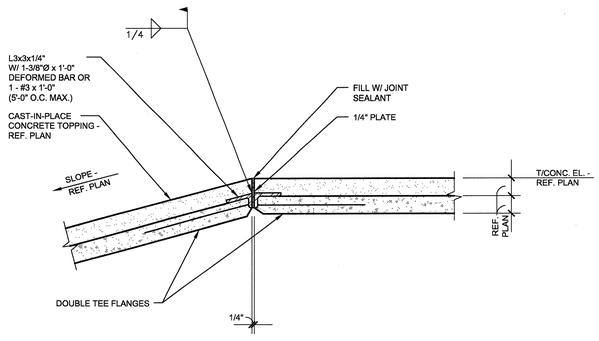

2 SG4.03 **DETAIL**
SCALE: 1 1/2"=1'-0"

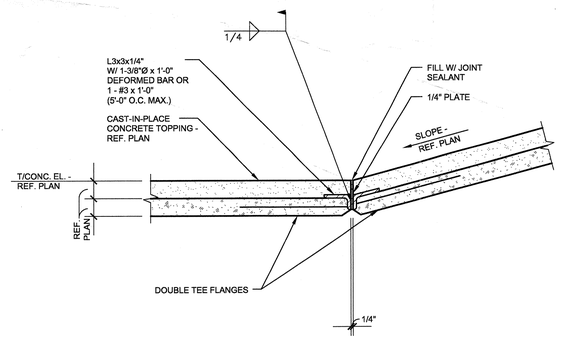

3 SG4.03 **DETAIL**
SCALE: 1 1/2"=1'-0"

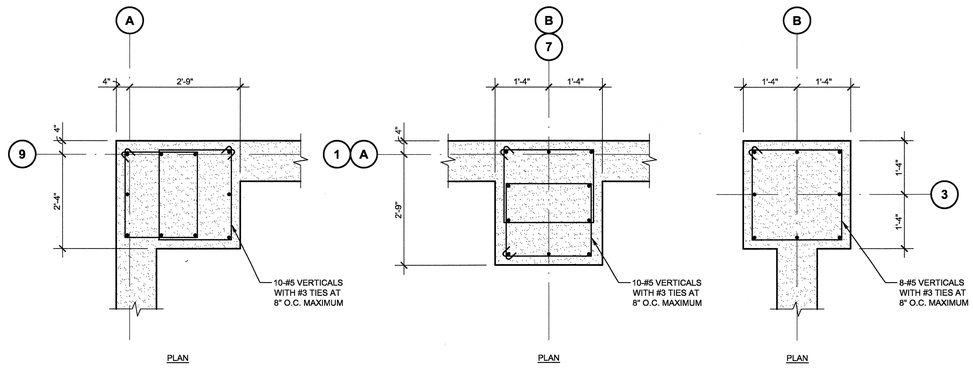

4 SG4.03 **TYPICAL PILASTER DETAILS**
NO SCALE

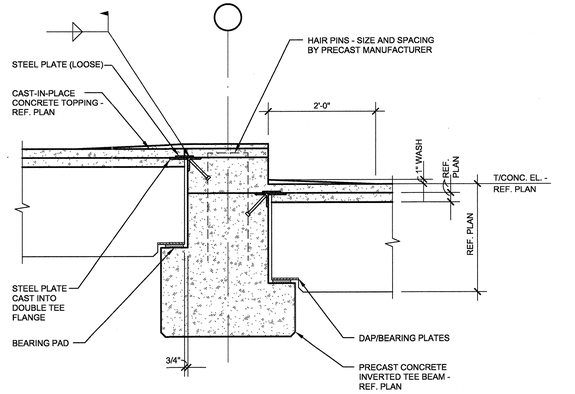

5 SG4.03 **TYPICAL PRECAST DOUBLE TEE TO BEAM DETAIL**
SCALE: 3/4"=1'-0"

1

THE SEAL APPEARING ON THIS DOCUMENT WAS AUTHORIZED BY R. TRENT PERKINS, P.E. 84264

R TRENT PERKINS 84264 REGISTERED PROFESSIONAL ENGINEER STATE OF TEXAS

THIS DOCUMENT IS THE RENDERING OF A PROFESSIONAL SERVICE. THE ESSENCE OF WHICH IS THE PROVIDING OF ADVICE, JUDGEMENT, OPINION, OR SIMILAR PROFESSIONAL SKILL.

PARKIN - PERKINS - OLSEN
CONSULTING ENGINEERING, INC.
9330 LBJ Freeway Suite 1055
Dallas, Texas 75243
Tel 214.221.2220 Fax 214.221.2252
Project No. 39155
Registration No. F-1479

REVISIONS

1	PRECAST SUBMITTAL COORDINATION	10/17/11

KELLER SPRINGS LOFTS

LOFT APARTMENTS IN ADDISON, TEXAS

CONSTRUCTION ISSUE
10-17-2011

BGO architects
4144 N. Central Expy.,
Suite 855
Dallas, TX 75204
214.520.8878
bgoarchitects.com

DATE
08-05-2011

PROJECT
11129

SHEET NUMBER
SG4.03