

WOOD TRUSSES -

2 LAYERS OF 1" SHAFT LINER — REF. ARCH'L

- 1/2" GYP. BOARD -

16d NAILS @ 6" O.C.

T/SHEATHING EL. -

REF. PLAN

REF. ARCH'L

— 2x CONT. BAND

--- FLOOR SHEATHING


- WOOD TRUSSES -

REF. PLAN

NOTE: REF. 1/S4.03 AND 2/S4.03


FOR SHEARWALL BLOCKING INFO. (NOT SHOWN FOR CLARITY)

REF. PLAN

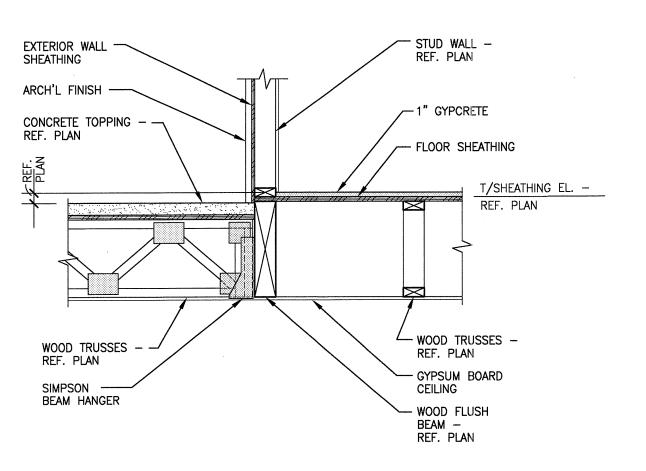

SECTION

SECTIO S4.04 NO SCALE

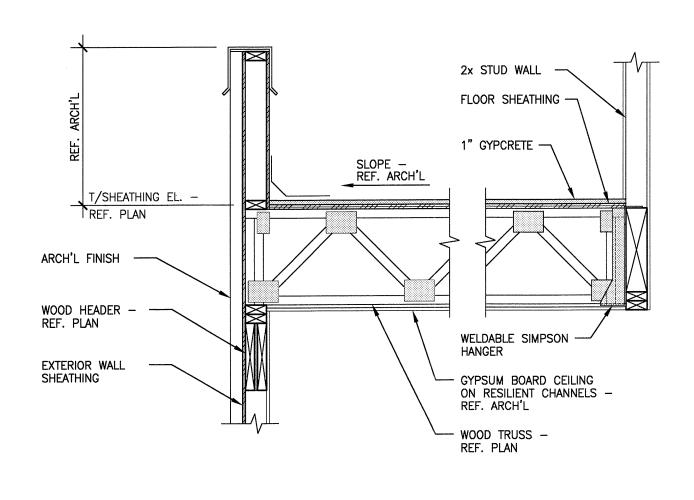

4 SECTION S4.04 NO SCALE

8 SECTION NO SCALE




HVAC CLOSET WALL -BELOW - REF. PLAN

ALIGN WOOD TRUSS WITH — HVAC CLOSET WALL

WOOD TRUSSES

REF. PLAN

REF. PLAN

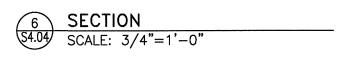


REF. ARCH'L


WOOD BEAM


BEAM HANGER


SIMPSON TOP FLANGE -


REF. PLAN

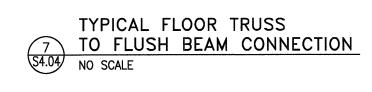

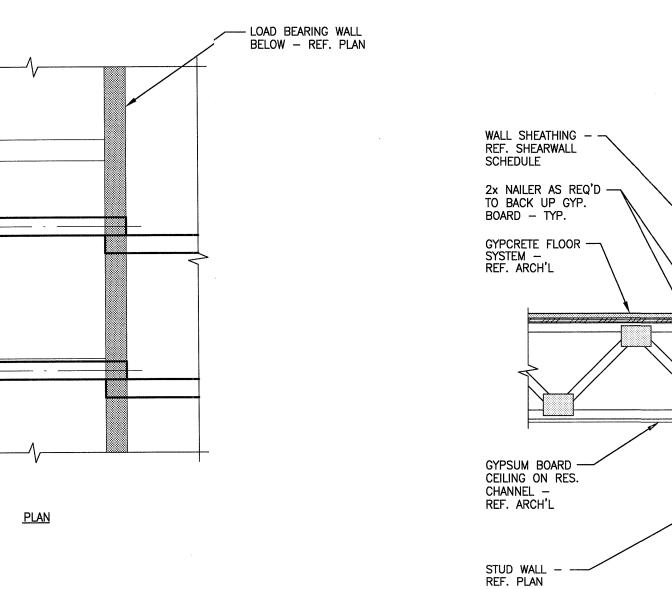


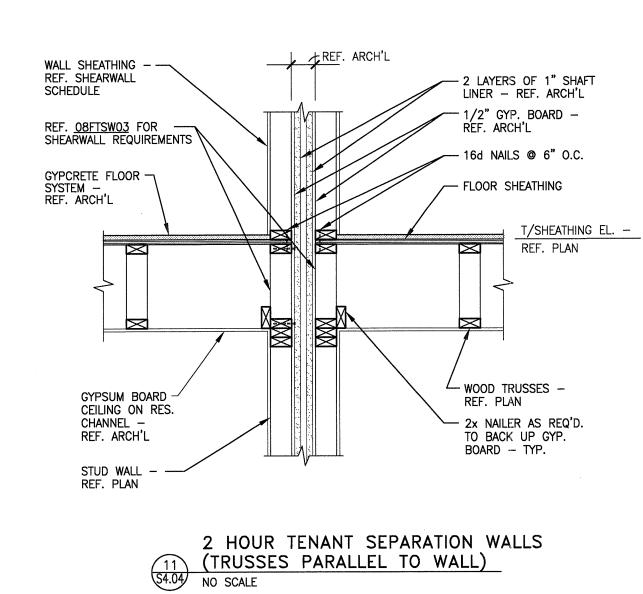

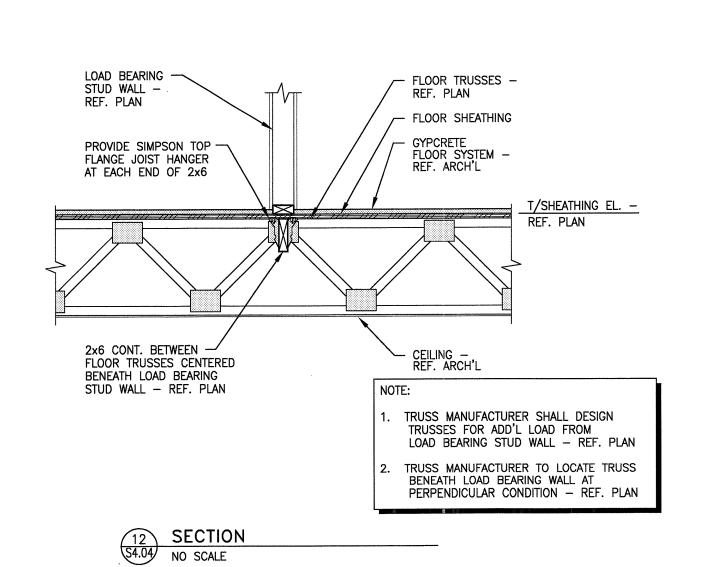

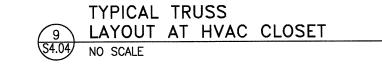



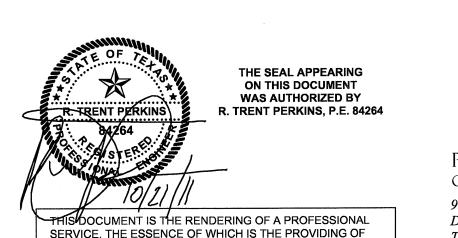

ADVICE, JUDGEMENT, OPINION, OR SIMILAR PROFESSIONAL





REVISIONS

EXAS

DATE

08-05-2011 PROJECT

11129

SHEET NUMBER