



TYPICAL INTERIOR SHEARWALL DETAIL (TRUSSES PERPENDICULAR TO WALL) NO SCALE

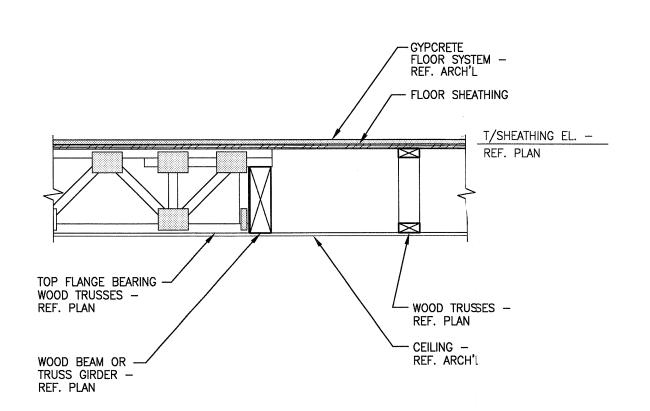


TYPICAL FLOOR TRUSS TO FLUSH BEAM CONNECTION S4.03 NO SCALE

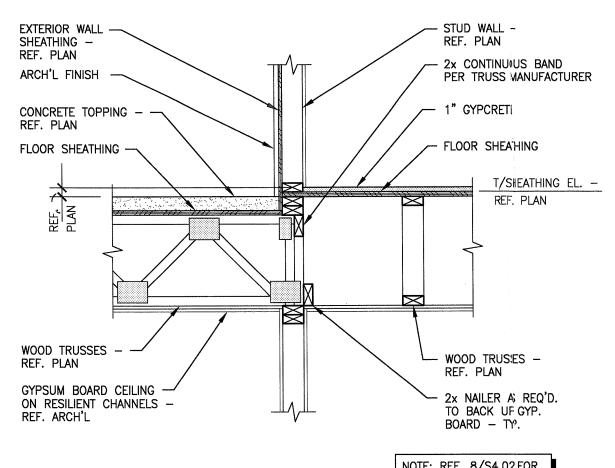


NOTE: REF. 8/S4.02 FOR ADD'L INFO. NOT NOED


SECTION

S4.03 NO SCALE

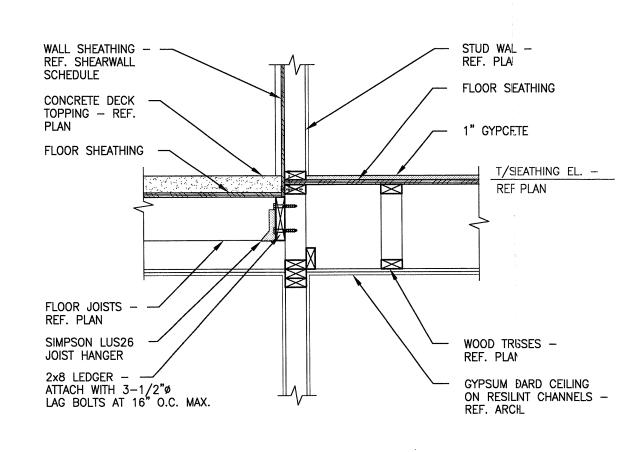



SECTION
NO SCALE

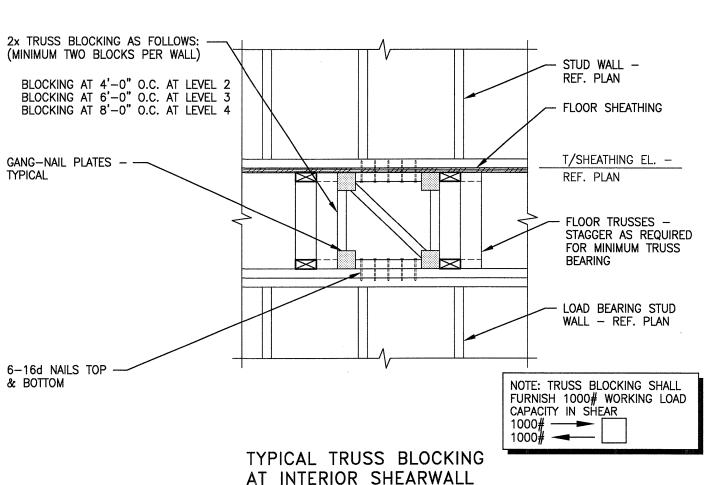

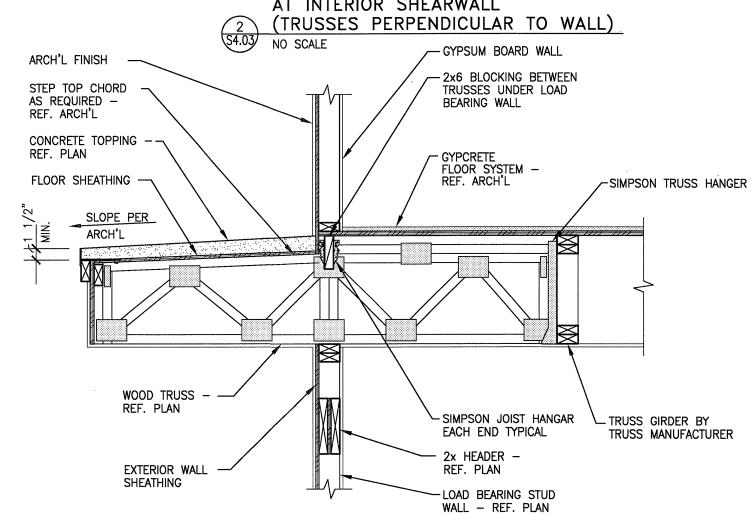



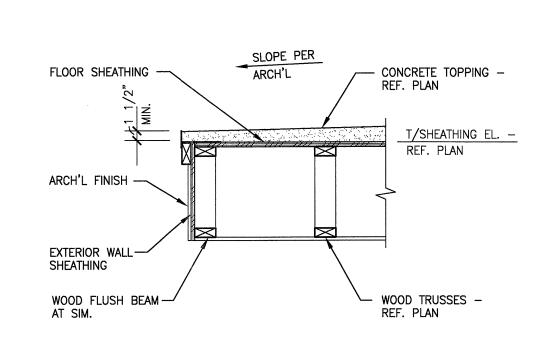


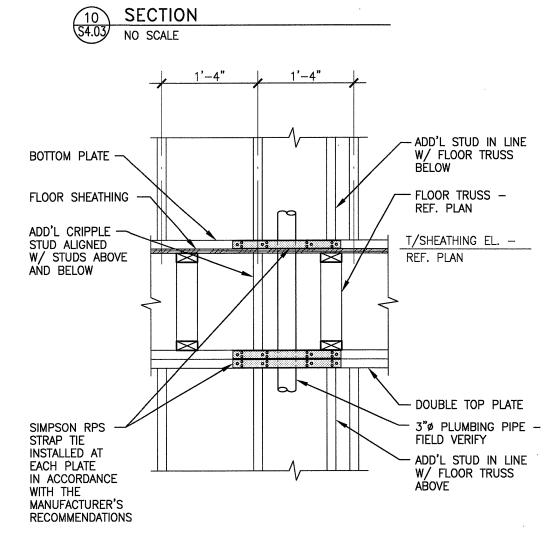

TYPICAL PLATE REPAIR DETAIL

AT PLUMBING PENETRATION


S4.03 NO SCALE

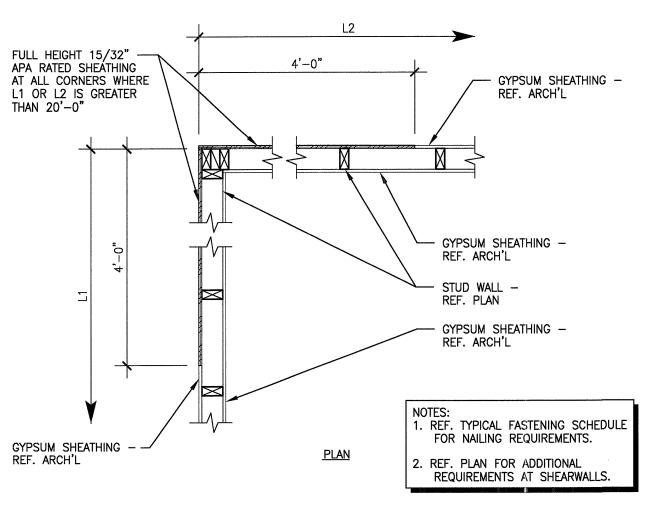



TYPICAL EXTERIOR


CORNER BRACING DETAIL


On Scale

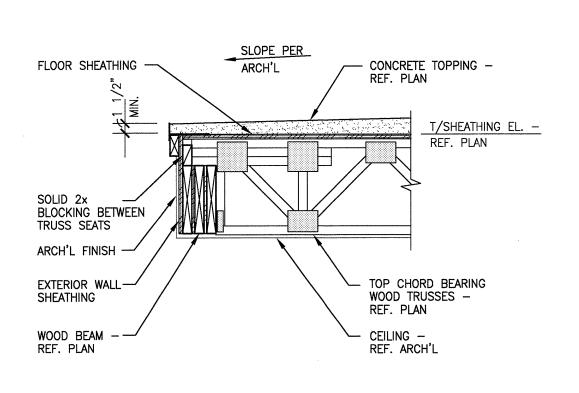

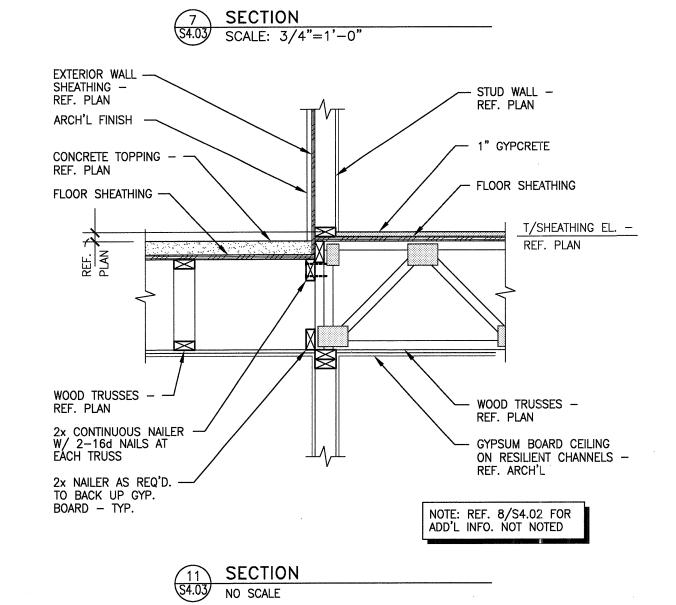

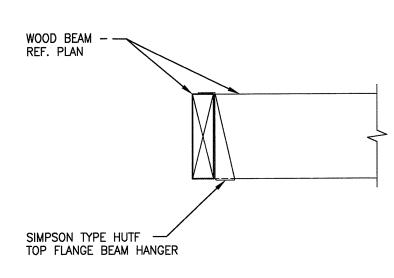


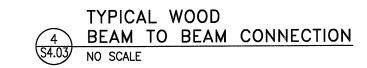

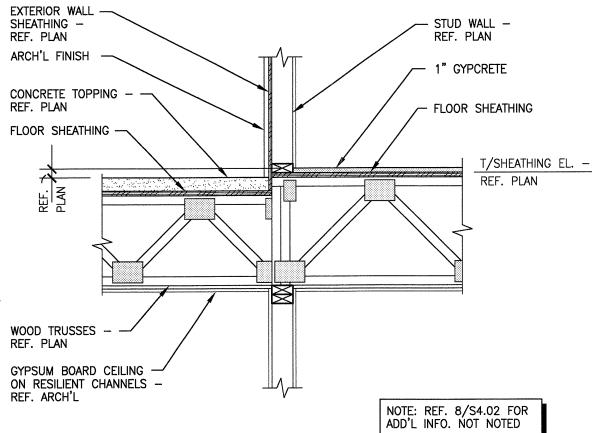


TYPICAL EXTERIOR
LOAD BEARING WALL DETAIL
(TRUSSES PERPENDICULAR TO WALL)

NO SCALE

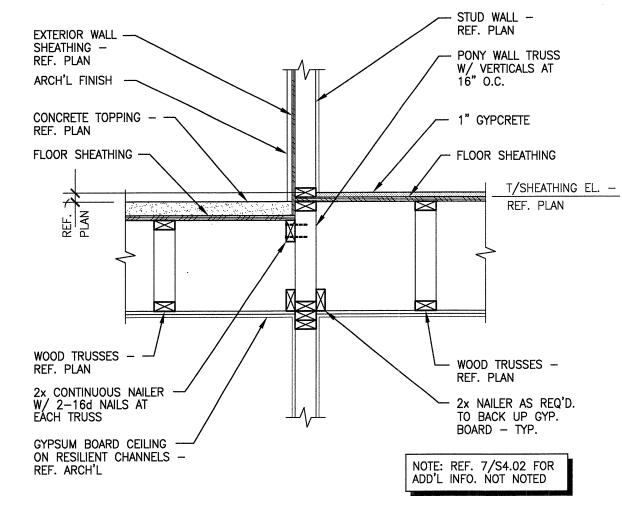


12 SECTION S4.03 SCALE: 3/4"=1'-0"

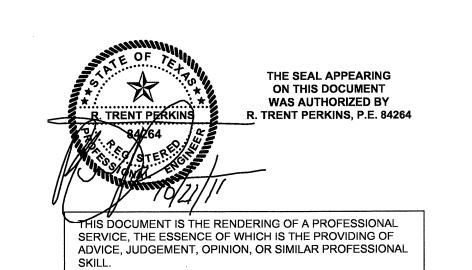





REVISIONS

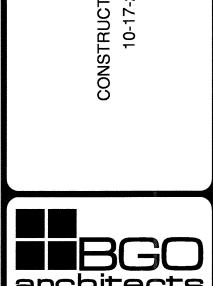



DATE 00.05.0044

08-05-2011 PROJECT

11129

SHEET NUMBER

S4.03