





TYPICAL OPENING FRAMING AT 2 2x STUD WALL - OPENING ≥ 6'-0' S4.02 NO SCALE

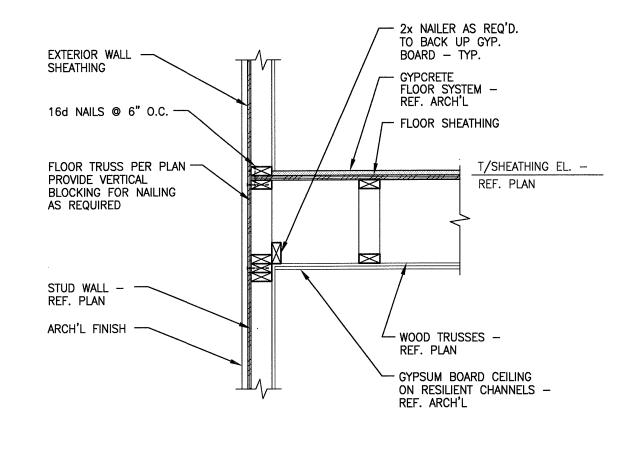


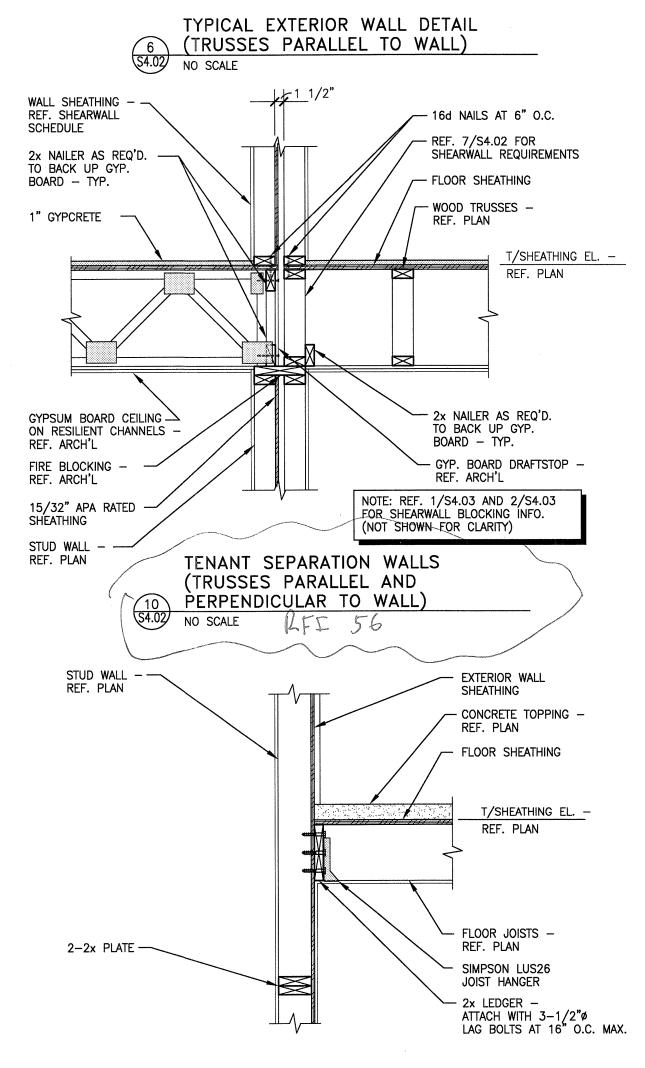



14 STAIR LANDING SECTION
S4.02 NO SCALE

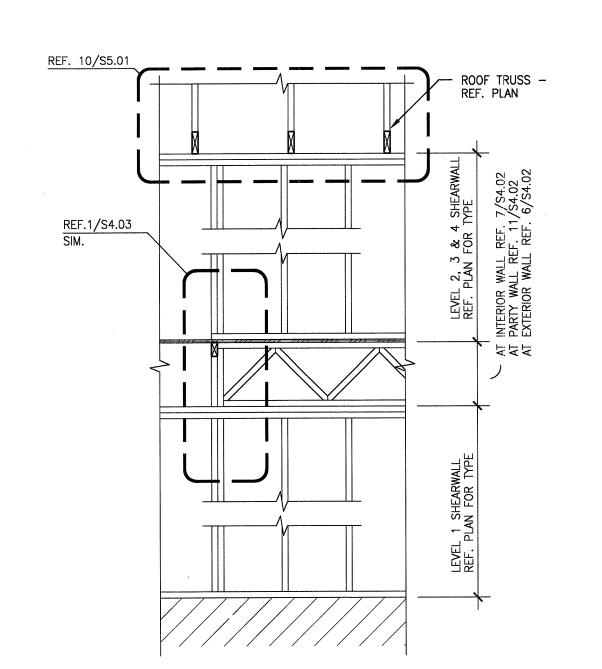


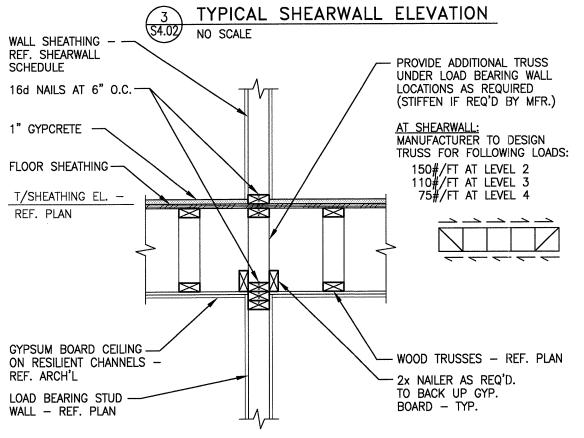


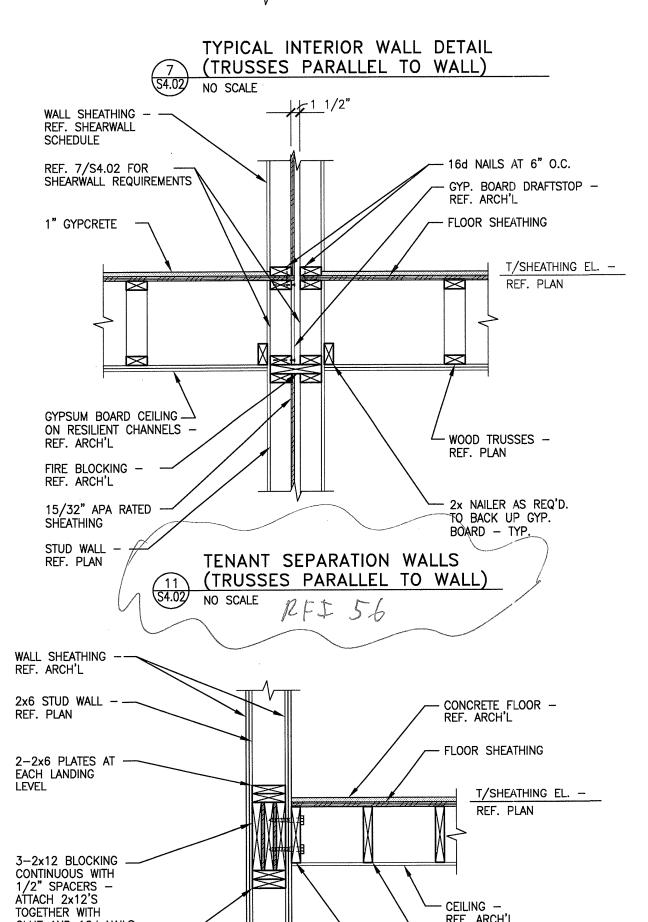

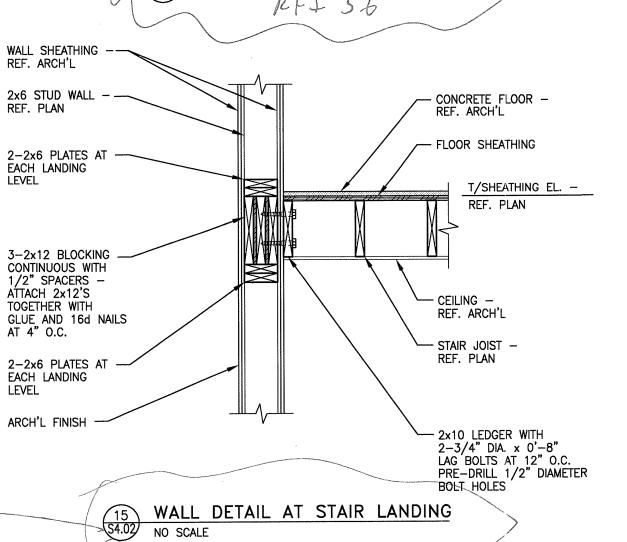

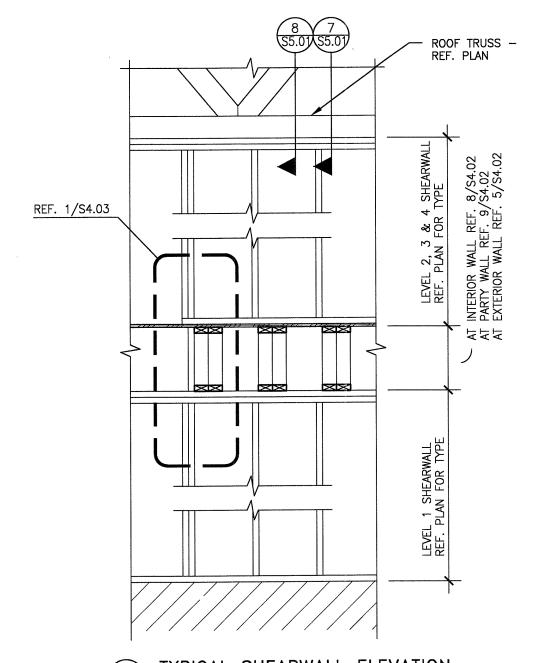

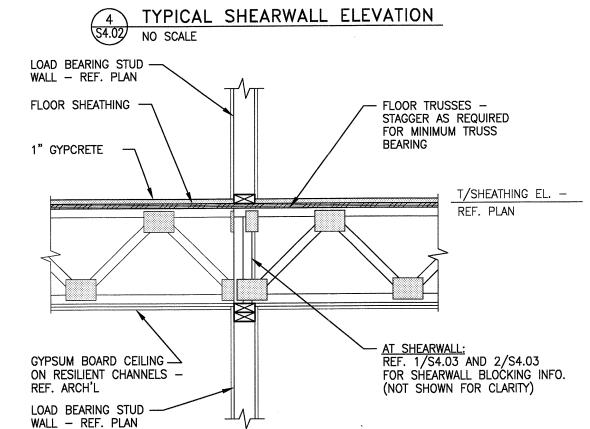

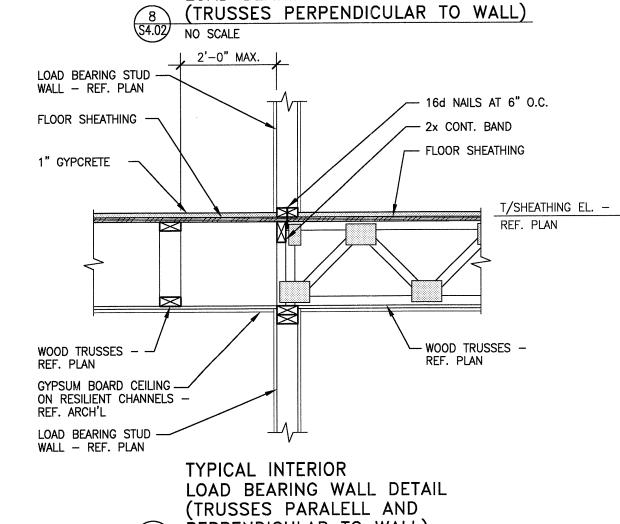


TYPICAL INTERIOR

LOAD BEARING WALL DETAIL

PERPENDICULAR TO WALL)

S4.02 NO SCALE

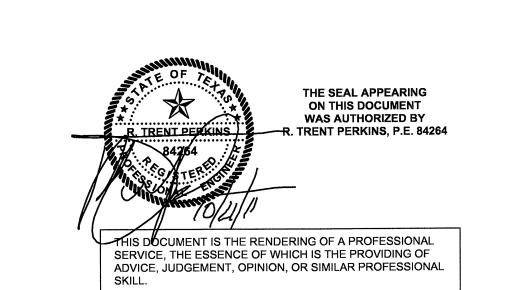



Suite 1055 Dallas, Texas *75243* Tel 214.221.2220 Fax 214.221.2252 Project No. 39155 F-1479 Registration No.

REVISIONS

ADDISON

architects 4144 N. Central Expy., Suite 855 Dallas, TX 75204 214.520.8878 bgoarchitects.com

DATE 08-05-2011

PROJECT

11129 SHEET NUMBER

S4.02

2-2x PLATE -