





- REFER TO SHEETS S1.01 S1.03 FOR ADDITIONAL INFORMATION INCLUDING CONVENTIONAL REINFORCEMENT REQUIREMENTS.
- 2. REFER TO SHEETS \$3.01 \$3.05 FOR TYPICAL POST-TENSIONED SLAB DETAILS.
- 3. TENDON DRAPES ARE MEASURED UPWARD FROM THE BOTTOM OF THE CONCRETE SOFFIT TO THE CENTER OF GRAVITY (CG) OF THE TENDON.
- 4. TENDON PROFILES SHALL CONFORM TO CONTROL POINTS SHOWN ON THE STRUCTURAL DRAWINGS AND SHALL BE IN APPROXIMATE PARABOLIC DRAPE BETWEEN SUPPORTS, POINTS OF INFLECTION, AND LOW POINTS.
- 5. BANDED TENDON FORCES SHOWN AS F=___K ON PLAN, INDICATE THE EFFECTIVE POST—TENSION FORCE IN KIPS (AFTER ALL POST—TENSIONING LOSSES HAVE OCCURRED) TO BE PLACED SYMMETRICALLY ABOUT THE CENTERLINE, EXCEPT AT SLAB EDGE CONDITIONS.
- 6. UNIFORMLY SPACED TENDON FORCES SHOWN AS F=___K/FT ON PLAN INDICATE
 THE EFFECTIVE POST-TENSION FORCE IN KIPS PER FOOT OF SLAB (AFTER
 ALL POST-TENSIONING LOSSES HAVE OCCURRED). SPACING OF UNIFORM TENDONS OR GROUPS OF TENDONS SHALL NOT EXCEED EIGHT TIMES THE SLAB THICKNESS, FIVE FEET, OR SPACINGS NOTED ON PLAN. PROVIDE A MINIMUM OF TWO POST-TENSIONING TENDONS THROUGH THE CRITICAL SHEAR SECTION AT THE COLUMN AS SHOWN IN THE TYPICAL DETAILS.
- 7. RECOMMENDED PLACEMENT SEQUENCE OF TENDONS:
- A. PLACE TENDON GROUP AT COLUMN CENTERLINE FOR UNIFORMLY SPACED TENDONS FIRST.
- B. PLACE BANDED TENDONS SECOND.
- C. PLACE REMAINING UNIFORMLY SPACED TENDONS.
- 8. SLIGHT HORIZONTAL PLAN DEVIATIONS OF SLAB TENDONS ARE PERMISSIBLE WHEN REQUIRE TO AVOID OPENINGS, INSERTS, AND DOWELS WHICH ARE SPECIFICALLY LOCATED. THE DEVIATION SHALL HAVE A RADIUS OF CURVATURE OF NO LESS THAN TWENTY—ONE FEET OR A HORIZONTAL DEVIATION OF NO MORE THAN 1 TO 12. REFER TO TYPICAL DETAILS FOR ADDITIONAL REINFORCEMENT REQUIRED AT CURVED TENDONS.
- 9. UNIFORMLY SPACED TENDONS SHALL BE STRESSED BEFORE BANDED TENDONS.


LEGEND


- = TENDON LIVE END (STRESS END)
- = TENDON DEAD LOAD
- = TENDON DRAPE

XREF SHEETS:

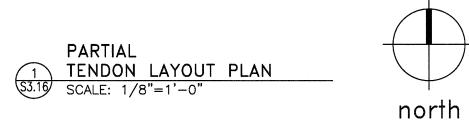

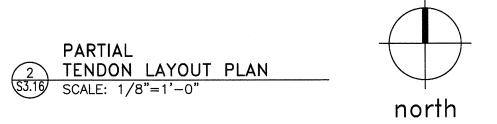

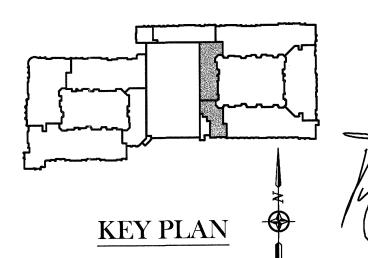

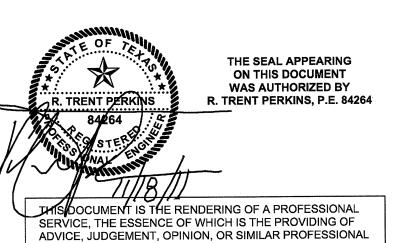



Registration No.

PARKIN - PERKINS - OLSEN CONSULTING ENGINEERING, INC. 9330 LBJ Freeway Suite 1055 75243 Dallas, Texas Tel 214.221.2220 Fax 214.221.2252 39155 Project No.

F-1479

REVISIONS SLAB ON VOID 11/18/2011

BBGO architects 4144 N. Central Expy., Suite 855 Dallas, TX 75204 214.520.8878

bgoarchitects.com

08-05-2011

PROJECT

11129

SHEET NUMBER