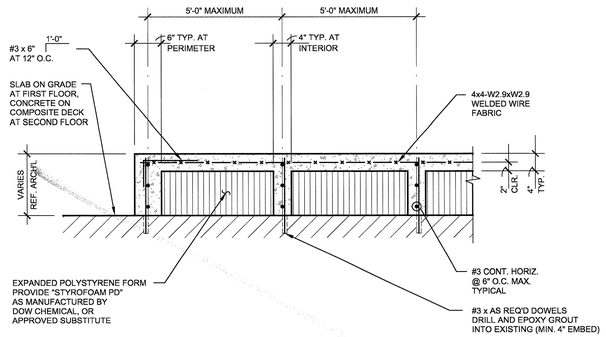


NOTE: PLACE BUILT-UP SLAB RIBS PERPENDICULAR TO STEEL BEAMS.

1 S3.05 **TYPICAL BUILT-UP SLAB DETAIL**
NO SCALE

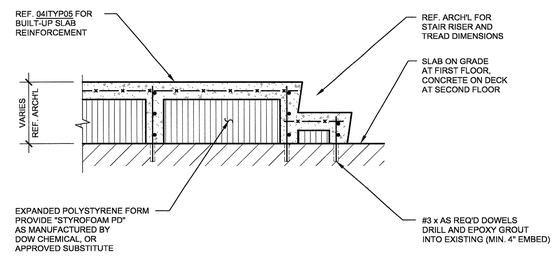


2 S3.05 **TYPICAL BUILT-UP STAIR DETAIL**
NO SCALE

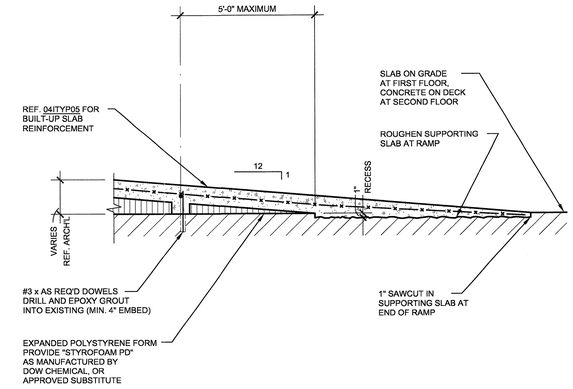


3 S3.05 **TYPICAL BUILT-UP RAMP DETAIL**
NO SCALE

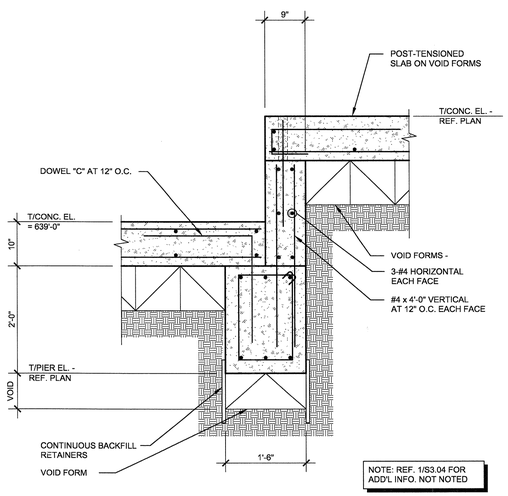


NOTE: REF. 1/S3.04 FOR ADD'L INFO. NOT NOTED

4 S3.05 **SECTION**
NO SCALE

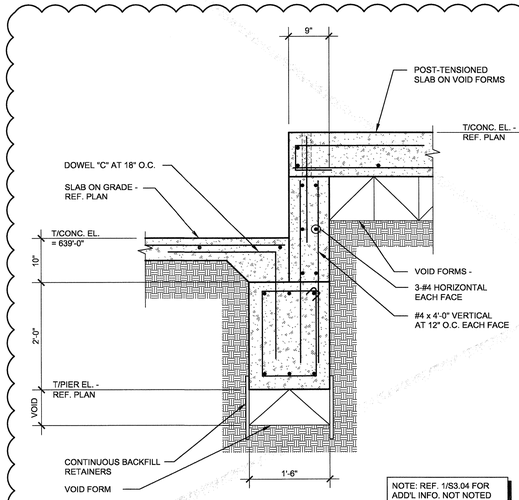


NOTE: REF. 1/S3.04 FOR ADD'L INFO. NOT NOTED

2 5 S3.05 **SECTION**
NO SCALE

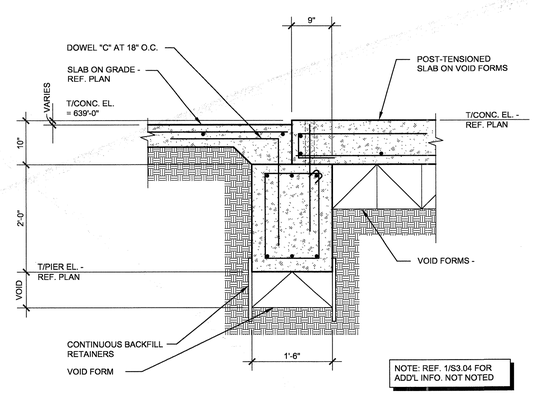


NOTE: REF. 1/S3.04 FOR ADD'L INFO. NOT NOTED

2 6 S3.05 **SECTION**
NO SCALE

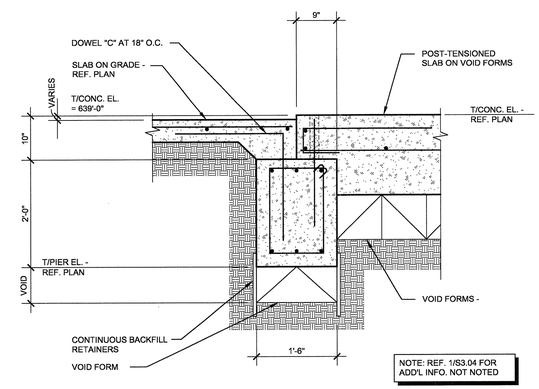


NOTE: REF. 1/S3.04 FOR ADD'L INFO. NOT NOTED

2 7 S3.05 **SECTION**
NO SCALE

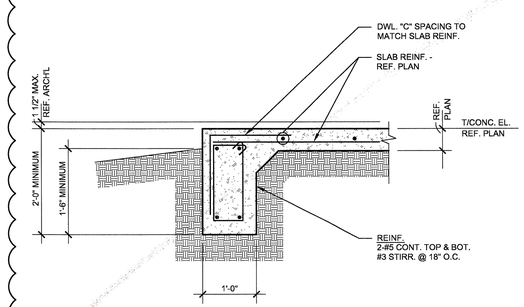


2 8 S3.05 **SECTION**
NO SCALE

THE SEAL APPEARING ON THIS DOCUMENT WAS AUTHORIZED BY R. TRENT PERKINS, P.E. 84264

THIS DOCUMENT IS THE RENDERING OF A PROFESSIONAL SERVICE, THE ESSENCE OF WHICH IS THE PROVIDING OF ADVICE, JUDGEMENT, OPINION, OR SIMILAR PROFESSIONAL SKILL.


PARKIN - PERKINS - OLSEN
CONSULTING ENGINEERING, INC.
9330 LBJ Freeway Suite 1055
Dallas, Texas 75243
Tel 214.221.2220 Fax 214.221.2252
Project No. 39155
Registration No. F-1479


REVISIONS
2 SLAB ON VOID FOUNDATION 11/18/2011
3 SLAB ON GRADE FOR METER BANK 12/21/2011
4

# KELLER SPRINGS LOFTS
LOFT APARTMENTS IN ADDISON, TEXAS

CONSTRUCTION ISSUE
10-17-2011


BGO architects
4144 N. Central Expy.,
Suite 855
Dallas, TX 75204
214.520.8878
bgoarchitects.com


DATE
08-05-2011

PROJECT
11129

SHEET NUMBER
4
S3.05