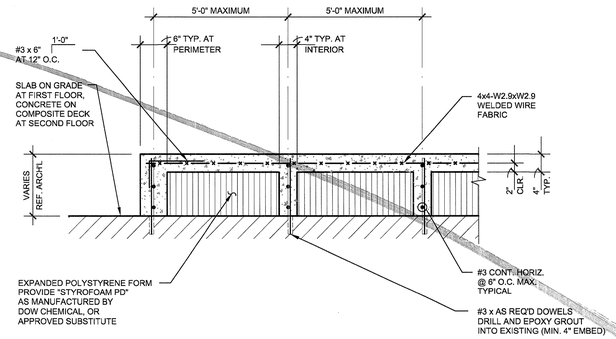

NOTE: PLACE BUILT-UP SLAB RIBS PERPENDICULAR TO STEEL BEAMS.

1 S3.05 **TYPICAL BUILT-UP SLAB DETAIL**
NO SCALE

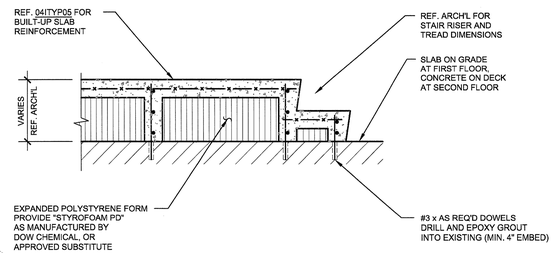

2 S3.05 **TYPICAL BUILT-UP STAIR DETAIL**
NO SCALE

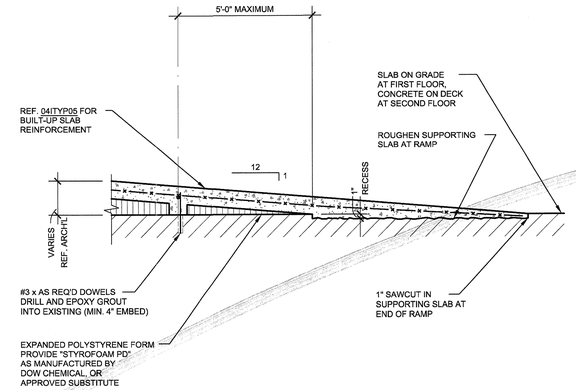

3 S3.05 **TYPICAL BUILT-UP RAMP DETAIL**
NO SCALE

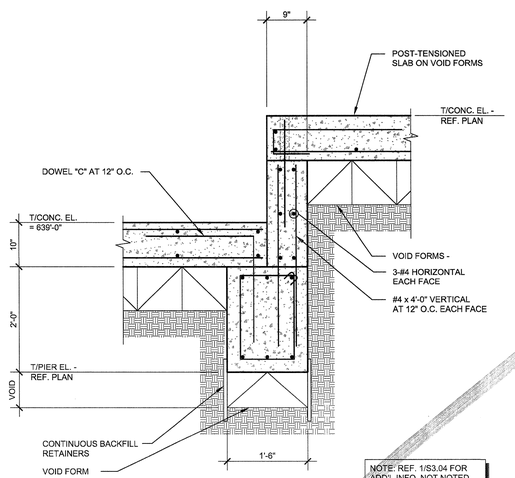

NOTE: REF. 1/S3.04 FOR ADD'L INFO. NOT NOTED

4 S3.05 **SECTION**
NO SCALE

THE SEAL APPEARING ON THIS DOCUMENT WAS AUTHORIZED BY R. TRENT PERKINS, P.E. 84264

THIS DOCUMENT IS THE RENDERING OF A PROFESSIONAL SERVICE, THE ESSENCE OF WHICH IS THE PROVIDING OF ADVICE, JUDGEMENT, OPINION, OR SIMILAR PROFESSIONAL SKILL.

PPO
PARKIN - PERKINS - OLSEN
CONSULTING ENGINEERING, INC.
9330 LBJ Freeway Suite 1055
Dallas, Texas 75243
Tel 214.221.2220 Fax 214.221.2252
Project No. 39155
Registration No. F-1479

REVISIONS
1 SLAB ON VOID FOUNDATION 11/18/2011

KELLER SPRINGS LOFTS
LOFT APARTMENTS IN ADDISON, TEXAS

CONSTRUCTION ISSUE
10-17-2011

BGO architects
4144 N. Central Expy., Suite 855
Dallas, TX 75204
214.520.8878
bgoarchitects.com

DATE
08-05-2011

PROJECT
11129

SHEET NUMBER
S3.05