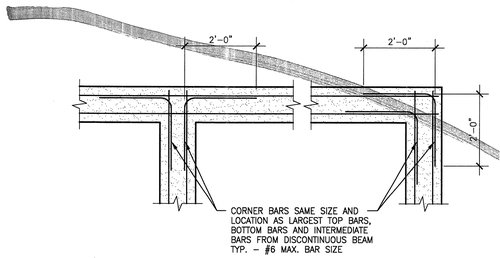

TYPICAL CORNER BARS AT WALL, BEAM AND FOOTING INTERSECTION DETAIL

1 S3.03 NO SCALE

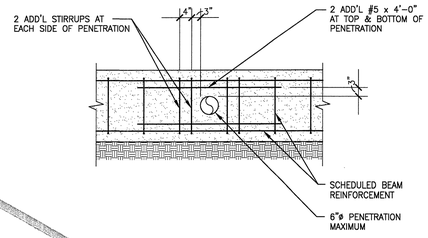

TYPICAL GRADE BEAM PENETRATION DETAIL

2 S3.03 NO SCALE

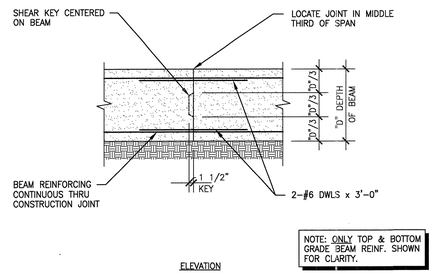

NOTE: ONLY TOP & BOTTOM GRADE BEAM REINF. SHOWN FOR CLARITY.

TYPICAL GRADE BEAM CONSTRUCTION JOINT DETAIL

3 S3.03 SCALE: 1/2"=1'-0"

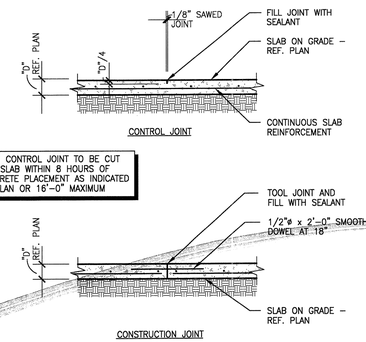

TYPICAL JOINTS IN SLAB–ON–GRADE DETAIL

4 S3.03 NO SCALE

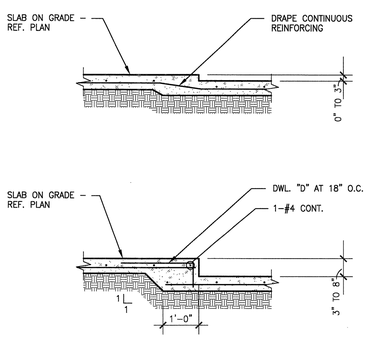

TYPICAL DROP IN SLAB–ON–GRADE DETAILS

5 S3.03 NO SCALE

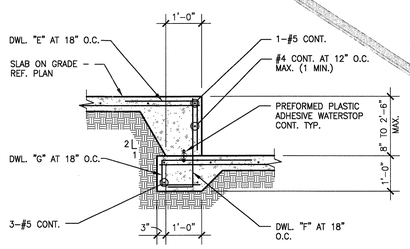

TYPICAL DROP IN SLAB–ON–GRADE DETAIL

6 S3.03 NO SCALE

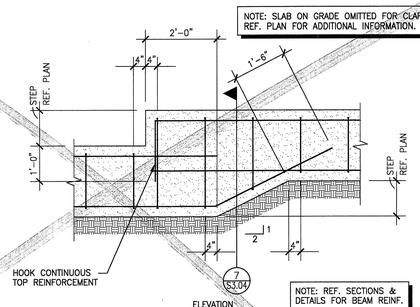

NOTE: REF. SECTIONS & DETAILS FOR BEAM REINF.

TYPICAL STEP IN TOP AND BOTTOM OF GRADE BEAM DETAIL

7 S3.03 NO SCALE

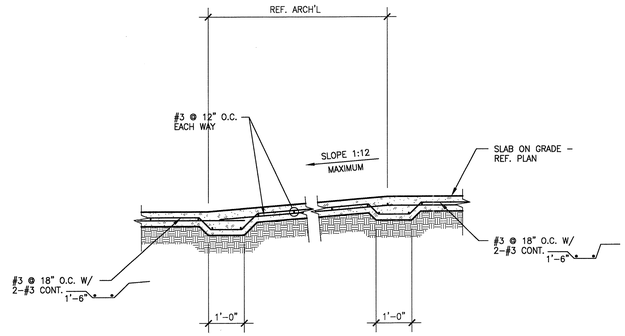

SECTION

8 S3.03 NO SCALE

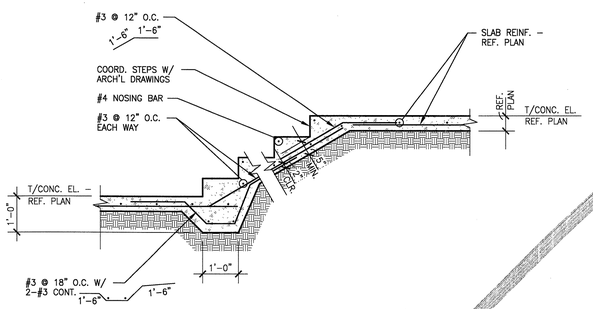

SECTION

9 S3.03 SCALE: 1/2"=1'-0"

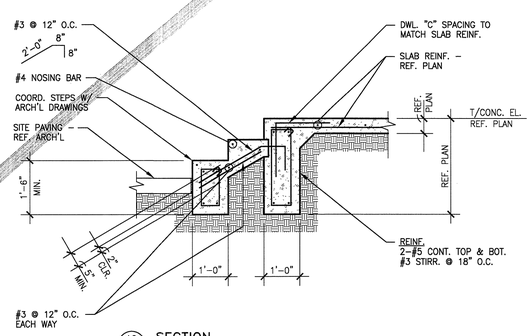

SECTION

10 S3.03 SCALE: 1/2"=1'-0"

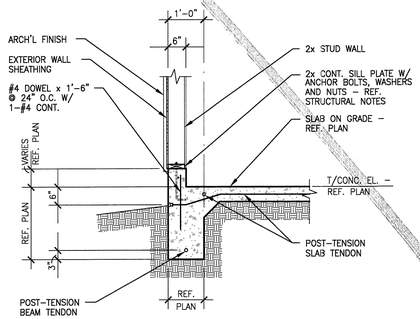

SECTION

11 S3.03 SCALE: 1/2"=1'-0"

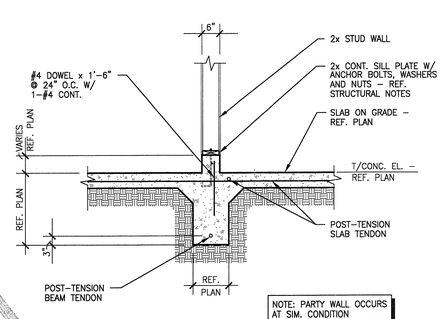

SECTION

12 S3.03 SCALE: 1/2"=1'-0"

THE SEAL APPEARING ON THIS DOCUMENT WAS AUTHORIZED BY R. TRENT PERKINS, P.E. 84264

THIS DOCUMENT IS THE RENDERING OF A PROFESSIONAL SERVICE, THE ESSENCE OF WHICH IS THE PROVIDING OF ADVICE, JUDGEMENT, OPINION, OR SIMILAR PROFESSIONAL SKILL.

PARKIN · PERKINS · OLSEN
CONSULTING ENGINEERING, INC.
9330 LBJ Freeway Suite 1055
Dallas, Texas 75243
Tel 214.221.2220 Fax 214.221.2252
Project No. 39155
Registration No. F-1479

REVISIONS

KELLER SPRINGS LOFTS

LOFT APARTMENTS IN ADDISON, TEXAS

CONSTRUCTION ISSUE
10-17-2011

BGO architects
4144 N. Central Expy., Suite 855
Dallas, TX 75204
214.520.8878
bgoarchitects.com

DATE
08-05-2011

PROJECT
11129

SHEET NUMBER
S3.03