



UNIT B2
ALTERNATE 2

FLOOR FRAMING PLAN


S2.05 SCALE: 1/8"=1'-0"

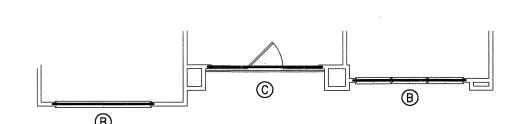

NOTE: REF. 2/S2.05 FOR ADD'L INFO. NOT NOTED UNIT B2 ALTERNATE 1 5 FLOOR FRAMING PLAN
S2.05 SCALE: 1/8"=1'-0"

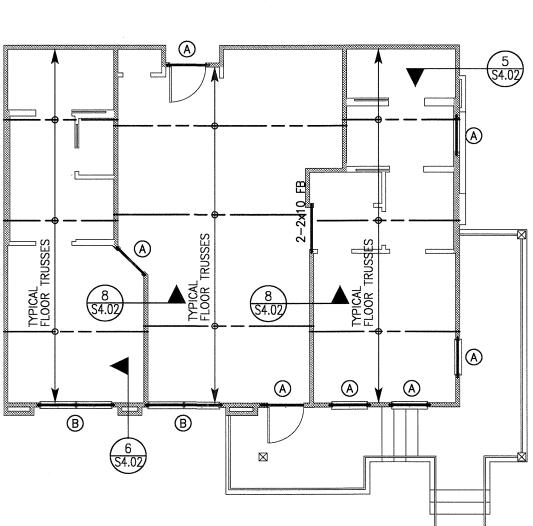


- SLOPED BALCONY FLOOR TRUSSES - SLOPED BALCONY FLOOR TRUSSES UNIT B2 PARTIAL 1

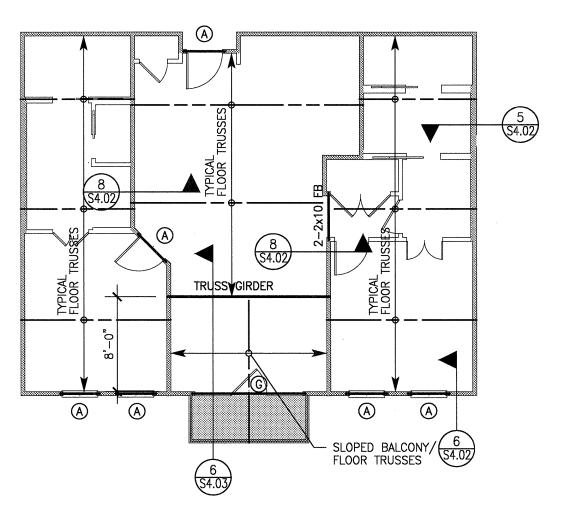

3 FLOOR FRAMING PLAN S2.05 SCALE: 1/8"=1'-0"

UNIT B2 2 FLOOR FRAMING PLAN S2.05 SCALE: 1/8"=1'-0"

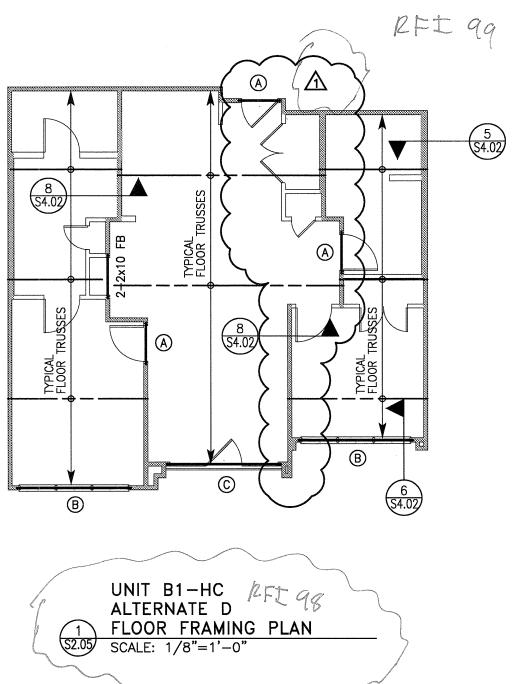

NOTE: FRAMING PLAN(S) ARE ONLY FOR TRUSS SUPPORT—STRUCTURE AND GENERAL LAYOUT OF FRAMING. TRUSS MANUFACTURER IS RESPONSIBLE FOR ACTUAL TRUSS LAYOUT AND PROFILES AND SHALL SUBMIT SHOP DRAWINGS OF ALL TRUSS LAYOUT AND PROFILES PER THE SPECIFICATIONS

HEADER SCHEDULE			
MARK	SIZE	STUD/COLUMN AT LEVEL 1	STUD/COLUMN AT LEVELS 2,3,4
A	2-2x8	3-2x STUDS	2-2x STUDS
B	2-2x10	3-2x STUDS	2-2x STUDS
©	2-2x12	3-2x STUDS	2-2x STUDS
(D)	3-2x8	4-2x STUDS	3-2x STUDS
Ē	3-2x10	4-2x STUDS	3-2x STUDS
Ē	3-2x12	4-2x STUDS	3-2x STUDS
G	3 1/2"x9 1/4" PSL	4-2x STUDS	3-2x STUDS
Θ	3 1/2"x11 1/4" PSL	5-2x STUDS	4-2x STUDS
<u> </u>	3 1/2"x14" PSL	5-2x STUDS	4-2x STUDS
(K)	3 1/2"x16" PSL	6-2x STUDS	5-2x STUDS

- 1. INDICATES NUMBER OF FULL HEIGHT STUDS REQUIRED AT EACH END OF HEADER.
- 2. REF. TYPICAL WALL OPENING ELEVATIONS FOR NUMBER OF REQUIRED TRIM STUDS.

SCHEDULE NO SCALE

PLAN NOTES:

- 1. REFER TO SHEETS \$1.01 THRU \$1.03 FOR STRUCTURAL NOTES AND SCHEDULES.
- 2. REFER TO SHEETS S4.01 THRU S4.04 FOR TYPICAL FRAMING DETAILS.
- T/SHEATHING = TOP OF FLOOR SHEATHING ELEVATION. REFER TO ARCHITECTURAL DRAWINGS FOR T/SHEATHING ELEVATIONS. ALL LEVELS TO BE CONSTRUCTED WITH 9'-1 PLATE HEIGHTS, UNLESS NOTED OTHERWISE.
- 4. COORDINATE FLOOR DEPRESSIONS, DROPS AND DIMENSIONS WITH ARCHITECTURAL DRAWINGS.
- ALL HORIZONTAL FRAMING LUMBER SHALL BE KILN-DRIED #2 SOUTHERN PINE, UNLESS NOTED OTHERWISE. ALL OTHER LUMBER SPECIES AND GRADES MUST BE APPROVED IN
- 6. TYPICAL FLOOR TRUSSES SHALL BE 18" DEEP AT 24" O.C., UNLESS NOTED OTHERWISE. PROVIDE TRUSS BRIDGING IN ACCORDANCE WITH THE MANUFACTURER'S RECOMMENDATIONS.
- BALCONY TRUSSES SHALL BE 15" DEEP AT 24" O.C., UNLESS NOTED OTHERWISE. PROVIDE TRUSS BRIDGING IN ACCORDANCE WITH THE MANUFACTURER'S RECOMMENDATIONS.
- 8. SLOPED BALCONY TRUSSES SHALL BE AT 24" O.C. WITH A MINIMUM DEPTH OF 15" AT THE EXTERIOR AND SHALL HAVE A SLOPED TOP CHORD, UNLESS NOTED OTHERWISE. REFER TO SECTIONS AND DETAILS FOR ADDITIONAL INFORMATION. PROVIDE TRUSS BRIDGING IN ACCORDANCE WITH THE MANUFACTURER'S RECOMMENDATIONS.
- ALL WOOD BEAMS ARE LOAD BEARING HEADERS, UNLESS NOTED OTHERWISE.
 (DB = DROP BEAM, FB = FLUSH BEAM). REFER TO SCHEDULES FOR SUPPORT REQUIREMENTS AT HEADERS AND BEAMS.
- 10. ALL WALLS SHOWN ARE BELOW THIS LEVEL, UNLESS NOTED OTHERWISE.

THIS DOCUMENT IS THE RENDERING OF A PROFESSIONAL

ADVICE, JUDGEMENT, OPINION, OR SIMILAR PROFESSIONAL

SERVICE, THE ESSENCE OF WHICH IS THE PROVIDING OF

- 11. INDICATES ASSUMED INTERIOR LOAD BEARING WALLS BELOW THIS LEVEL.
 ALL EXTERIOR WALLS SHALL BE LOAD BEARING.
- 12. XXXXXXXX INDICATES ASSUMED INTERIOR LOAD BEARING WALLS ABOVE THIS LEVEL.
- 13. INDICATES LIGHT WEIGHT CONCRETE TOPPING AT BALCONIES AND CORRIDORS.

 CONCRETE TOPPING SHALL BE REINFORCED WITH NYLON AR GLASS FIBER REINFORCEMENT

 (OR APPROVED SUBSTITUTE) IN ACCORDANCE WITH THE MANUFACTURER'S RECOMMENDATIONS.
- 14. POST/STUD COLUMNS SHALL BE CONTINUOUS TO FOUNDATION. CONNECT WOOD BEAMS AND COLUMNS WITH SIMPSON TYPE "ACE" POST CAPS OR APPROVED SUBSTITUTE.



THE SEAL APPEARING ON THIS DOCUMENT **WAS AUTHORIZED BY** _R. TRENT PERKINS, P.E. 84264

PARKIN - PERKINS - OLSEN CONSULTING ENGINEERING, INC. 9330 LBJ Freeway Suite 1055 Dallas, Texas 75243 Tel 214.221.2220 Fax 214.221.2252 Project No. F-1479 Registration No.

BBGO architects 4144 N. Central Expy., Suite 855 Dallas, TX 75204 214.520.8878

REVISIONS

TEXAS

ADDISON,

LOF


DATE

bgoarchitects.com

08-05-2011

PROJECT

SHEET NUMBER

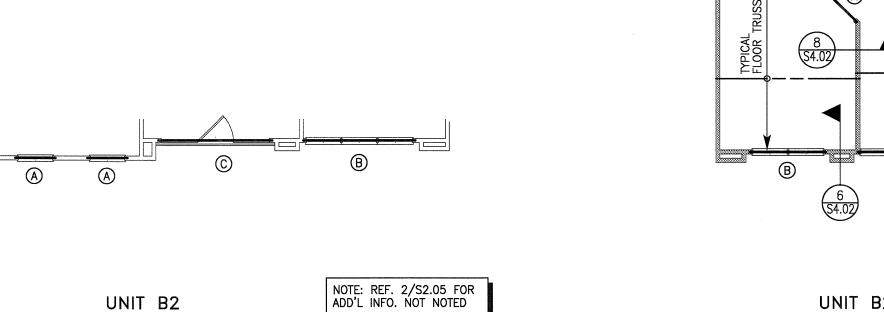

NOTE: REF. 2/S2.05 FOR ADD'L INFO. NOT NOTED

NOTE: REF. 2/S2.05 FOR ADD'L INFO. NOT NOTED

UNIT B2

 \bigcirc

UNIT B2

ALTERNATE 4

ALTERNATE 3

S2.05 SCALE: 1/8"=1'-0"

7 FLOOR FRAMING PLAN

8 FLOOR FRAMING PLAN S2.05 SCALE: 1/8"=1'-0"

ALTERNATE 5

9 FLOOR FRAMING PLAN

\$2.05 SCALE: 1/8"=1'-0"

