

Embrey Builders, LLC
 1020 N. E. Loop 410, Suite 700
 San Antonio, TX 78209
 Ph: (210) 824-8044 Fax: (210) 824-7656

RFI

To: Trent Perkins
 Parkin Perkins Olsen
 9330 LBJ Freeway, Suite 1055
 Dallas, TX 75243
 Ph: (214)221-2220 Fax: (214)221-2252

RFI #: 200
 Date: 10/22/2012
 Job: EB-02 Keller Springs Lofts
 Phone: 877-777-5115

CC: Ryan Faulds (B.G.O. Architects, Inc.)

Subject: B2 Part 4 unit Columns and patio dimensions

Drawing: 2.7A, 3.1C, 3.2C, 3.4C, S2.23, S2.33, S2.43

Spec Section:

Cost Impact: None

Schedule Impact: None

Date Required: 10/24/2012

Request: The attached RFI from Red River Framing is in reference to the B2 Part 4 unit columns and patio dimensions on 2/2.7A vs. the B2 Part 1 unit balconies above shown on 1/2.7A. The B3 Partial 1 units show the supporting walls & post the support columns from the B2 Part 4 units. Please review and advise.

Requested by: Bryan Pickler
 Embrey Partners, Ltd.

Response:

PPO takes no exception to the cantilevered truss solution proposed below.

Please ask BGO to confirm that the solution is acceptable Architecturally.

October 27, 2012

R. Trent Perkins, PE
 Parkin-Perkins-Olsen Consulting Engineering, Inc.


BGO suggests cantilevering the trusses for these B2 units in question as shown in the next pages of this PDF only if the Trusses are signed and sealed by an engineer in the state of Texas.

Ryan Faulds
 BGO architects
 October 30, 2012


Answered by:

Date:


Page 1 of 1

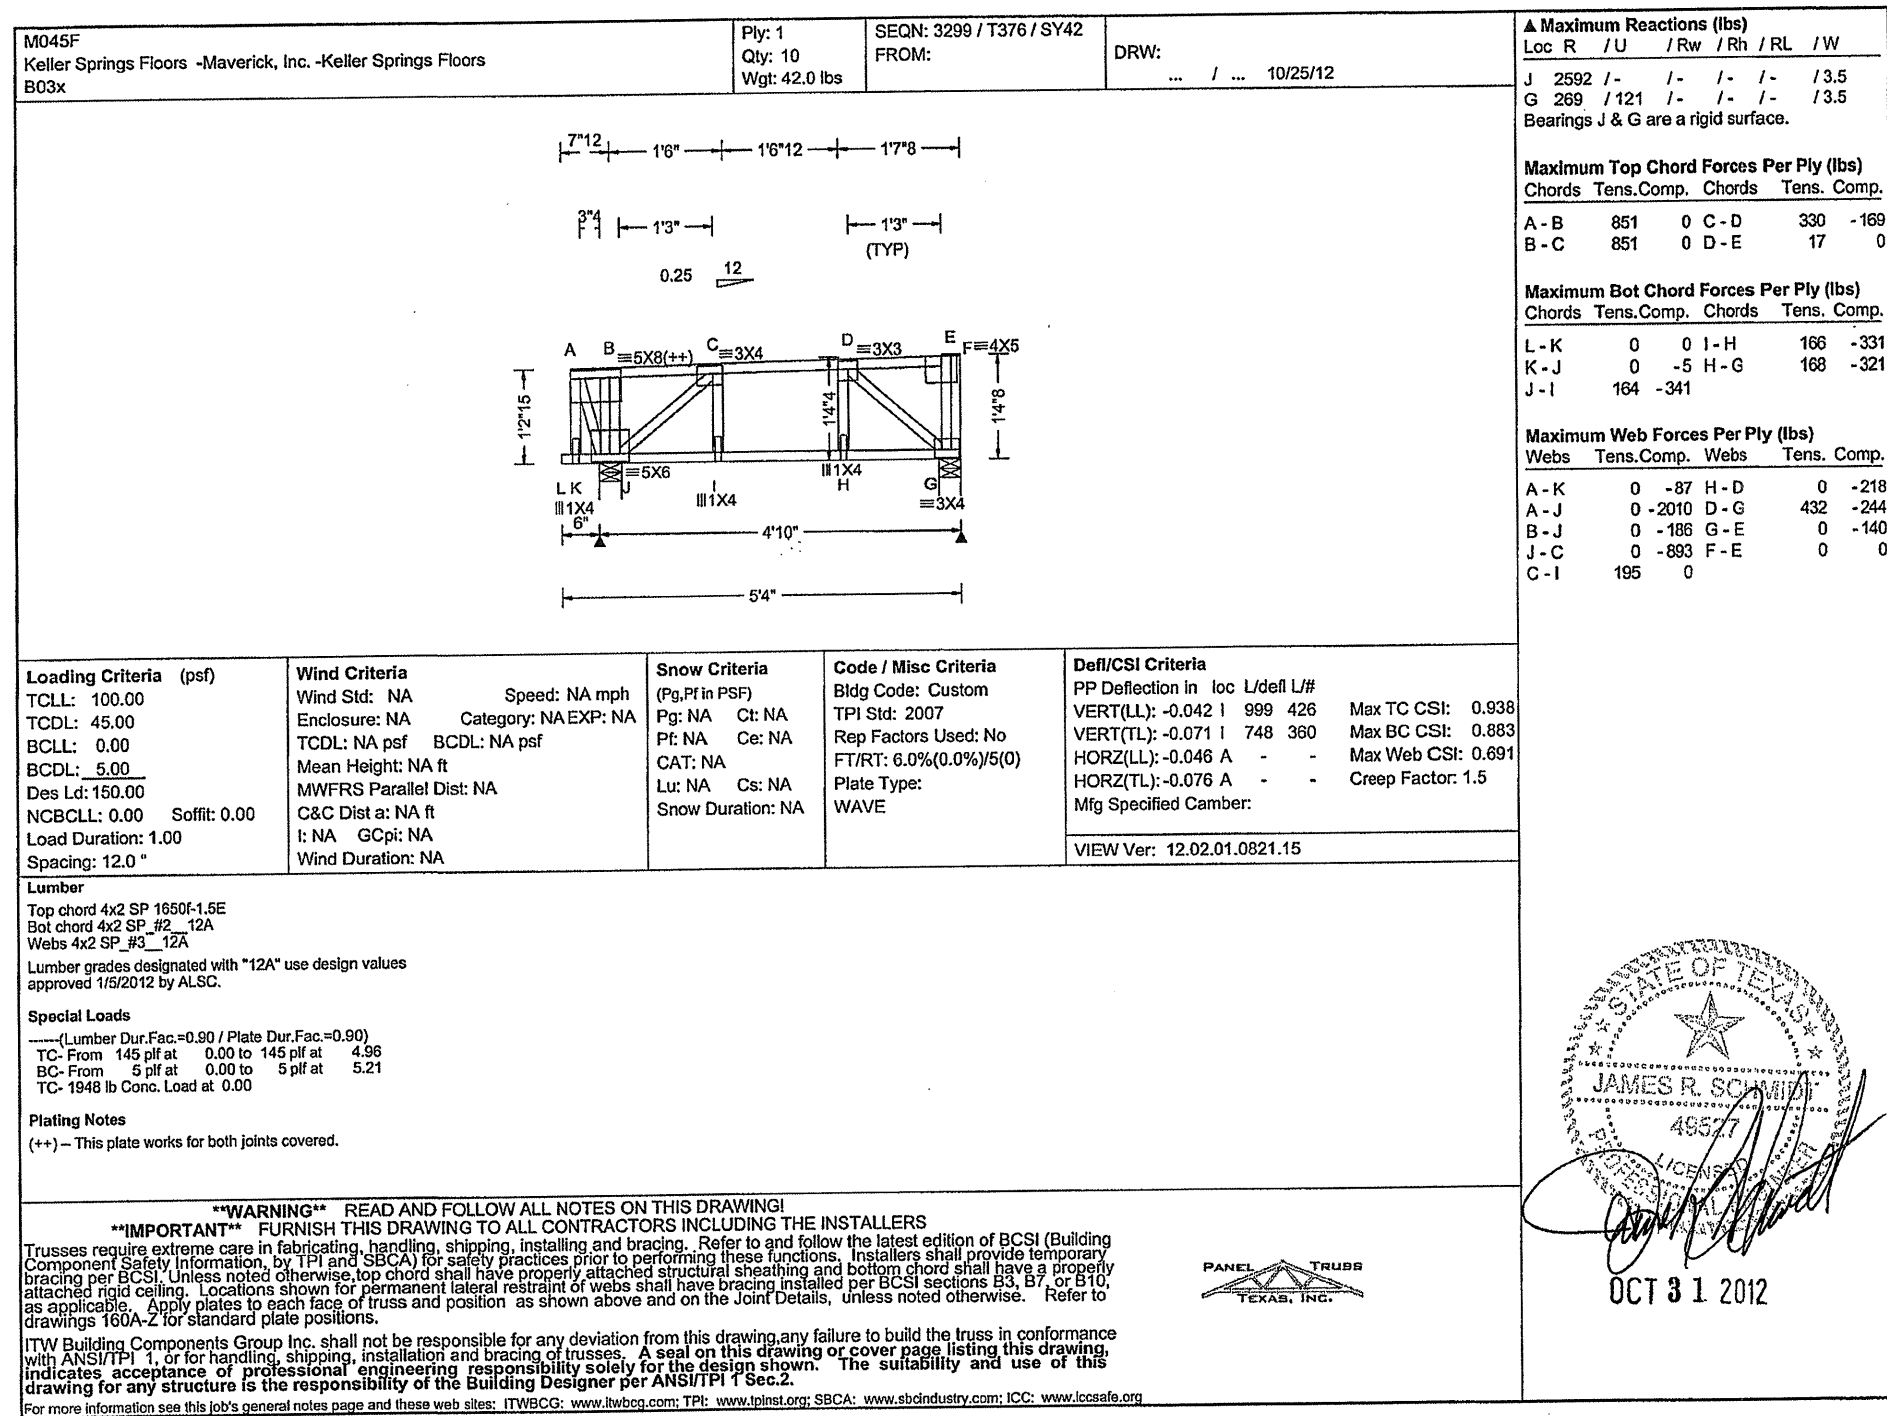



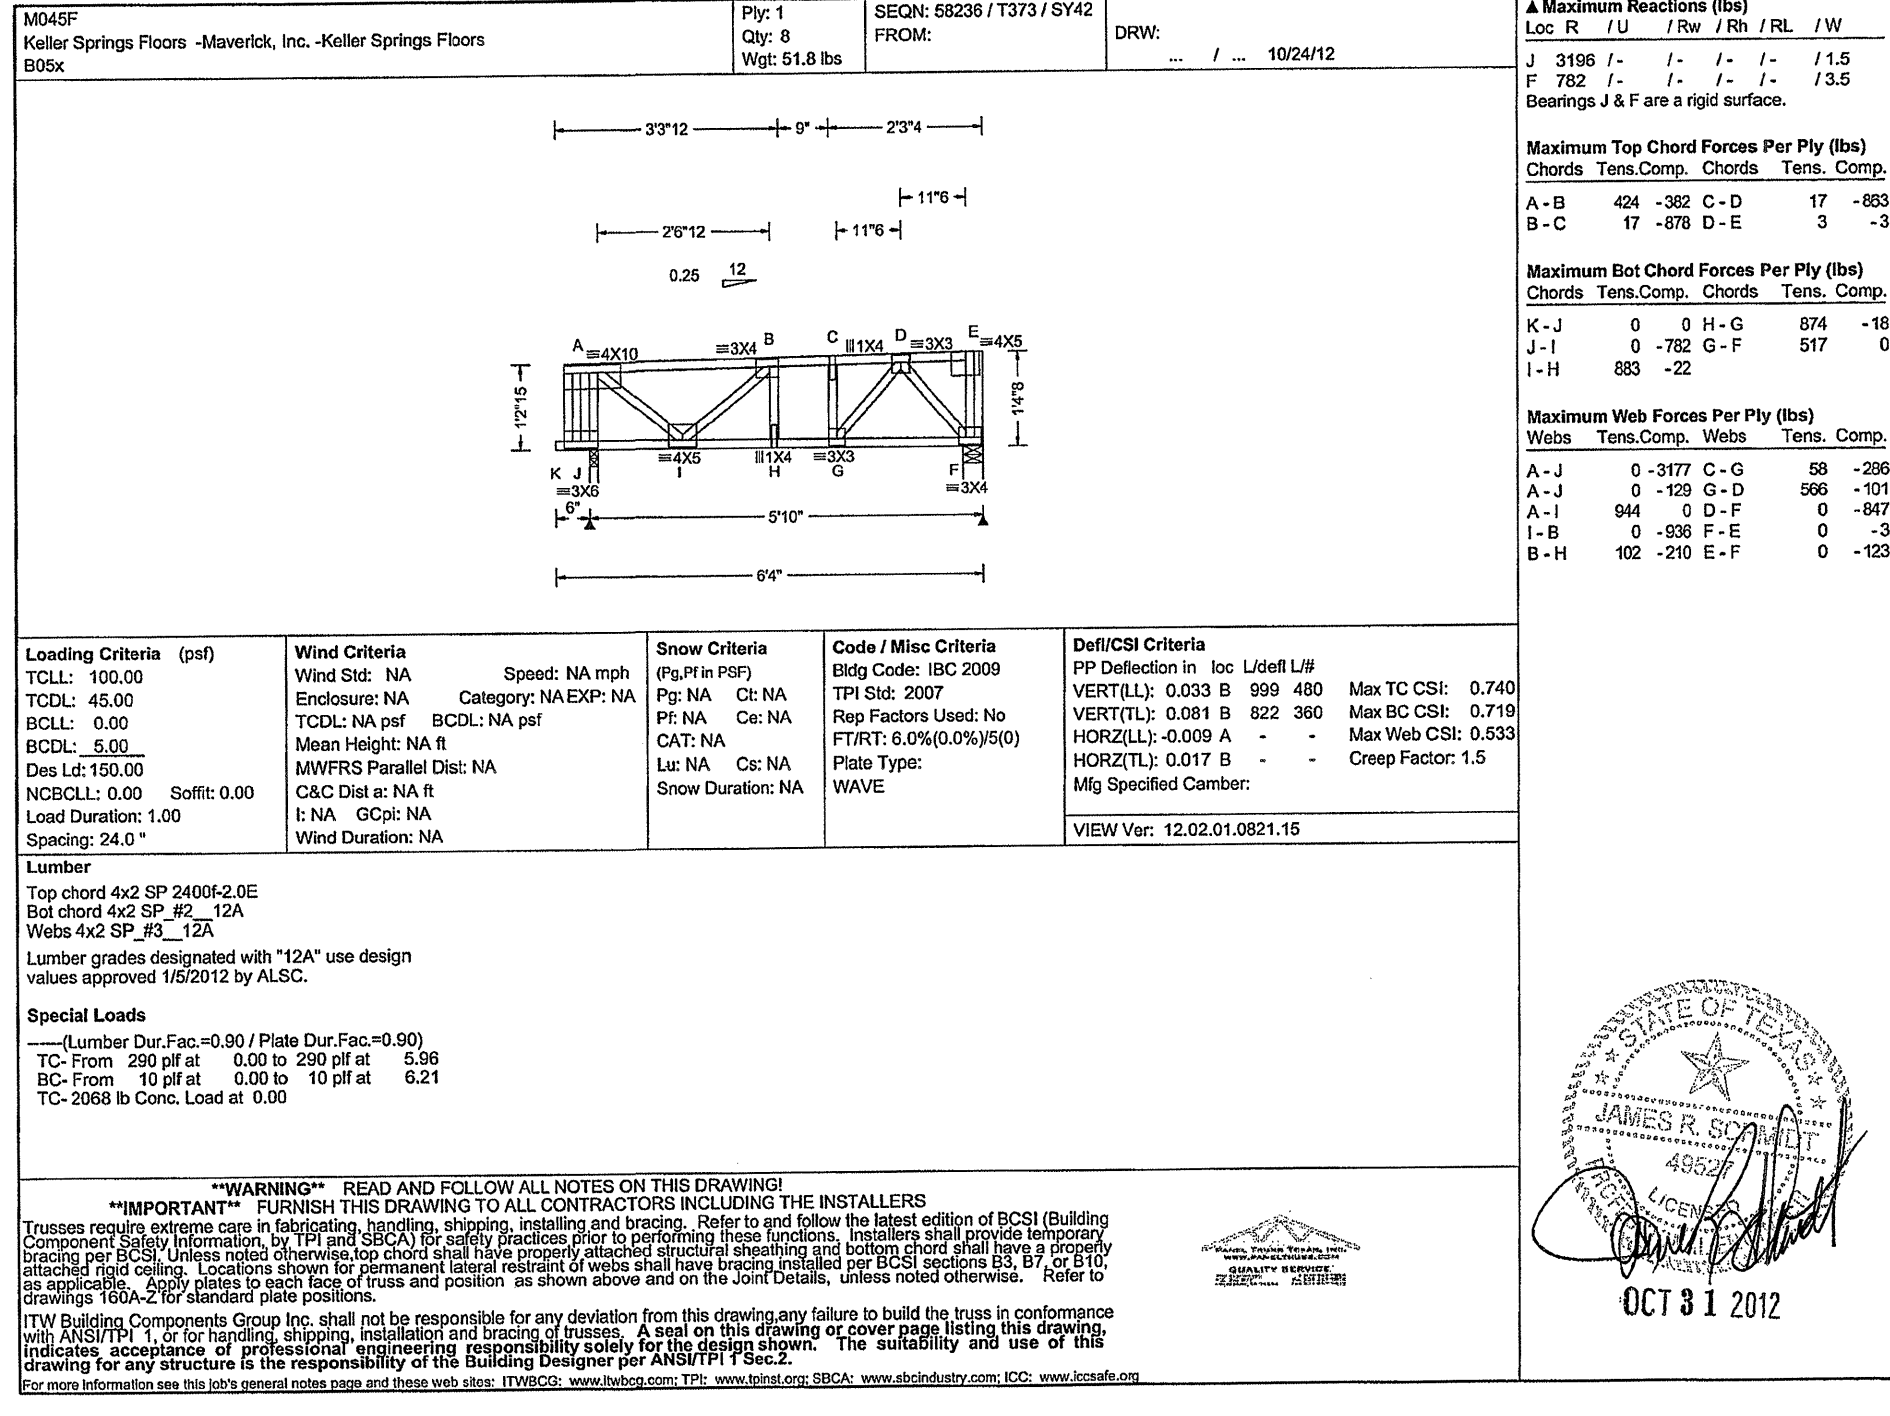


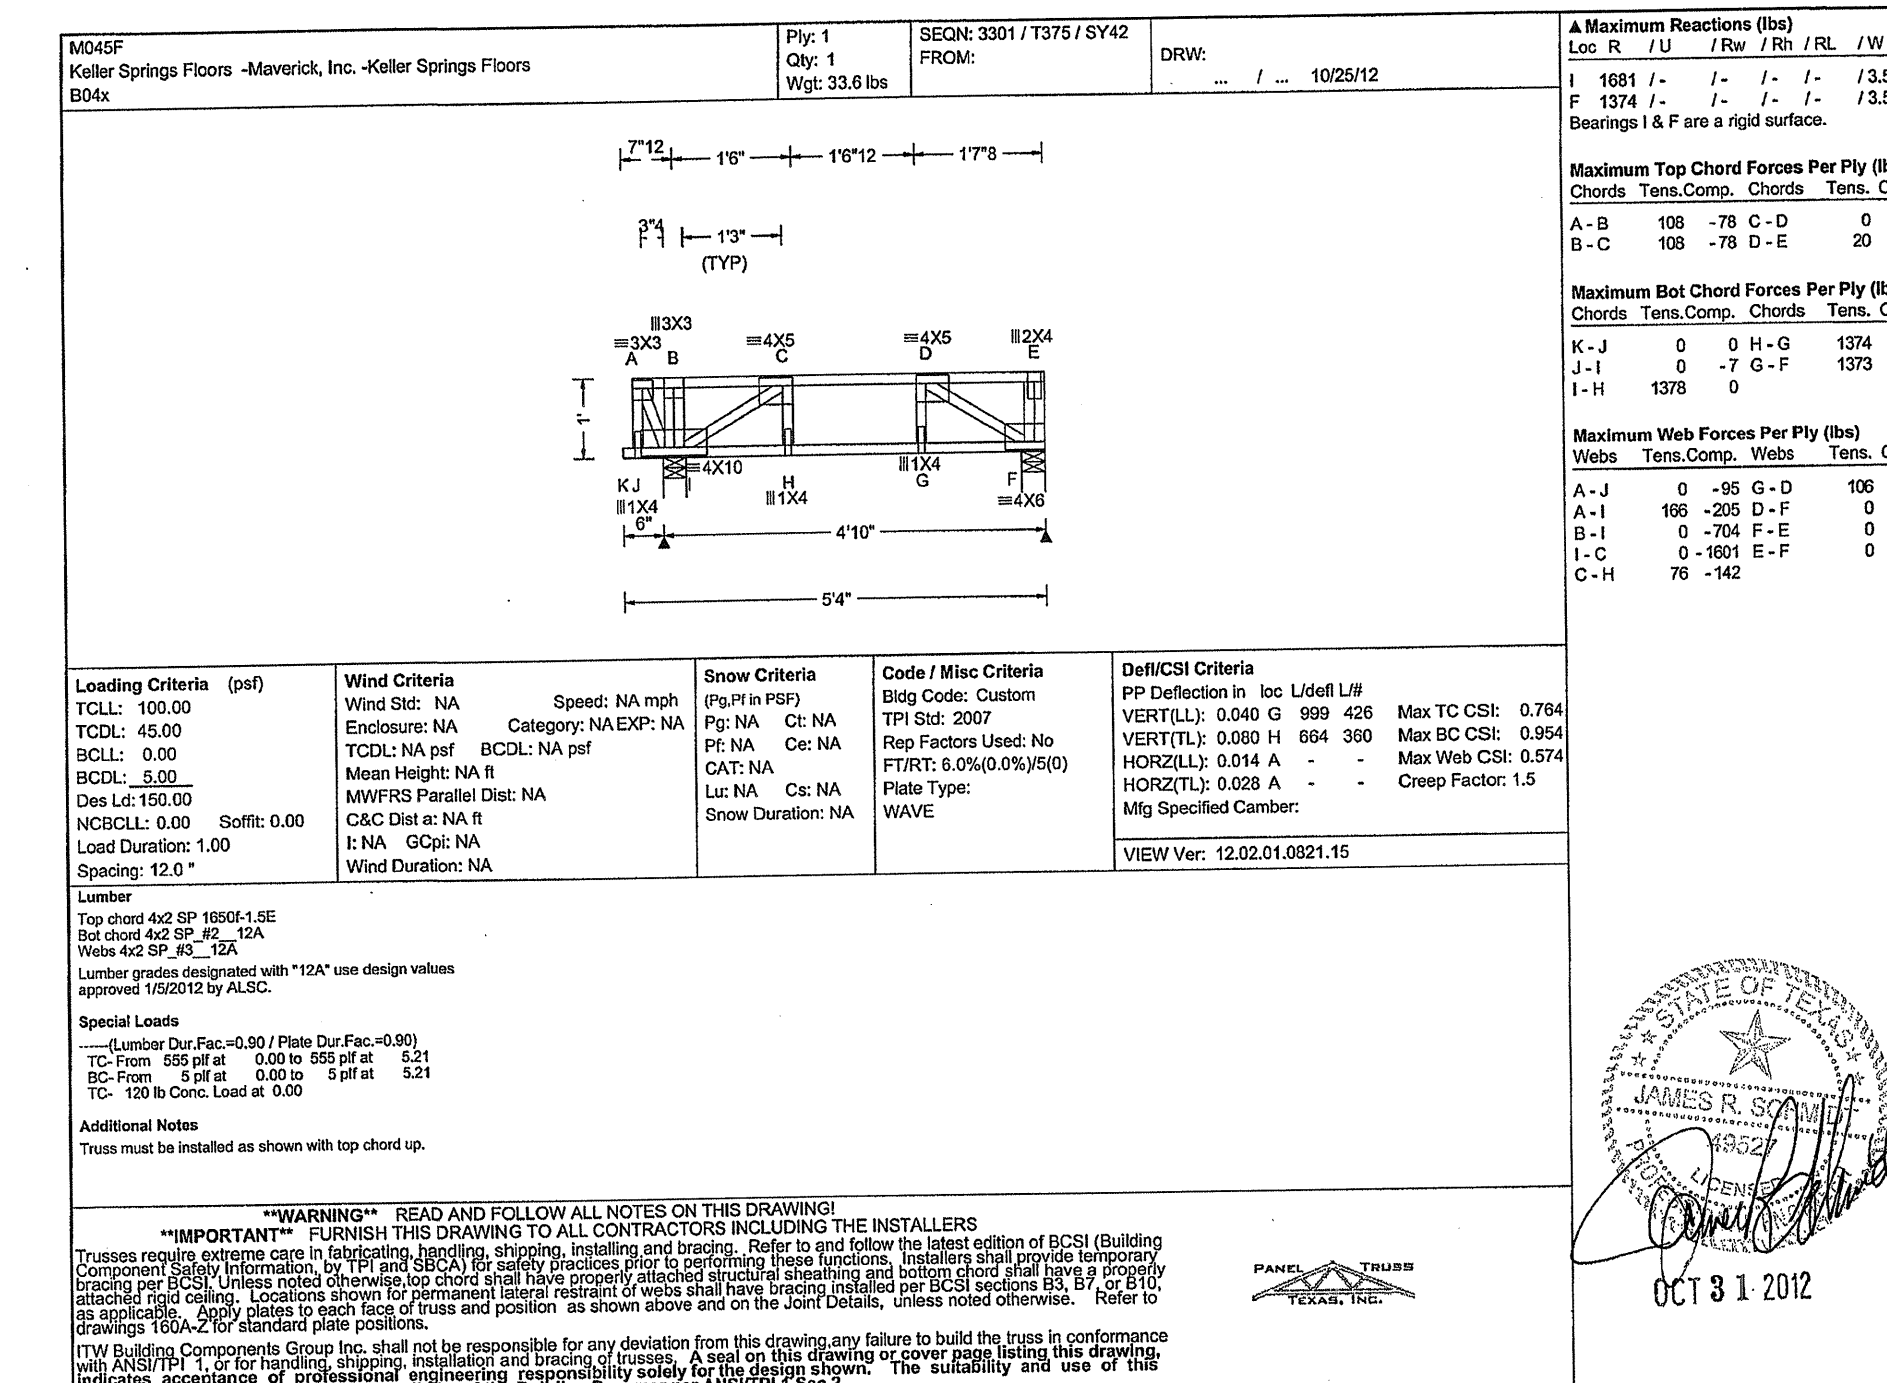


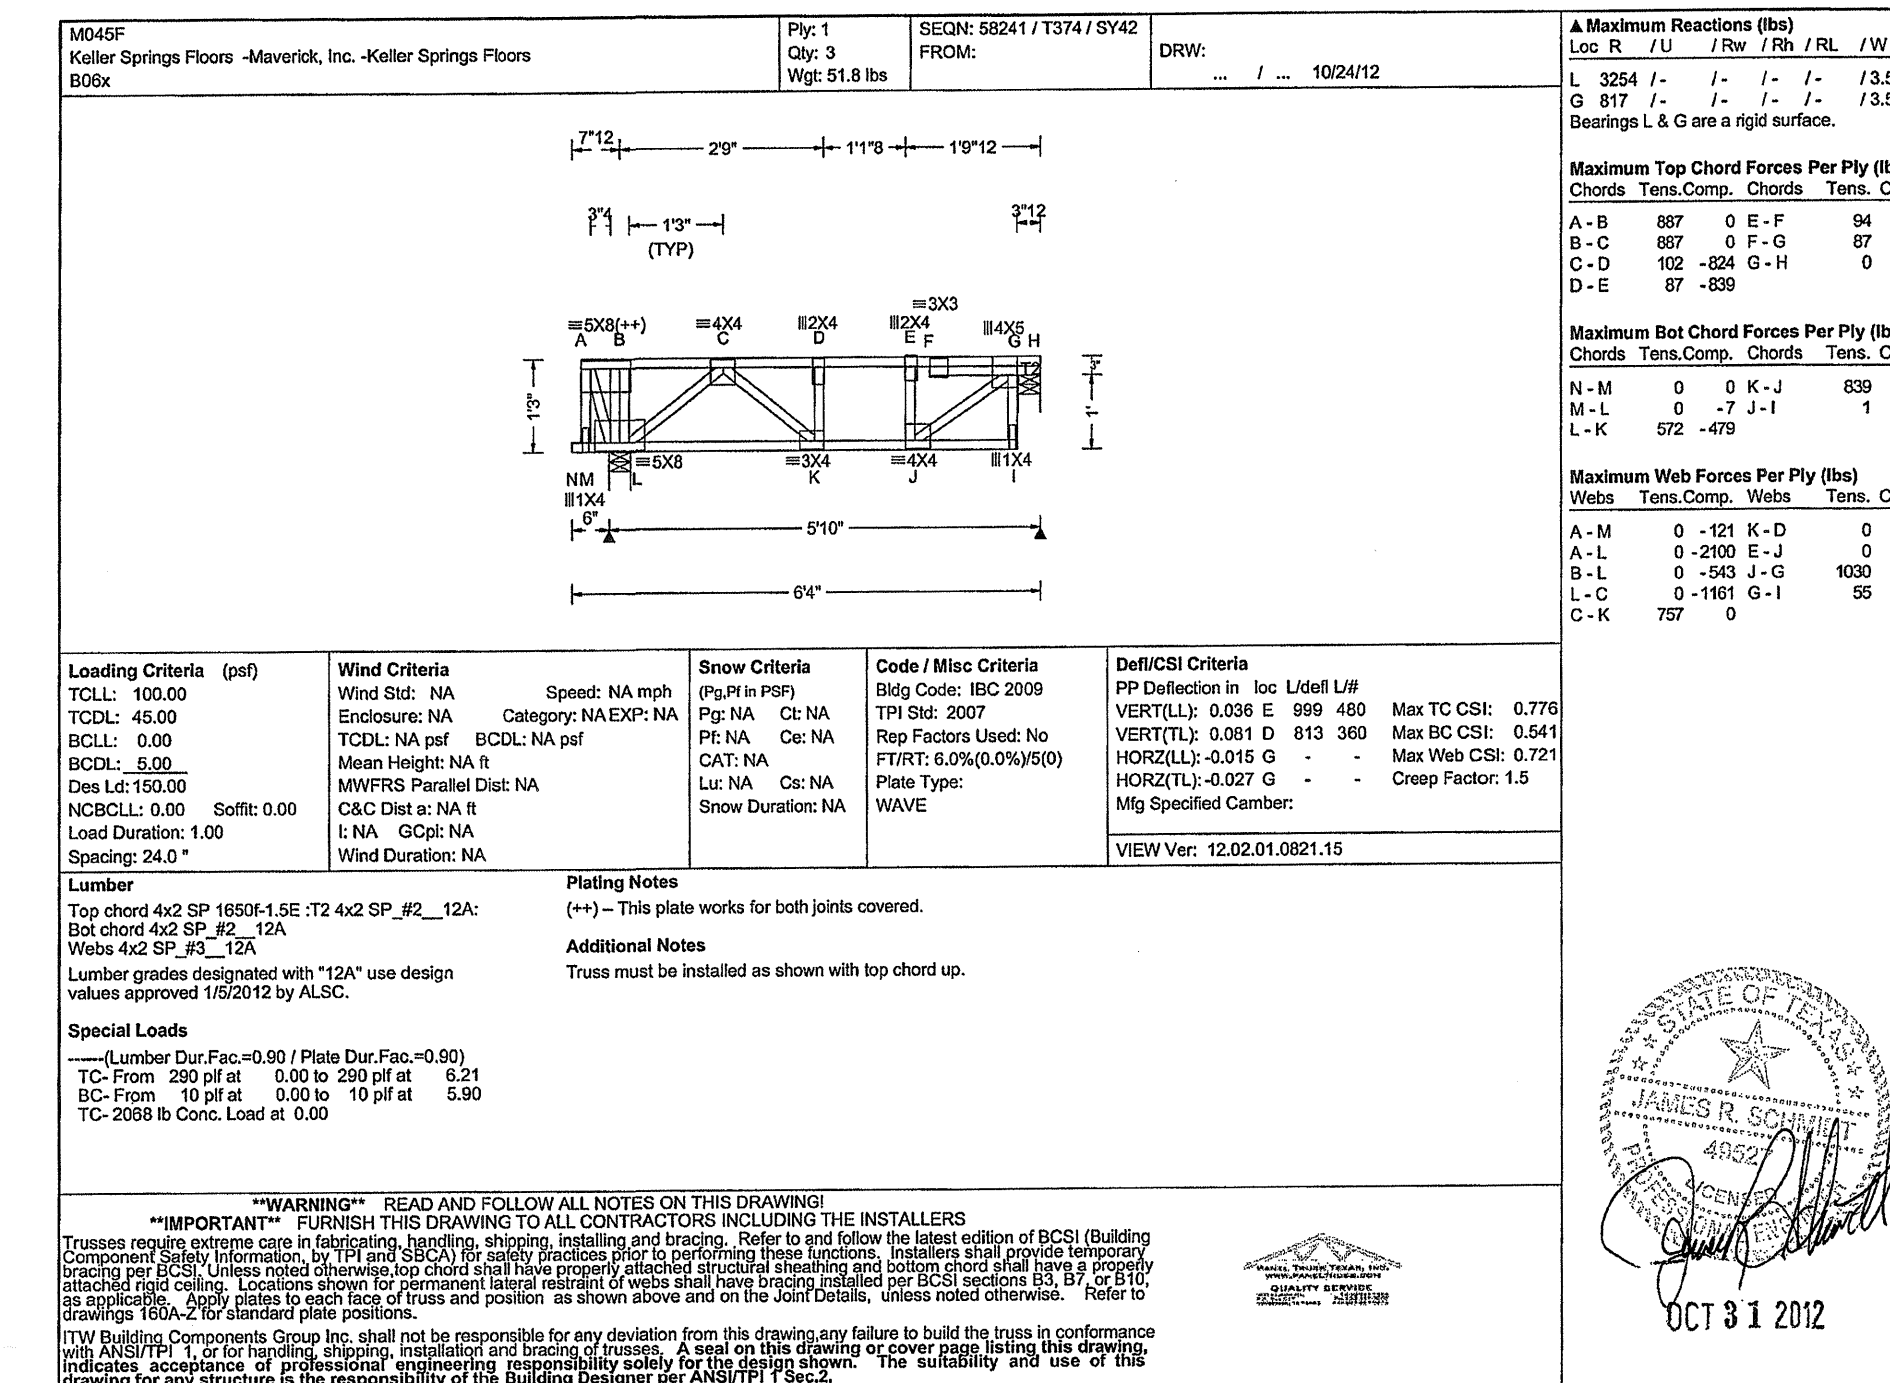

Loading Criteria (psf)		Wind Criteria		Snow Criteria		Code / Misc Criteria		Defl/CSI Criteria	
Load Duration: 1.00	I: NA GCQ: NA	I: NA GCQ: NA							
Spacing: 24.0"	Wind Duration: NA	Wind Duration: NA							

