```
1020 N. E. Loop 410, Suite 700
  San Antonio, TX 78209
  Ph: (210) 824-6044 Fax: (210) 824-7656
                                                                      RFI
    To: Trent Perkins
                                                                             RFI #: 25
            Parkin Perkins Olsen
                                                                             Date: 1/5/2012
            9330 LBJ Freeway, Suite 1055
                                                                             Job: EB-02 Keller Springs Lofts
            Dallas, TX 75243
                                                                           Phone: 877-777-5115
            Ph: (214)221-2220 Fax: (214)221-2252
    Subject: L shaped rebar dowels
    Drawing: 4/ SG3.02, 5/SG3.02
                                                                    Spec Section:
    Cost Impact: None
                                                                 Schedule Impact: None
   Date Required: 1/12/2012
    Detail 4/SG3.02 and 5/SG3.02 shows rebar dowels from beam walls to the F.F. slab of garage floor. Snice the beam walls are
    formed and poured 1st we will not be able to install dowel bar 1st. We would have to destroy the panels if we did. Can we pour the
    walls 1st and then come back and drill and epoxy the dowel later. Please give us the required information for the depth of drilled
    dowels and epoxy strength required. Also do you want them to be L-bar with the L side in the slab?
    Requested by: Bryan Pickler
                     Embrey Partners, Ltd.
     It is acceptable to drill and epoxy grout the dowels. Dowels shall be the same size indicated on the drawings and a minimum of 2'-0" in length. The embedment shall be 6" minimum. Adhesive shall be in
      accordance with the Adhesive and Drill-In Anchor Notes on sheet S1.01 of the structural drawings. The
     L-bars may be used; however, straight bars are acceptable.
    If you have questions or require additional information regarding this matter, please do not hesitate to contact us.
             Brande Parkey
    Answered by Parkin-Perkins-Olsen
                                                                                            01/17/2012
     Company
   Page 1 of 1
EMBREY BUILDERS, LLC.
1020 N. E. Loop 410, Suite 700
San Antonio, TX 78209
Ph: (210) 824-6044 Fax: (210) 824-7656
                                                                   RFI
 To: Trent Perkins
                                                                         RFI#: 26
         Parkin Perkins Olsen
                                                                          Date: 1/5/2012
         9330 LBJ Freeway, Suite 1055
                                                                          Job: EB-02 Keller Springs Lofts
         Dallas, TX 75243
                                                                        Phone: 877-777-5115
        Ph: (214)221-2220 Fax: (214)221-2252
  Subject: Thickend slab
 Drawing: 1/SG3.02
                                                                 Spec Section:
 Cost Impact: None
                                                              Schedule Impact: None
  Request:
   Date Required: 1/12/2012
Detail section 1/SG3.02 shows a 1' thickend beam which partially abuts to the pre-cast panel and beam wall. However, typical
T.O.W elevation is 1' below the typical top of F.F. for garage slab. Therefore the beam and the pre-cast panel will be recessed 1' from top of F.F. garage and several feet from top of F.F. of building slab. Please advise
 Requested by: Bryan Pickler
                  Embrey Partners, Ltd.
   Refer to structural drawings issued on January 4, 2012.
```

If you have questions or require additional information regarding this

matter, please do not hesitate to contact us.

Brande Parkey

Parkin-Perkins-Olsen

EMBREY BUILDERS, LLC.

San Antonio, TX 78209 Ph : (210) 824-6044 Fax: (210) 824-7656 RFI To: Trent Perkins RFI#: 54 Parkin Perkins Olsen Date: 2/15/2012 9330 LBJ Freeway, Suite 1055 Job: EB-02 Keller Springs Lofts Dallas, TX 75243 Phone: 877-777-5115 Ph: (214)221-2220 Fax: (214)221-2252 CC: David Gallagher (Embrey Build (Embrey Construction LLC) Subject: L-bars for Pier Caps Drawing: 3/S3.02 Spec Section: Cost Impact: None Schedule Impact: None As previously discussed, there was a question in regards to the number of L-bars from top of pier and into the pier cap. Our concrete man felt that detail 3/S3.02 was calling for (2) #7 L-bar dowels (one on each side of column). We found out there were six L-bars supposed to be coming from the pier cap. What is the fix for the piers already poured? Requested by: Bryan Pickler Embrey Partners, Ltd. Drill and grout in additional dowels as required utilizing Simpson SET adhesive with a minimum of 13 1/8" of embedment in accordance with the recommendations of the manufacturer. R. Trent Perkins, P.E. February 15, 2012 Parkin-Perkins-Olsen Consulting Engineering, Inc. Answered by Company Page 1 of 1

EMBREY BUILDERS, LLC.

Ph: (210) 824-6044 Fax: (210) 824-7656

Parkin Perkins Olsen

Dallas, TX 75243

Subject: Detail clarification

Requested by: Bryan Pickler

Brande Parkey

Company

EMBREY BUILDERS, LLC.

1020 N. E. Loop 410, Suite 700

Parkin-Perkins-Olsen

Drawing: 3/Sg3.02

Cost Impact: None

9330 LBJ Freeway, Suite 1055

Ph: (214)221-2220 Fax: (214)221-2252

Is 3/Sg3.02 the correct detail @ intersection of grid line 8 + B?

Embrey Partners, Ltd.

Please refer to revised drawings issued on January 25, 2012. If you have questions or require

additional information regarding this matter, please do not hesitate to contact us.

RFI

Spec Section:

Schedule Impact: None

RFI#: 29

Date: 1/5/2012

Phone: 877-777-5115

Job: EB-02 Keller Springs Lofts

Date Required: 1/12/2012

Page 1 of 1

1020 N. E. Loop 410, Suite 700

San Antonio, TX 78209

To: Trent Perkins

1020 N. E. Loop 410, Suite 700 San Antonio, TX 78209 Ph : (210) 824-6044 Fax: (210) 824-7656

EMBREY BUILDERS, LLC.

RFI

CC:

Subject: Detail for leave out, for oil separator

Drawing:P-3.0DSpec Section:Cost Impact:NoneSchedule Impact: None

Request:

Tent we need to get a detail for a leave on the slab for the two oil separators, please reference RF# 33 which is attached, and the specs for the oil separators.

Requested by: Bryan Pickler Embrey Partners, Ltd.

Response:

See Attached.


R. Trent Perkins, P.E.
Parkin-Perkins-Olsen Consulting Engineering, Inc.

Answered by

Company

Date

Page 1 of 1

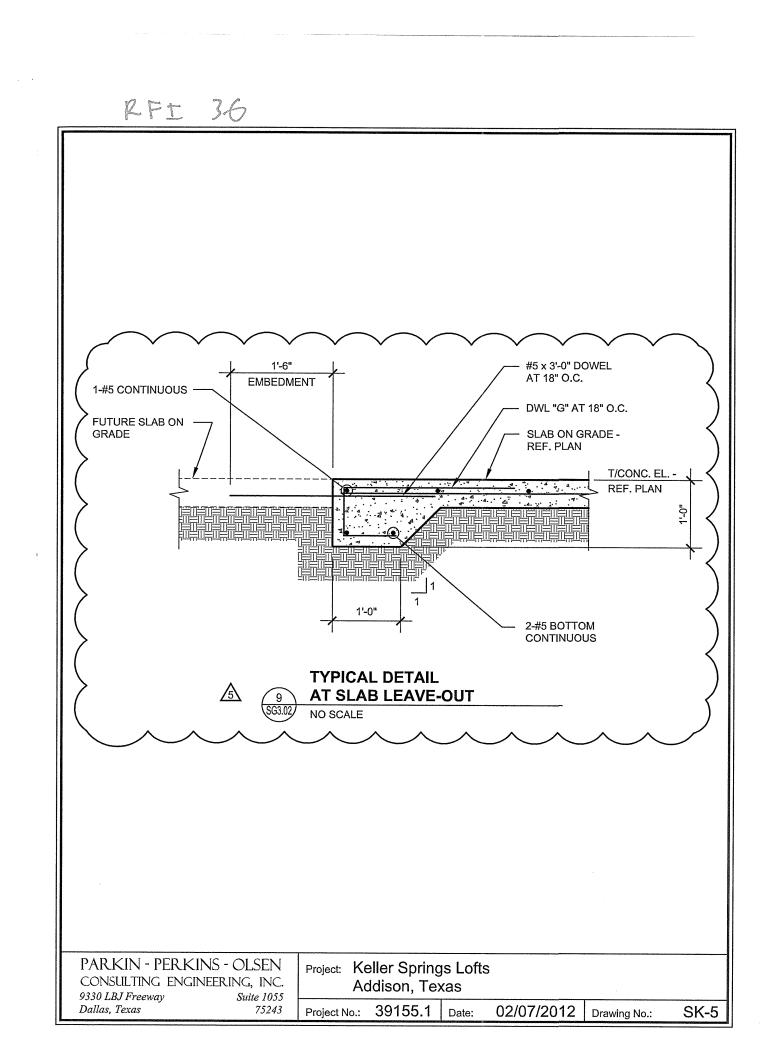

Page 1 of 1

11 TE