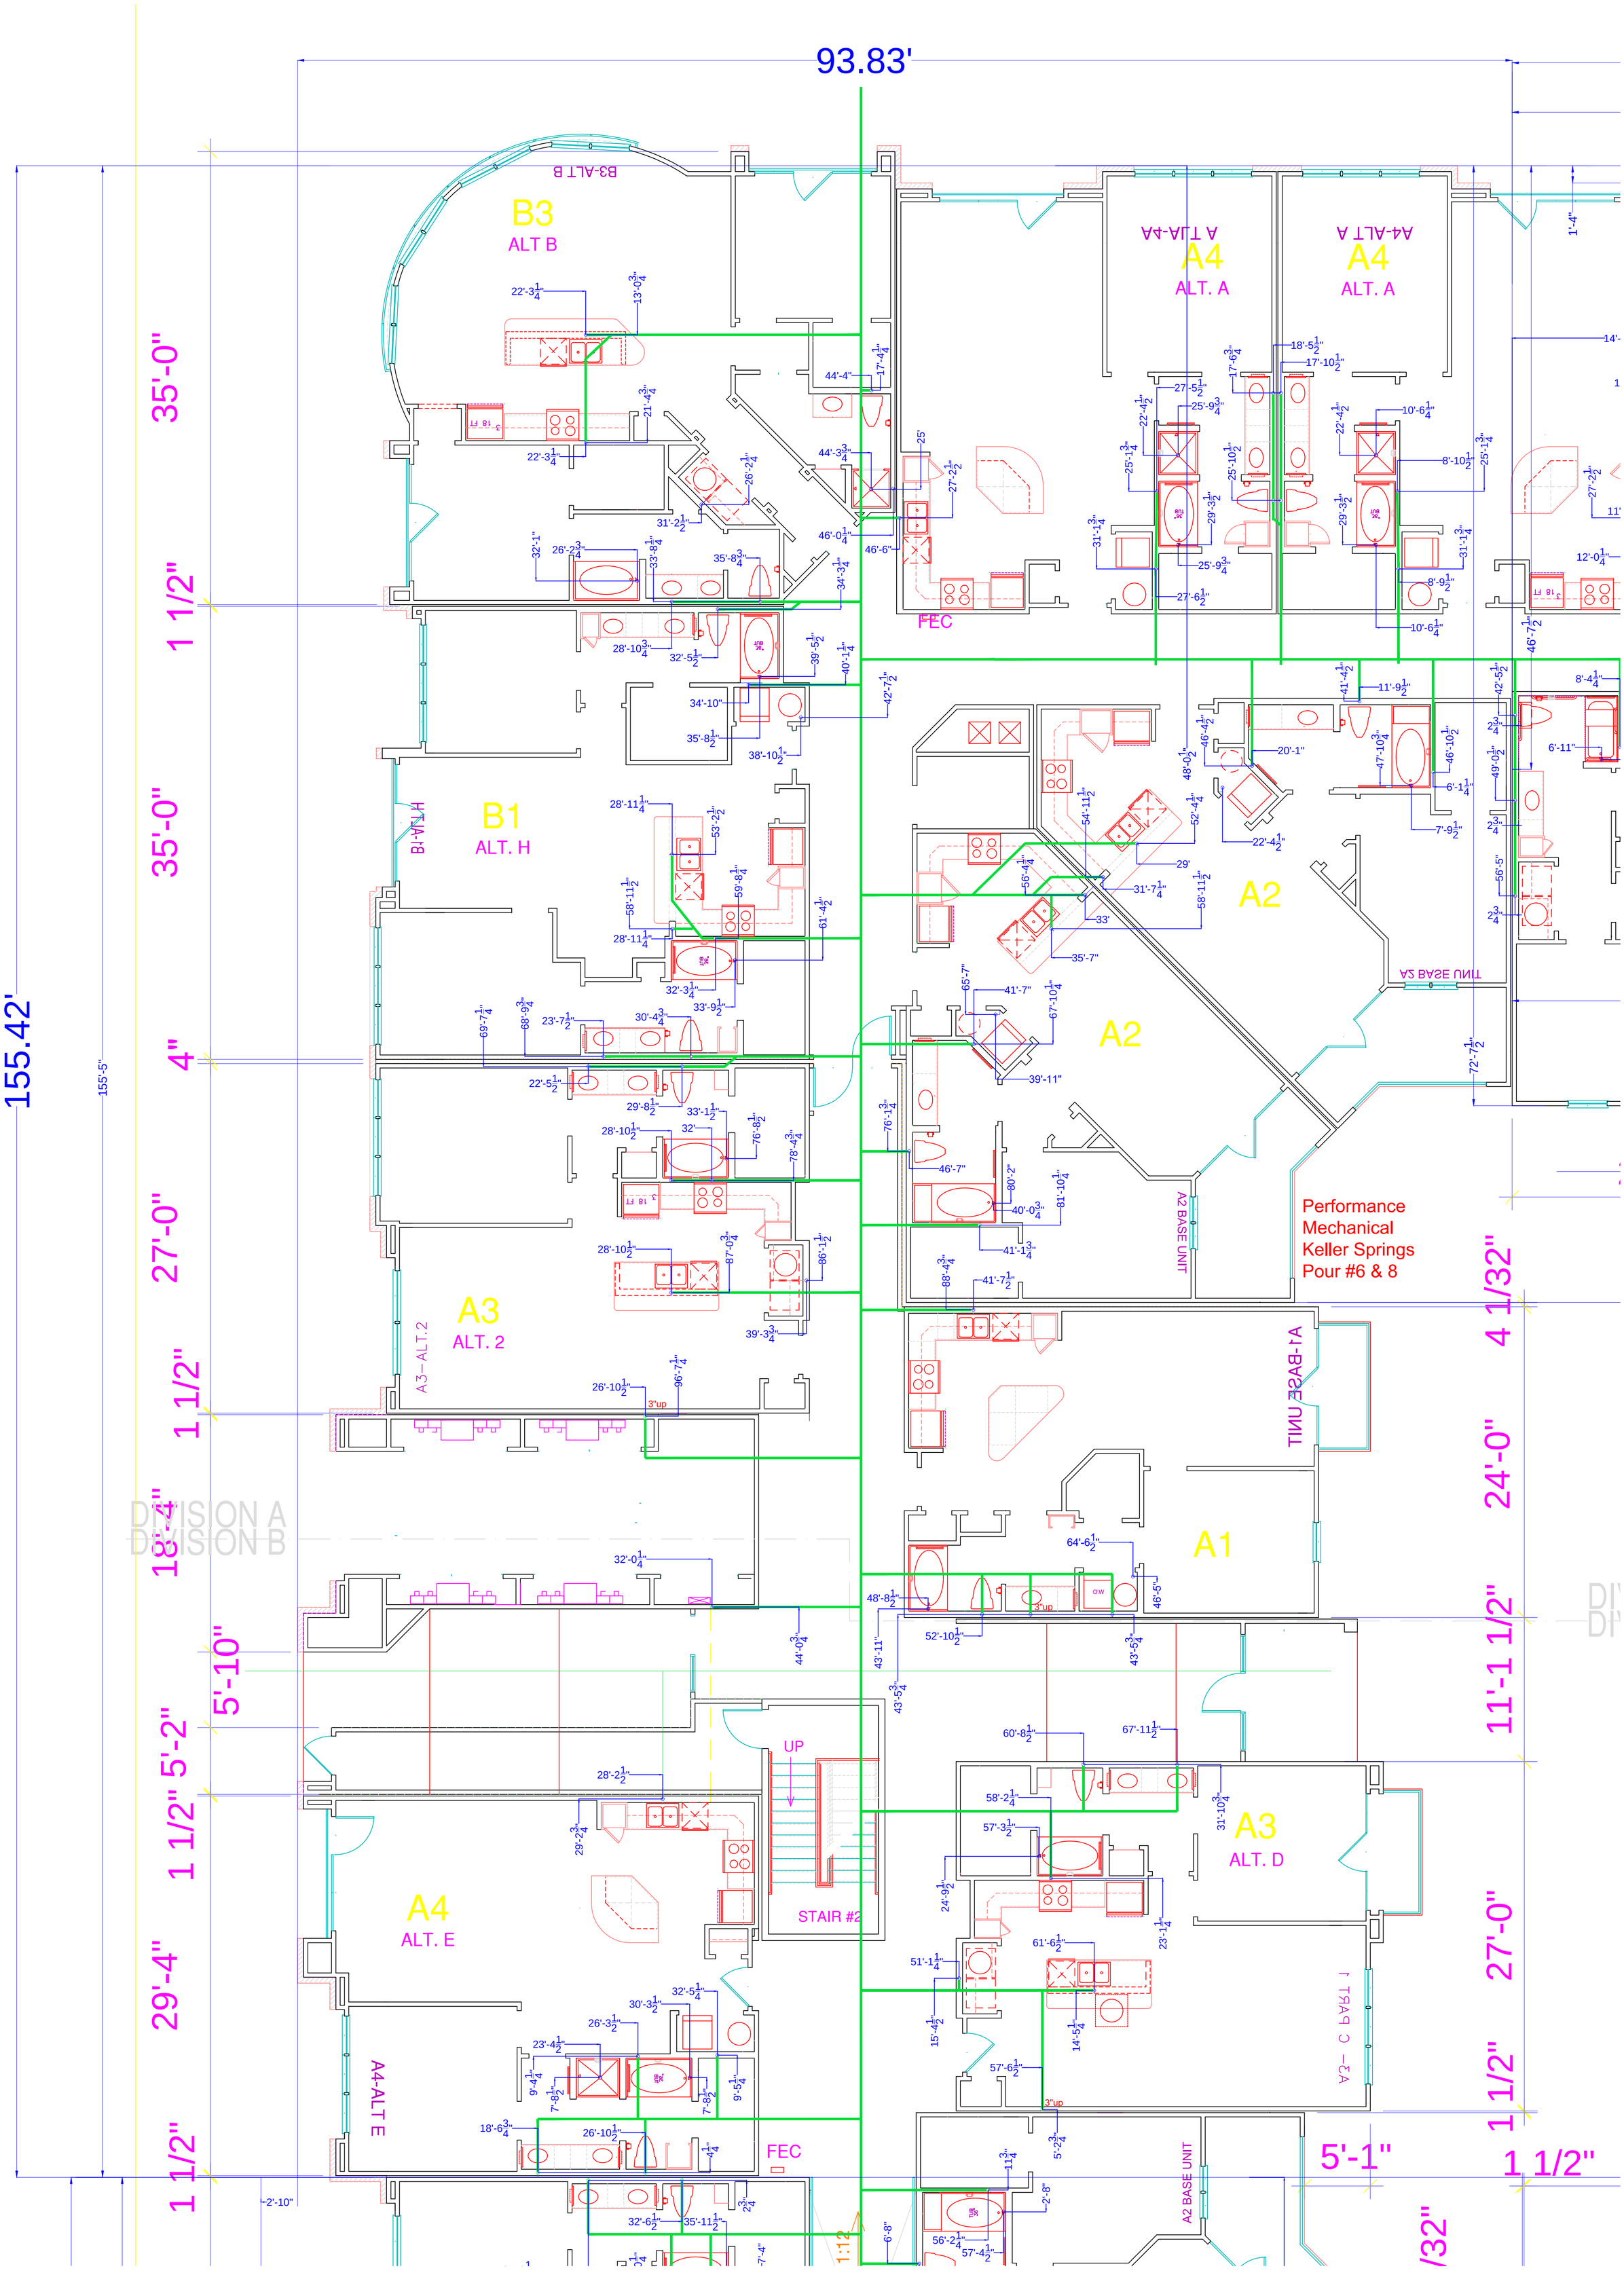

93.83'
155.42'
B3
ALT B
B3-ALT B
A4
ALT. A
A4-ALT A
A4
ALT. A
A4-ALT A
B1
ALT. H
B1-ALT H
A2
A2
A2 BASE UNIT
A3
ALT. 2
A3-ALT.2
A1
A1-BASE UNIT
A3
ALT. D
A3-ALT D
A4
ALT. E
A4-ALT E
FEC
FEC
STAIR #2
UP
Performance
Mechanical
Keller Springs
Pour #6 & 8
DIVISION A
DIVISION B
35'-0"
1 1/2"
35'-0"
4"
27'-0"
1 1/2"
18'-4"
5'-10"
5'-2"
1 1/2"
29'-4"
1 1/2"
4 1/32"
24'-0"
11'-1 1/2"
27'-0"
1 1/2"
5'-1"
1 1/2"