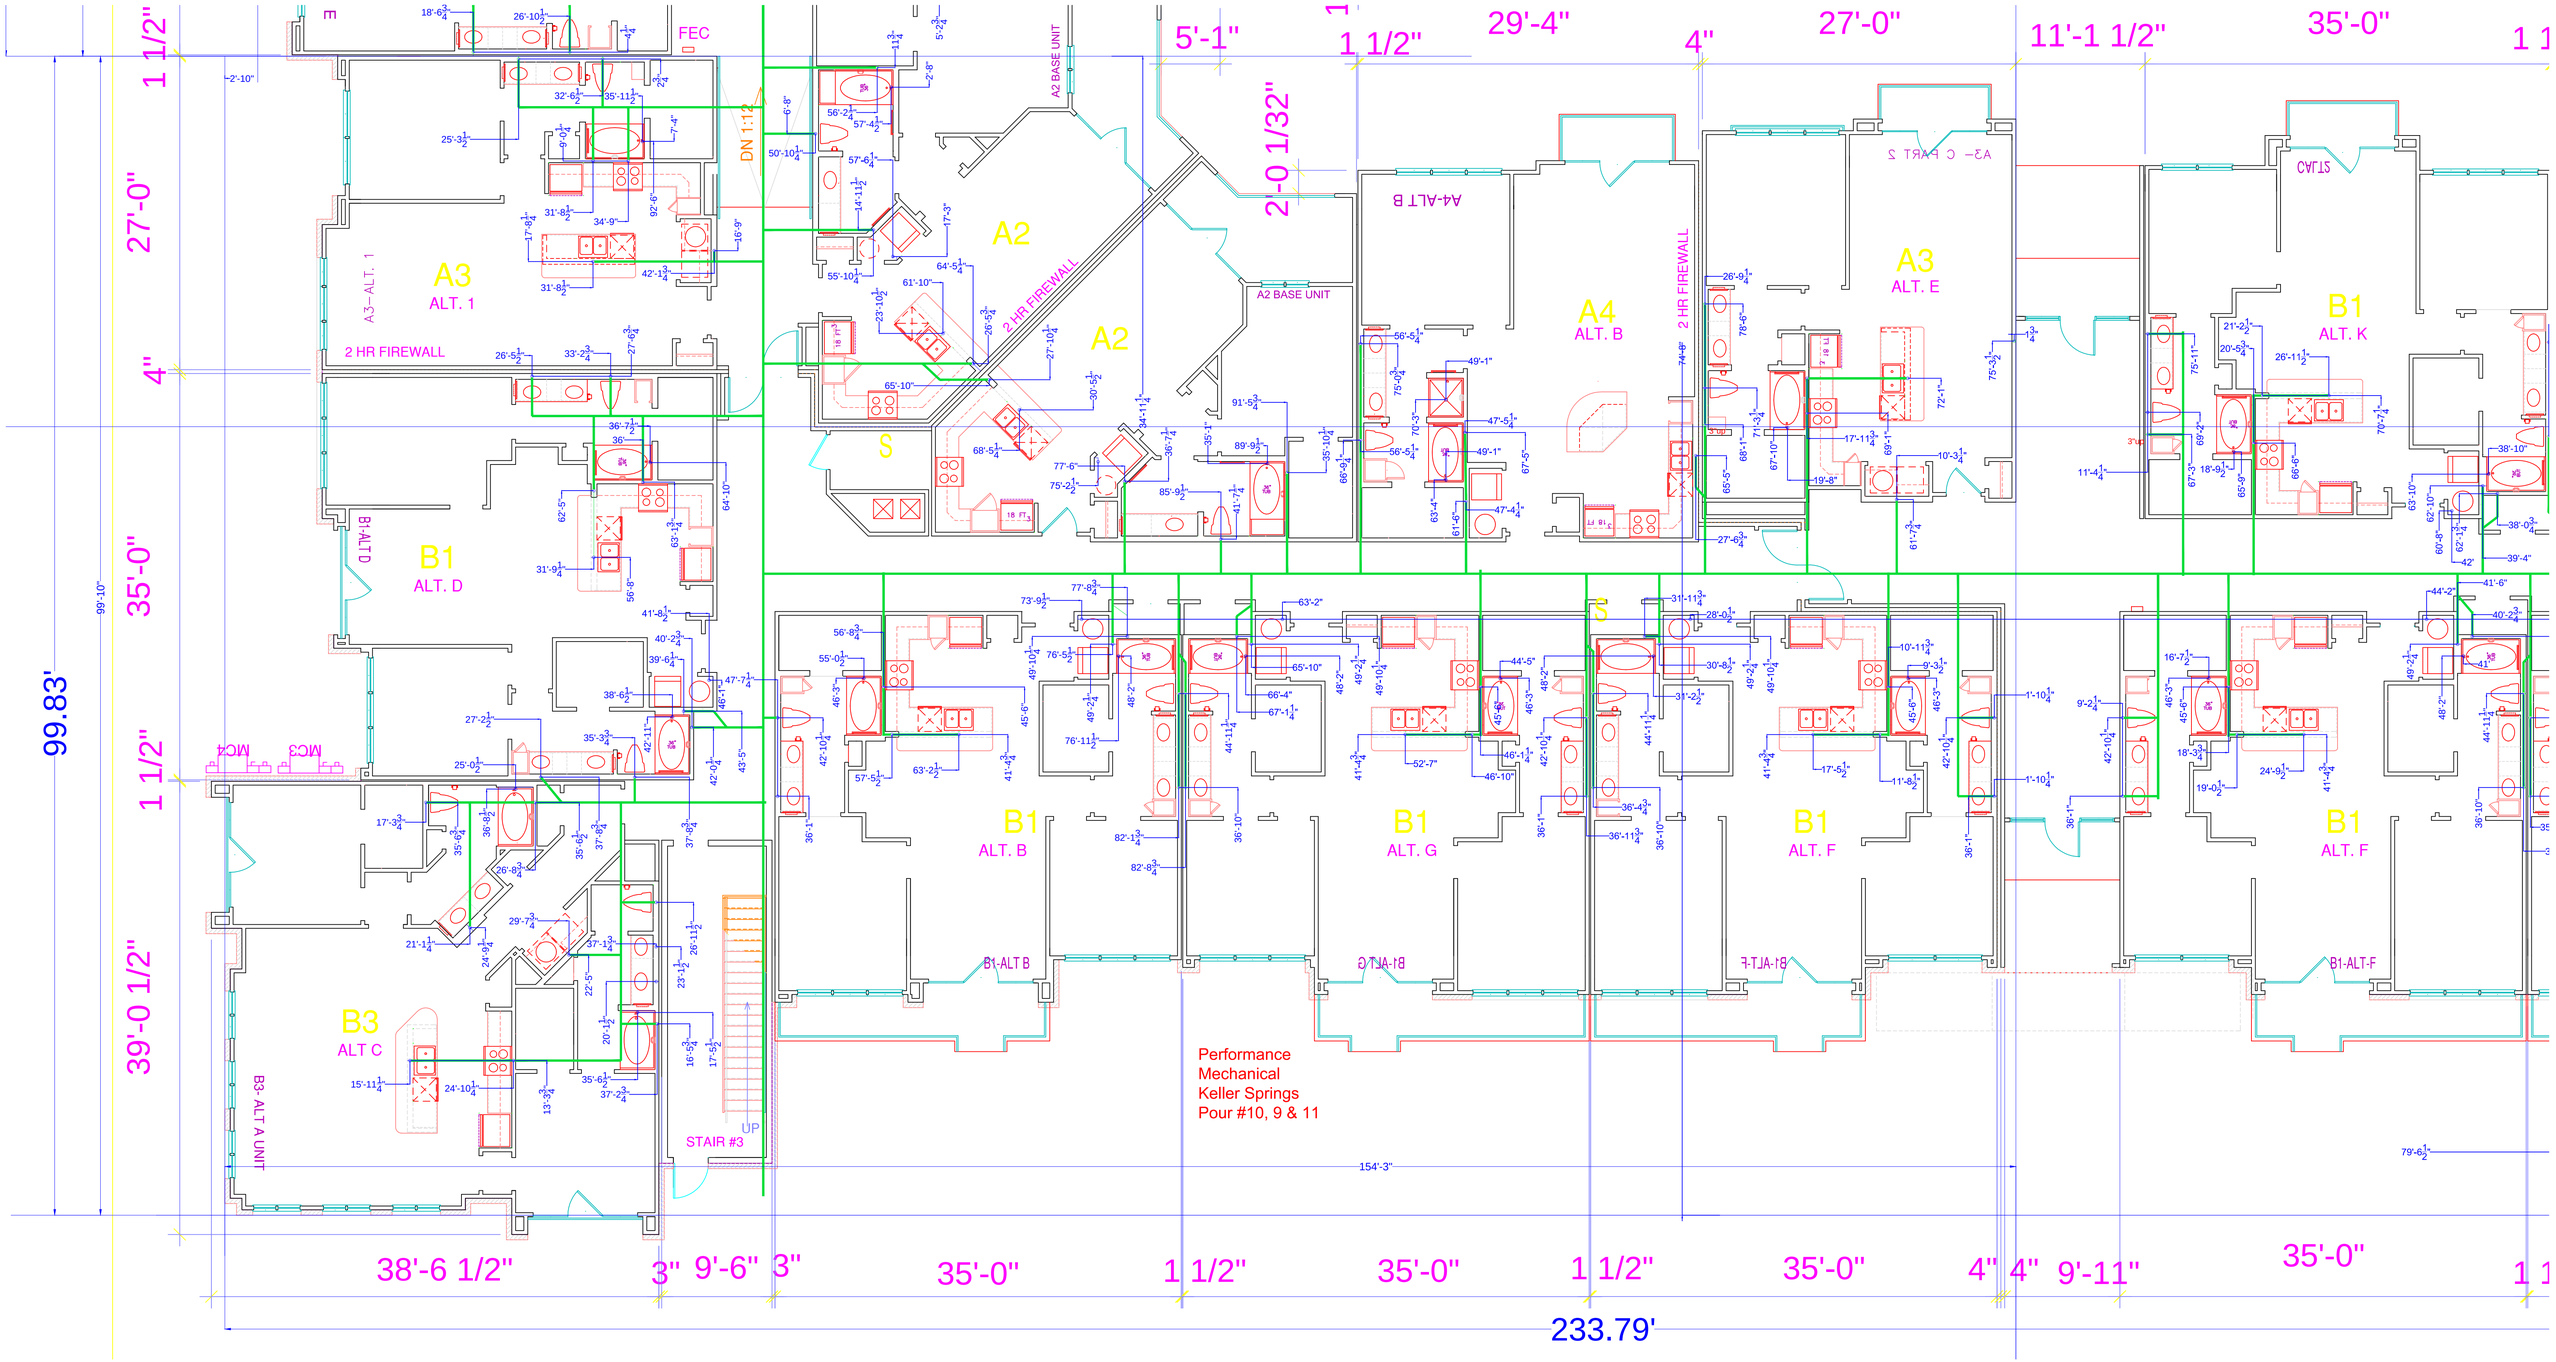
A3
ALT. 1
A3-ALT. 1
2 HR FIREWALL
B1
ALT. D
B1-ALT D
FEC
DN 1:12
A2
A2 BASE UNIT
2 HR FIREWALL
S
A4
ALT. B
A4-ALT B
A3
ALT. E
A3- C PART 2
B1
ALT. K
STLAD
B1
ALT. B
B1-ALT B
B1
ALT. G
B1-ALT G
B1
ALT. F
B1-ALT F
B1
ALT. F
B1-ALT-F
B3
ALT C
B3- ALT A UNIT
MC3
MC4
STAIR #3
UP
Performance
Mechanical
Keller Springs
Pour #10, 9 & 11
99.83'
39'-0 1/2"
35'-0"
27'-0"
38'-6 1/2"
3"
9'-6"
3"
35'-0"
1 1/2"
35'-0"
1 1/2"
35'-0"
4"
4"
9'-11"
35'-0"
233.79'