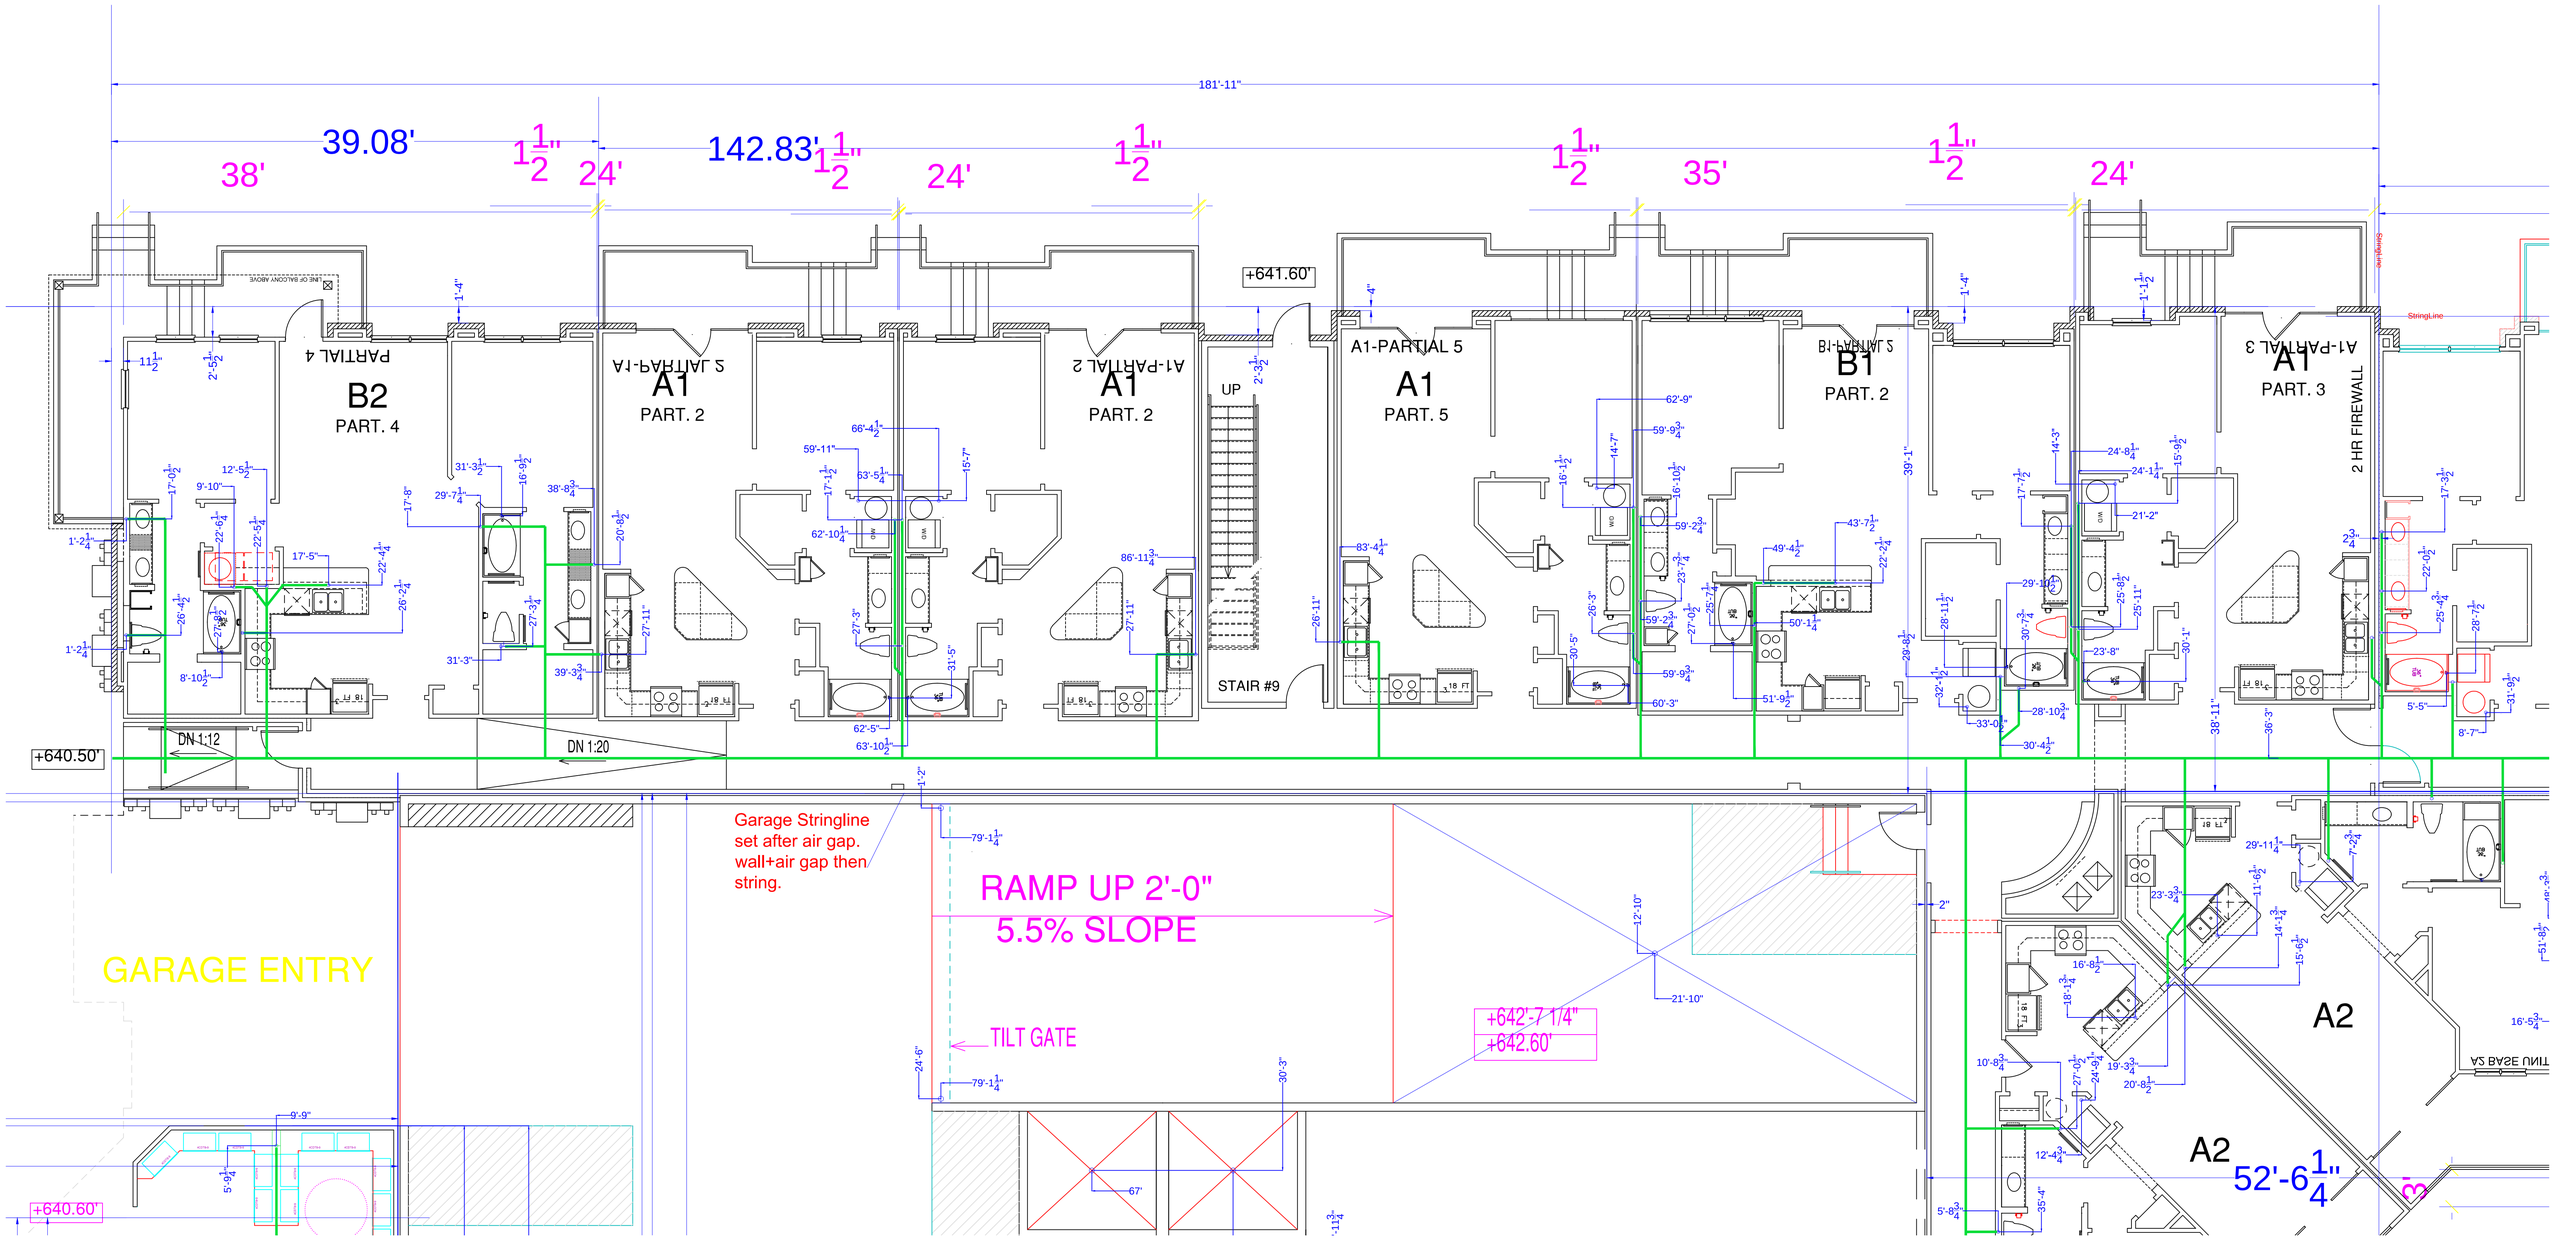

181'-11"
39.08'
38'
1 1/2"
24'
142.83'
1 1/2"
24'
1 1/2"
1 1/2"
35'
1 1/2"
24'
+641.60'
B2
PART. 4
A1
PART. 2
A1
PART. 2
UP
STAIR #9
A1-PARTIAL 5
A1
PART. 5
B1
PART. 2
A1
PART. 3
2 HR FIREWALL
+640.50'
DN 1:12
DN 1:20
Garage Stringline
set after air gap.
wall+air gap then
string.
RAMP UP 2'-0"
5.5% SLOPE
GARAGE ENTRY
TILT GATE
+642'-7 1/4"
+642.60'
A2
A2
52'-6 1/4"
+640.60'