
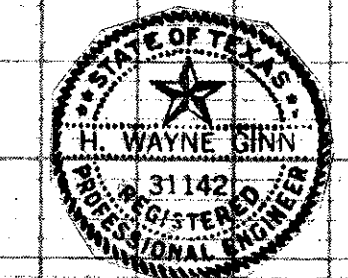


TBM - "□" cut on S.E. top curb corner, the back side parking lot, Building 15790 Midway Road. Elevation 637.75

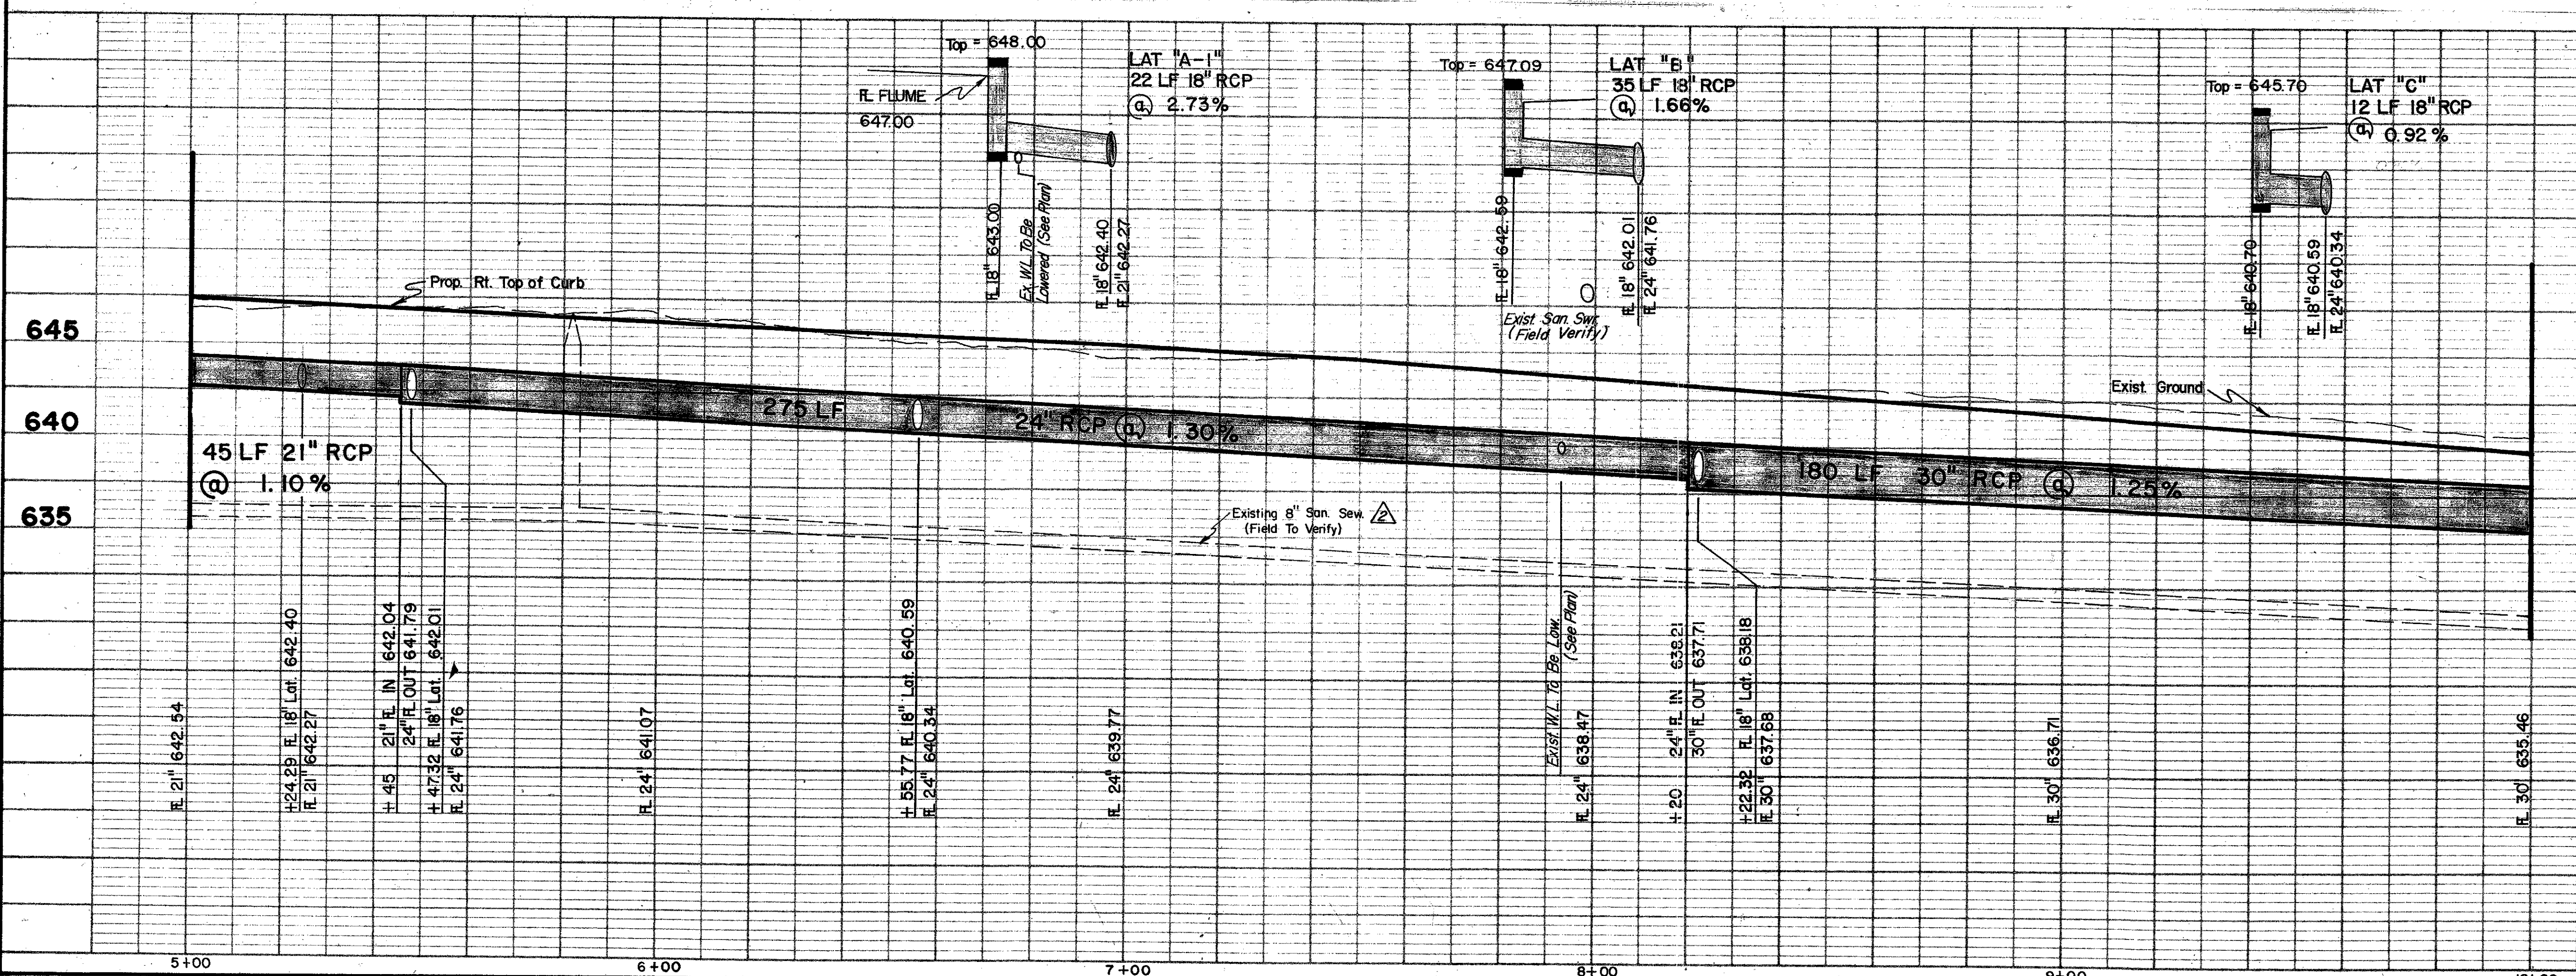

| | | |
|---|---------------|------------------------------|
| Added Exist. B" San. Swr. to Profile | RLO | 10/4/86 |
| Added Exist. Gas Line | RLO | 8/18/86 |
| Revision | | |
| By | Date | |
| TOWN OF ADDISON DALLAS COUNTY, TEXAS | | |
| KELLER SPRINGS/DOOLEY RD. IMPROVEMENTS | | |
| DRAINAGE | | |
| DOOLEY RD. STA. 5+00-10+00 | | |
| GINN, INC. | | |
| Consulting Engineers Dallas, Texas | | |
| Designed - RLO | Drawn - RLO | Date - JUNE, 1986 |
| Approved - HWG | Checked - JCR | Scale - 1" = 20' H/1" = 5' V |
| | | Job No. - 263 |
| | | Sheet 13 Of 30 |