1-07-0005

1-07-0004 Midway Park North

DOOLEY ROAD

CONC. ENCASE. SEE SHT. 27

℄ CURVE DATA
Δ = 90° 19' 35"
R = 100.00'
T = 100.57'
L = 157.65'

PC. STA. 14+05.38

FOR LAT. H SEE SHEET 14

PT. STA. 100.57

35 LF 24" RCP LAT. "H"

EXIST. CULVERT TO BE REMOVED PAY ITEM NO. 100

15 LF EA. EXIST. W.L. TO BE LOWERED PAY ITEM 479.7

1+82 ℄ Keller Springs Rd. =
0+00 ℄ Dooley Rd. North

STA. 3+21.43
INSTALL 2-10' REC. INLETS
T.C. = 631.11 (MOD.)
IL. = 626.11
PAY ITEM NO. 470.2

EXIST. CULVERT TO BE REMOVED PAY ITEM NO. 100

STA. 4+04
INSTALL 1-10' REC. INLET
T.C. = 631.96
IL. = 627.46
PAY ITEM NO. 470.2

As Built

T.B.M.

Vault

Water Meter Vault

10" Hackberry

Twin 6" Bois d' arc

Twin 8" Hackberry

Hackberry

I.P.F.

S.S.M.H.

℄ "A"

℄ "B"

0+00

1+00

2+00

3+00

4+00

8" PVC

53 LF 48" RCP

48" RCP

42" RCP

24" RCP

18" R.C.P.

50' R.O.W.

10'

45°

W.V.

F.H.

P.P.

P.C. 1+23.45

40' R.

PT. 0+58.55

STA. 0+80.44 ℄ "B" – 10' RT.
INSTALL 1-45° BEND (48")
PAY ITEM 465.71

0+00 KELLER SPRGS. RD. ℄ "B" =
15+05.95 DOOLEY RD. ℄ "A"

CONC. ENCASE. 20 LF EX. SAN. SWR. SEE DETAIL SHT. NO. 28
PAY ITEM 465.9

20 LF EX. W.L. TO BE LOWERED PAY ITEM 479.7

DOOLEY ROAD

60" RCP

SEE SHT. 16

PT. 0+48.46

STA. 1+92 KELLER SPRINGS – 10' RT.
CONST. JUNCT. BOX NO. 1
TOP = 632.6± IL = 623.56
SEE DETAIL SHT. NO. 18
PAY ITEM 475.1

RELOCATE EXIST. W.L. SEE DETAIL SHT. NO. 16
PAY ITEM 479.4

PC. 2+30.46

12" Elm

10' R.

CR. 2+91.5

3+06 END 42" BEGIN 24"

CR. 3+08.5

3+86.68 LAT "K"

3+94.23 LAT "J"

3+98 END 24"

CR. 4+91.5

10 LF EX. W.L. TO BE LOWERED PAY ITEM 479.7

STA. 4+00
INSTALL 1-5' REC. INLET
T.C. = 631.90
IL. = 627.40
PAY ITEM 470.1

12 LF 18" RCP LAT. "J"

C.O.

KELLER SPRINGS ROAD

MATCH LINE 5+00

1-08-0013 JWL Investments

TBM – " □ " cut on N.W. top curb, corner of parking lot, Building 15950 Midway Road. Elevation 634.57

TBM – " □ " cut on S.W. top curb, corner of parking lot, 4125 Keller Springs Road ± 60' west of Midway Place sign. Elevation 634.62

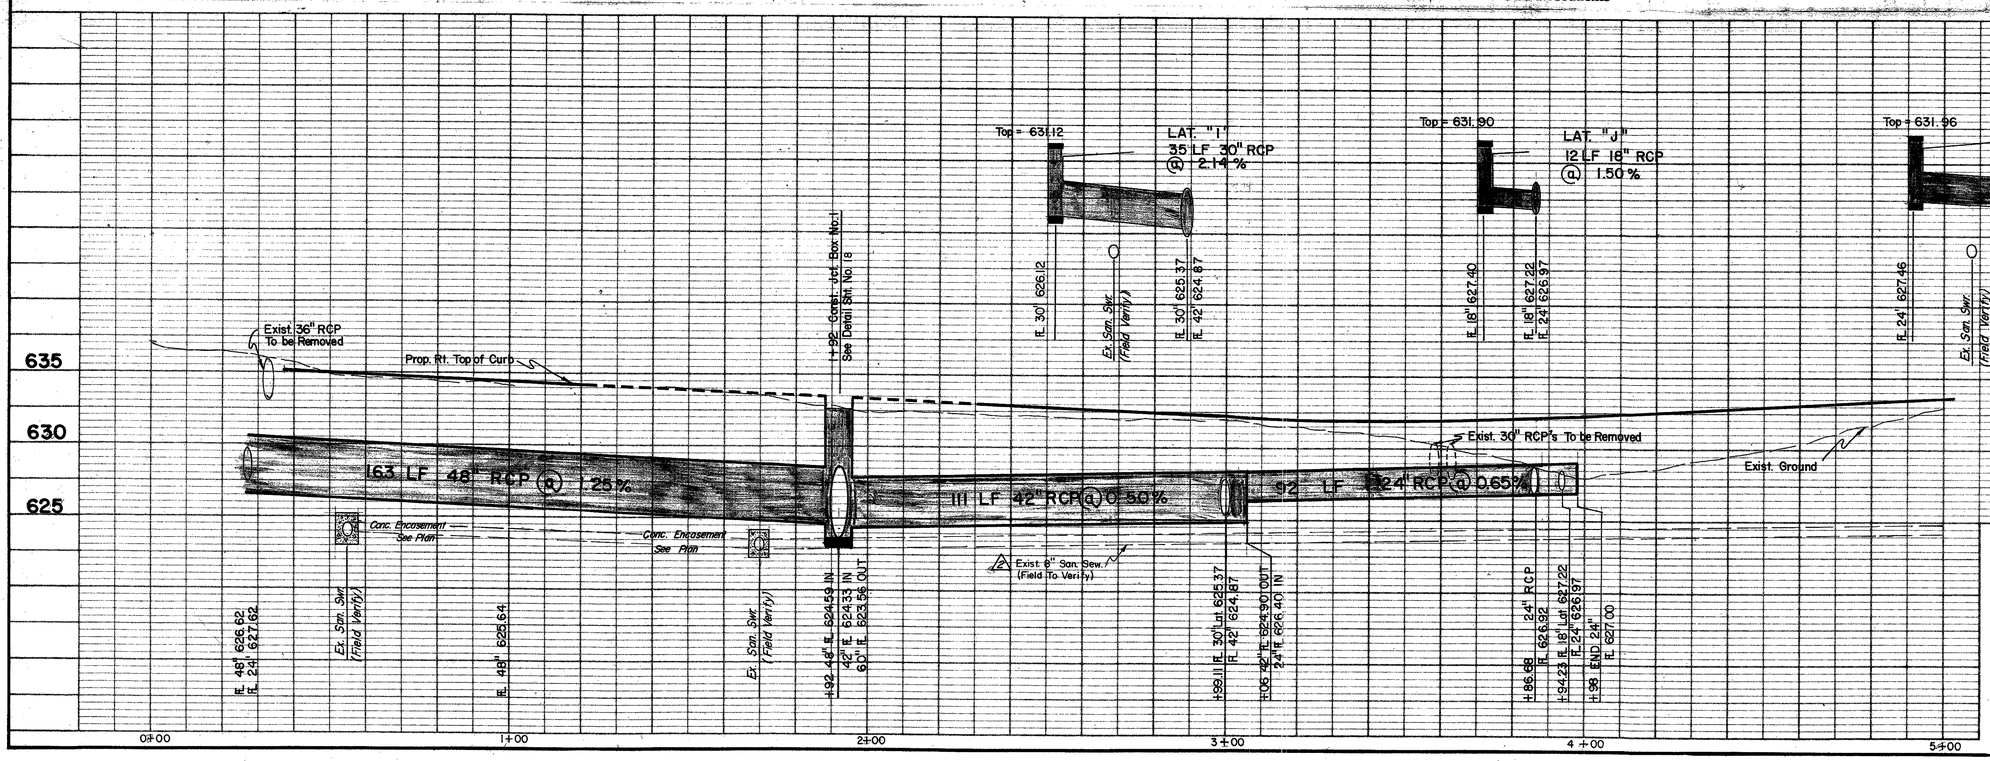

STATE OF TEXAS
H. WAYNE GINN
81142
REGISTERED PROFESSIONAL ENGINEER

No.	Revision	By	Date
2	Added Exist. 8" San. Sew. To Profile	RLO	10/4/86
1	Added Exist. Gas Line Location	RLO	8/18/86

TOWN OF ADDISON
DALLAS COUNTY, TEXAS

KELLER SPRINGS/DOOLEY RD. IMPROVEMENTS

DRAINAGE

KELLER SPRINGS LAT. "H" – STA. 5+00

GINN, INC.
Consulting Engineers Dallas, Texas

Designed – RLO	Drawn – RLO	Date – JUNE, 1986	Job No. – 265
Approved – HWG	Checked – JCK	Scale – 1"= 20' H/1"= 5' V	Sheet 15 Of 30