
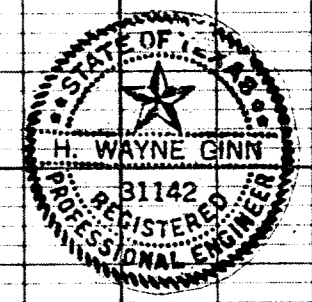


TBM - " " cut on N.W. top curb, corner of parking lot, Building 15950 Midway Road. Elevation 634.57

TBM - " " cut on S.W. top curb, corner of parking lot, 4125 Keller Springs Road ± 60' west of Midway Place sign. Elevation 634.62

1-06-0013 JWL Investments

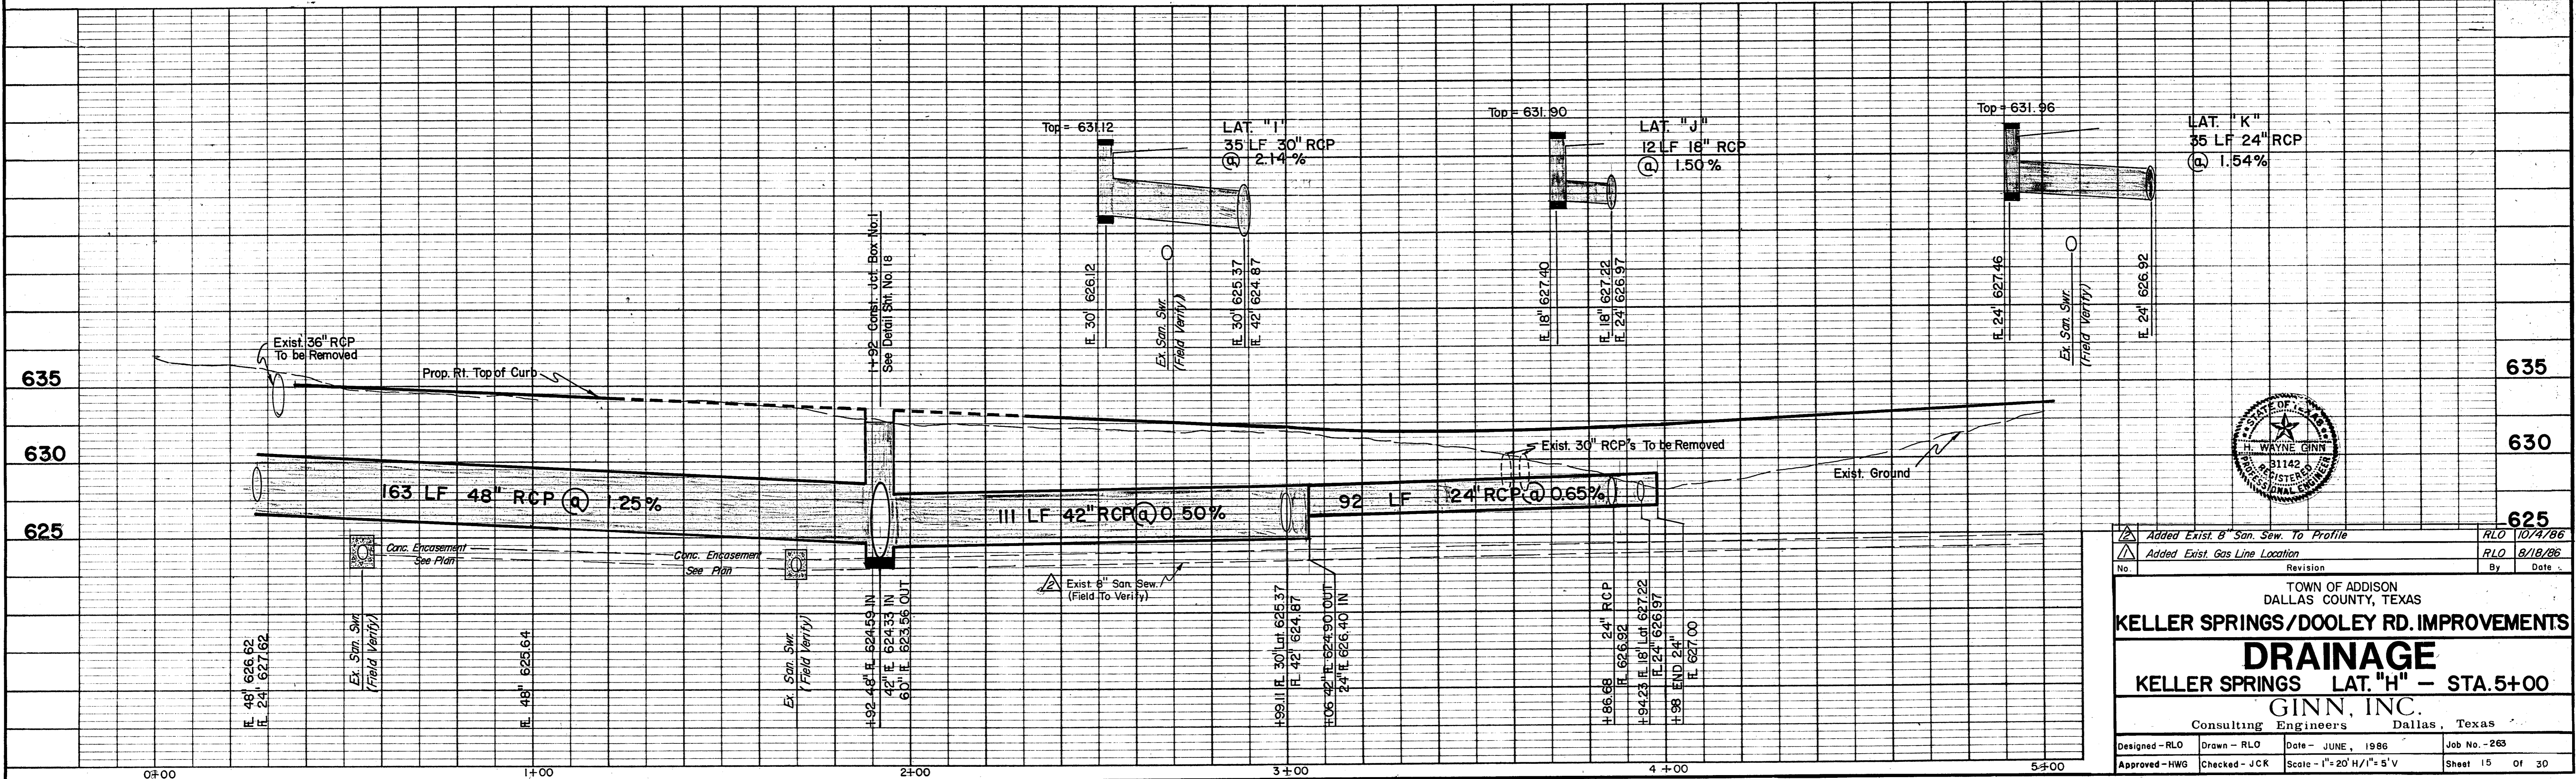

Added Exist. B' San Sew. To Profile		RLO 10/4/86
Added Exist. Gas Line Location		RLO 8/18/86
No.	Revision	By Date
TOWN OF ADDISON DALLAS COUNTY, TEXAS KELLER SPRINGS/DOOLEY RD. IMPROVEMENTS DRAINAGE KELLER SPRINGS LAT. "H" - STA. 5+00 GINN, INC. Consulting Engineers Dallas, Texas		
Designed - RLO	Drawn - RLO	Date - JUNE, 1986
Approved - HWG	Checked - JCK	Scale - 1" = 20' H / 1" = 5' V
		Job No. - 263
		Sheet 15 of 30