SIGNAL INSTALLATION NOTES:

1. EXISTING STREET NAME SIGNS TO BE RELOCATED TO NEW SIGNAL POLES.
2. VIDEO CAMERAS TO BE MOUNTED ON TOP OF EACH SIGNAL POLE AND AIMED IN SAME DIRECTION AS THE SIGNAL HEADS.
3. CONTRACTOR SHALL CONTACT BOB SANDS (972) 234-7084 AT SOUTHWESTERN BELL TO COORDINATE TELEPHONE LINE DROP IN NW CORNER.

N

20' 0 20'
SCALE FEET

FIRE HYDRANT	
POWER POLE	
TELEPHONE LINE U.G.	—T—
STORM LINE	—S—
SANITARY SEWER LINE	—SAN—
GAS LINE	—G—
WATER LINE	—W—
MANHOLE	
LIGHT STANDARD WITH PHOTOCELL	
EXISTING RIGHT-OF-WAY	
EXISTING SIGNAL POLE IDENTIFIER	T3(E)

ZONE DETECTOR (VIDEO)	
TRAFFIC SIGNAL ON ARM W/POLE	
COMB. ST. LIGHT/SIGNAL POLE	
SIGNAL HEAD IDENTIFIER	1
SIGNAL CONDUIT	
CONDUIT IDENTIFIER	Q
INSTALL PULLBOX TYPE A	
INSTALL PULLBOX TYPE C	
PEDESTRIAN SIGNAL WITH BUTTONS, AND R10-4b SIGNS	
PEDESTAL POLE W/SIGNALS WITH BUTTONS, AND R10-4b SIGNS	
INSTALL CONTROLLER FOUNDATION/CABINET	
INSTALL SIGN PLATE	
PROPOSED SIGNAL POLE IDENTIFIER	T3
OPTICOM DETECTOR	
SIGN PLATE AND POLE TO BE INSTALLED	

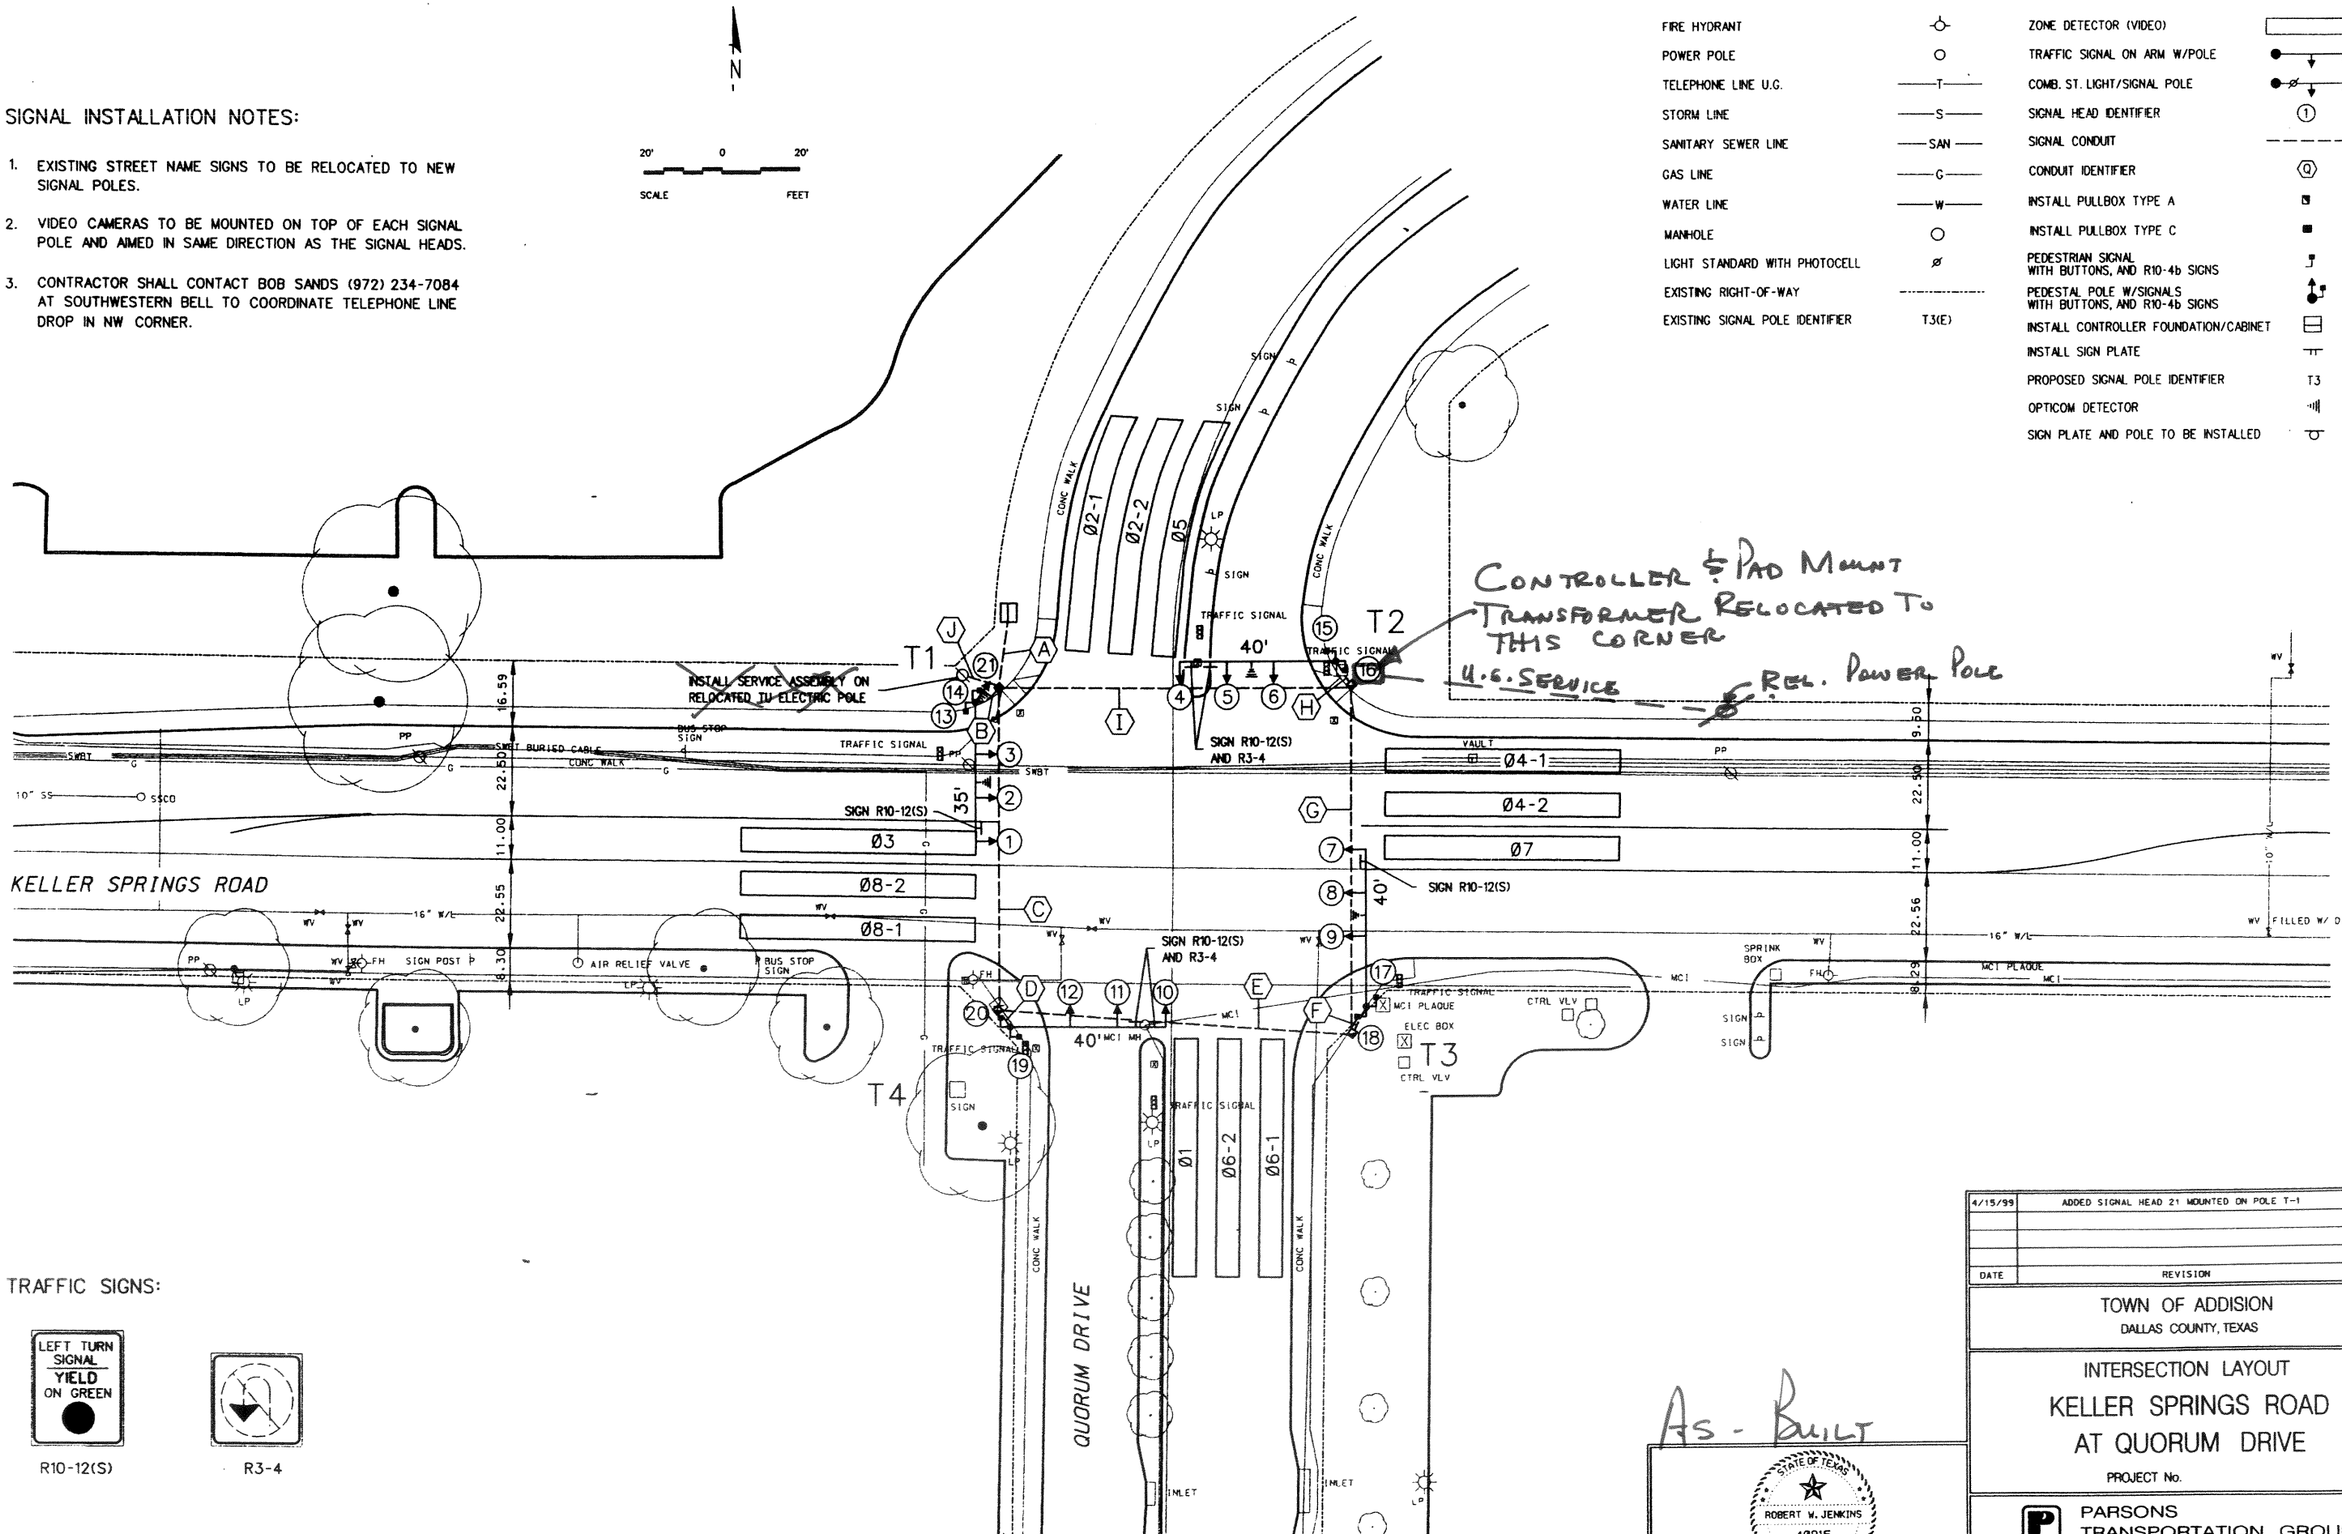

TRAFFIC SIGNS:

R10-12(S) R3-4

DATE	REVISION	BY
4/15/99	ADDED SIGNAL HEAD 21 MOUNTED ON POLE T-1	CWW/RWJ

TOWN OF ADDISION
DALLAS COUNTY, TEXAS

INTERSECTION LAYOUT
KELLER SPRINGS ROAD
AT QUORUM DRIVE

PROJECT No.

As-Built

STATE OF TEXAS
ROBERT W. JENKINS
40915
REGISTERED PROFESSIONAL ENGINEER
ROBERT W. JENKINS, P.E.
4/15/99
DATE

PARSONS TRANSPORTATION GROUP
2630 W. FREEWAY #132 · FORT WORTH, TEXAS 76102 · (817) 877-5803

DESIGNED :	S.C.B.	DRAWN :	C. W.W.	FILE :	KEL-BASE
APPROVED :	R.W.J.	CHECKED :	A.M.	SHEET	12 OF 20