
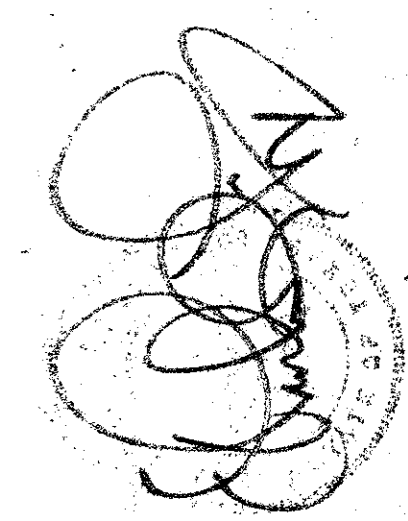


CITY OF ADDISON
APPROVED
 FOR CONSTRUCTION
 BUILDING DEPARTMENT
 5-23-88

DATE: CONTRACTOR IS HEREBY INSTRUCTED TO EXERCISE CARE IN APPLYING OR EXCEEDING ALL REQUIREMENTS OF BOTH NATIONAL AND LOCAL CODES AND/OR ORDINANCES APPLICABLE TO HIS WORK. APPROVAL OF THESE DRAWINGS SHALL NOT BE CONSTRUED TO RELIEVE RESPONSIBILITY OR IMPLY VARIANCE TO SUCH CODES.

Utilities Approved Only,
 NOT APPROVED FOR PAVING

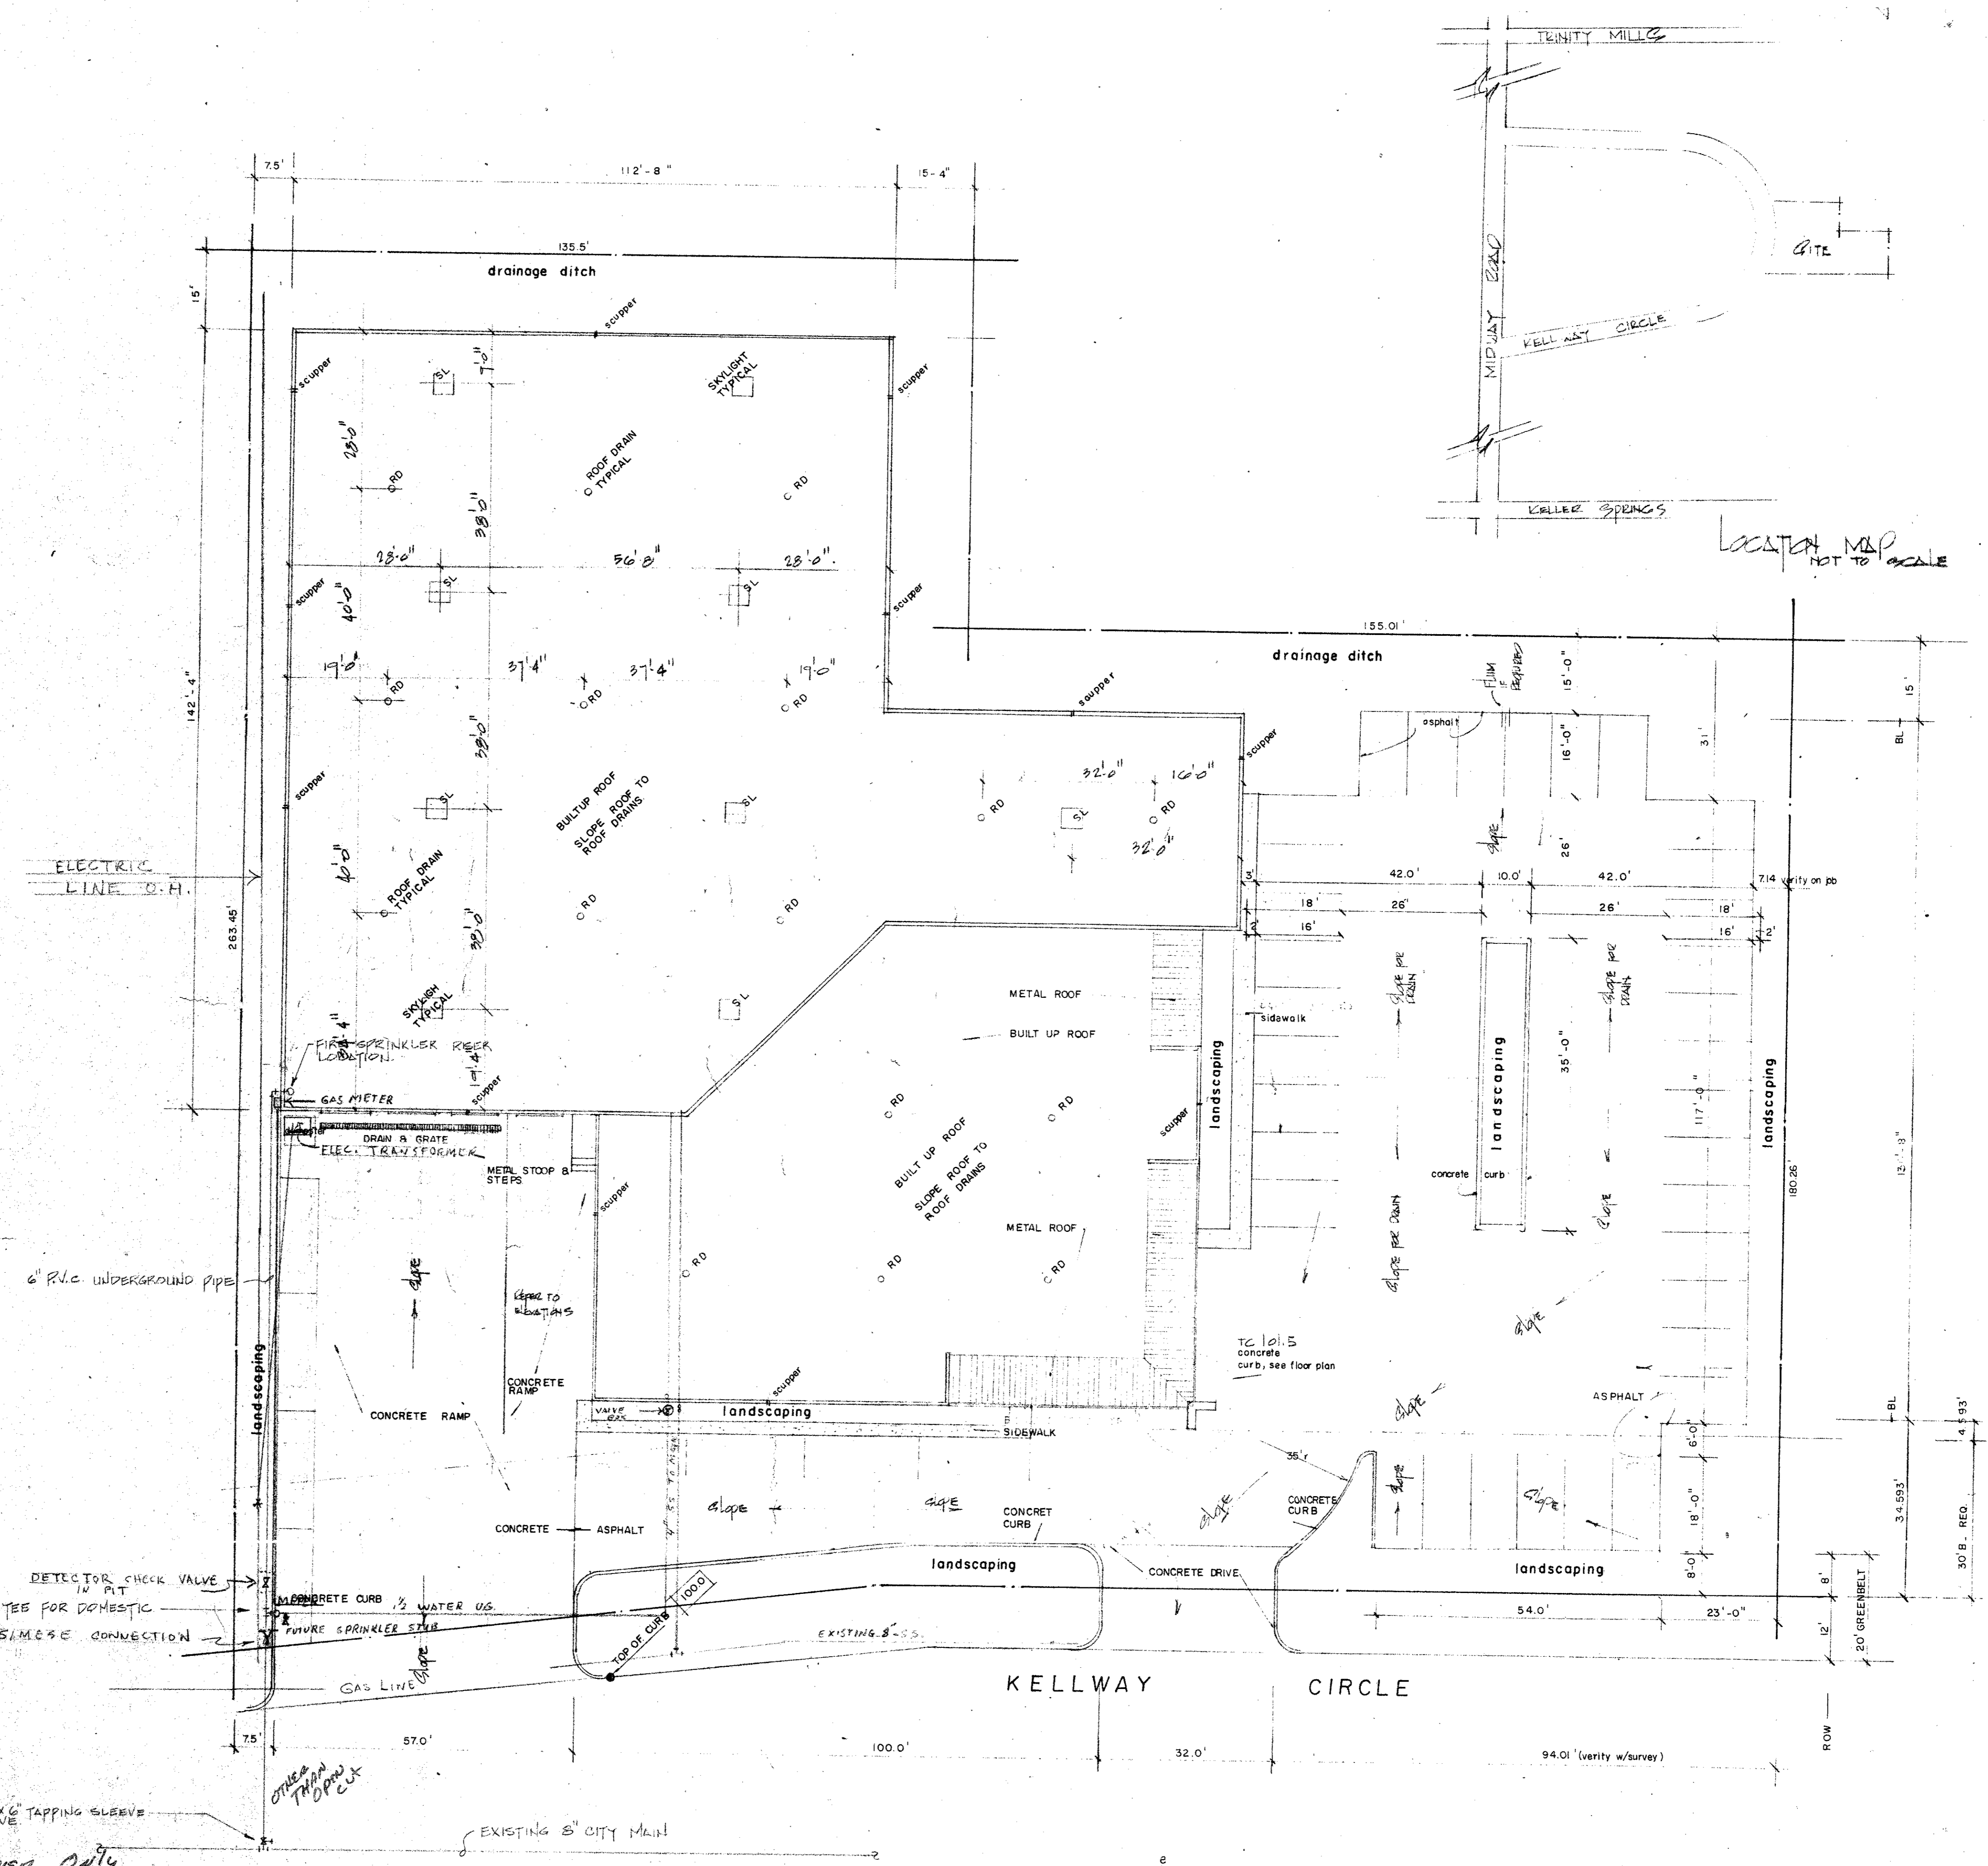

CHARLES R. LITTLE - ARCHITECT

R. C. SMALL AND ASSOCIATES, INC.
 GENERAL CONTRACTOR

WAREHOUSE, OFFICE and SHOWROOM
 DALMAS ASSOCIATES, INC.

28-04
 28-04
 2-23-88

MP-E-1