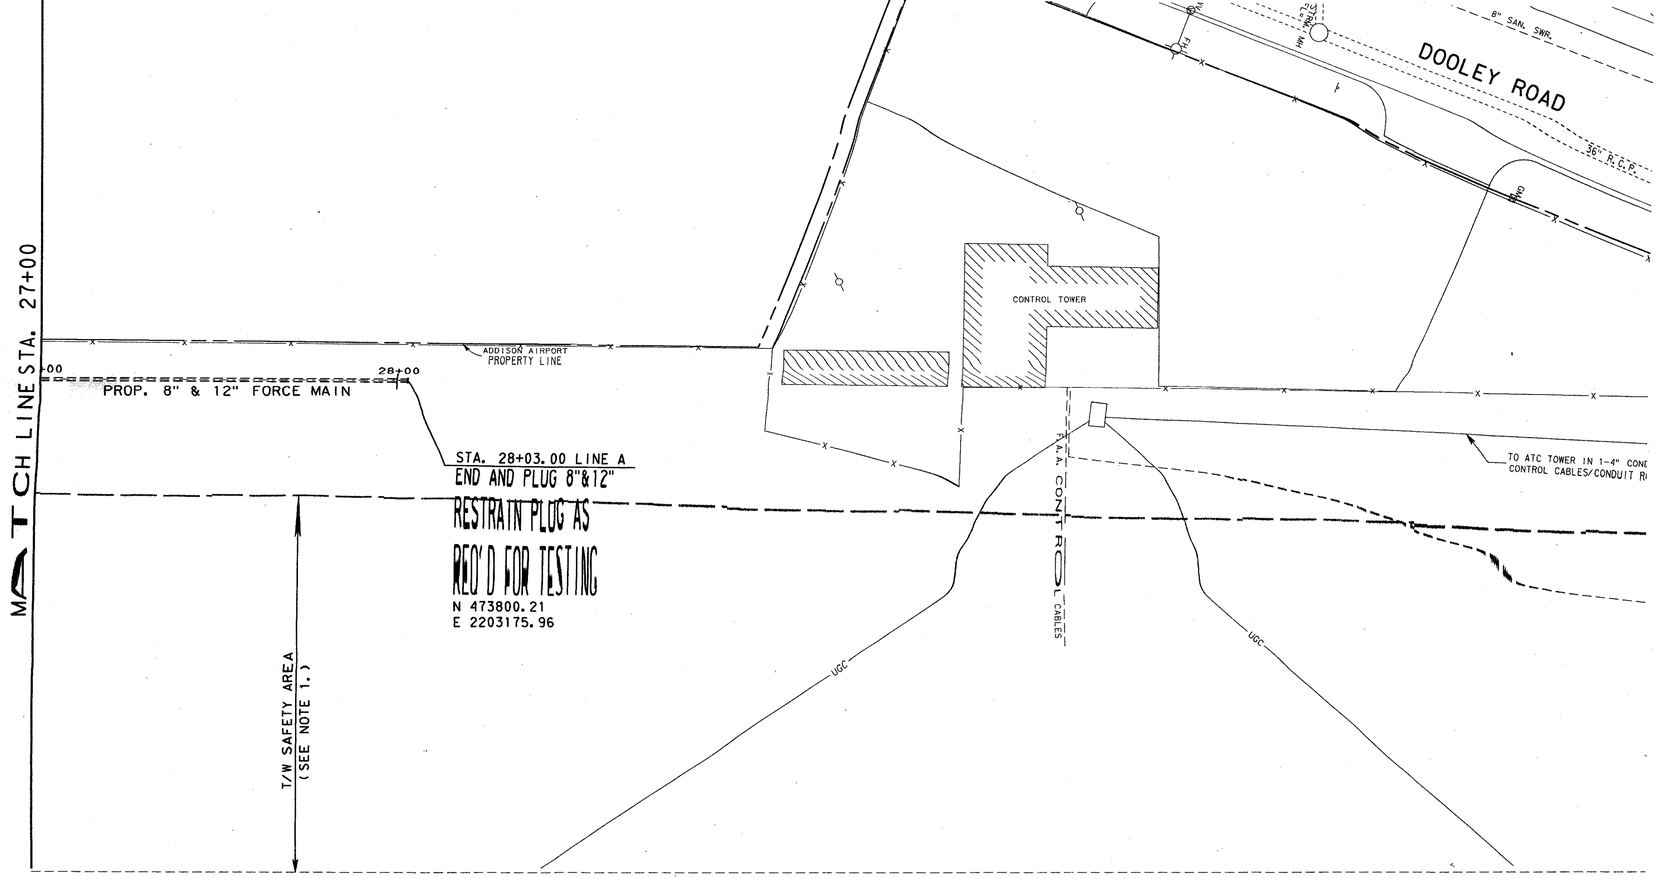

0 20 40
GRAPHIC SCALE IN FEET

NOTES:

1. CONTRACTOR SHALL BE PROHIBITED FROM ACCESSING OR CONDUCTING ANY ACTIVITIES WITHIN THE T/W SAFETY AREA.
2. CONTRACTOR SHALL RESTRICT ACCESS TO CONSTRUCTION AREA FROM WILEY POST RD.

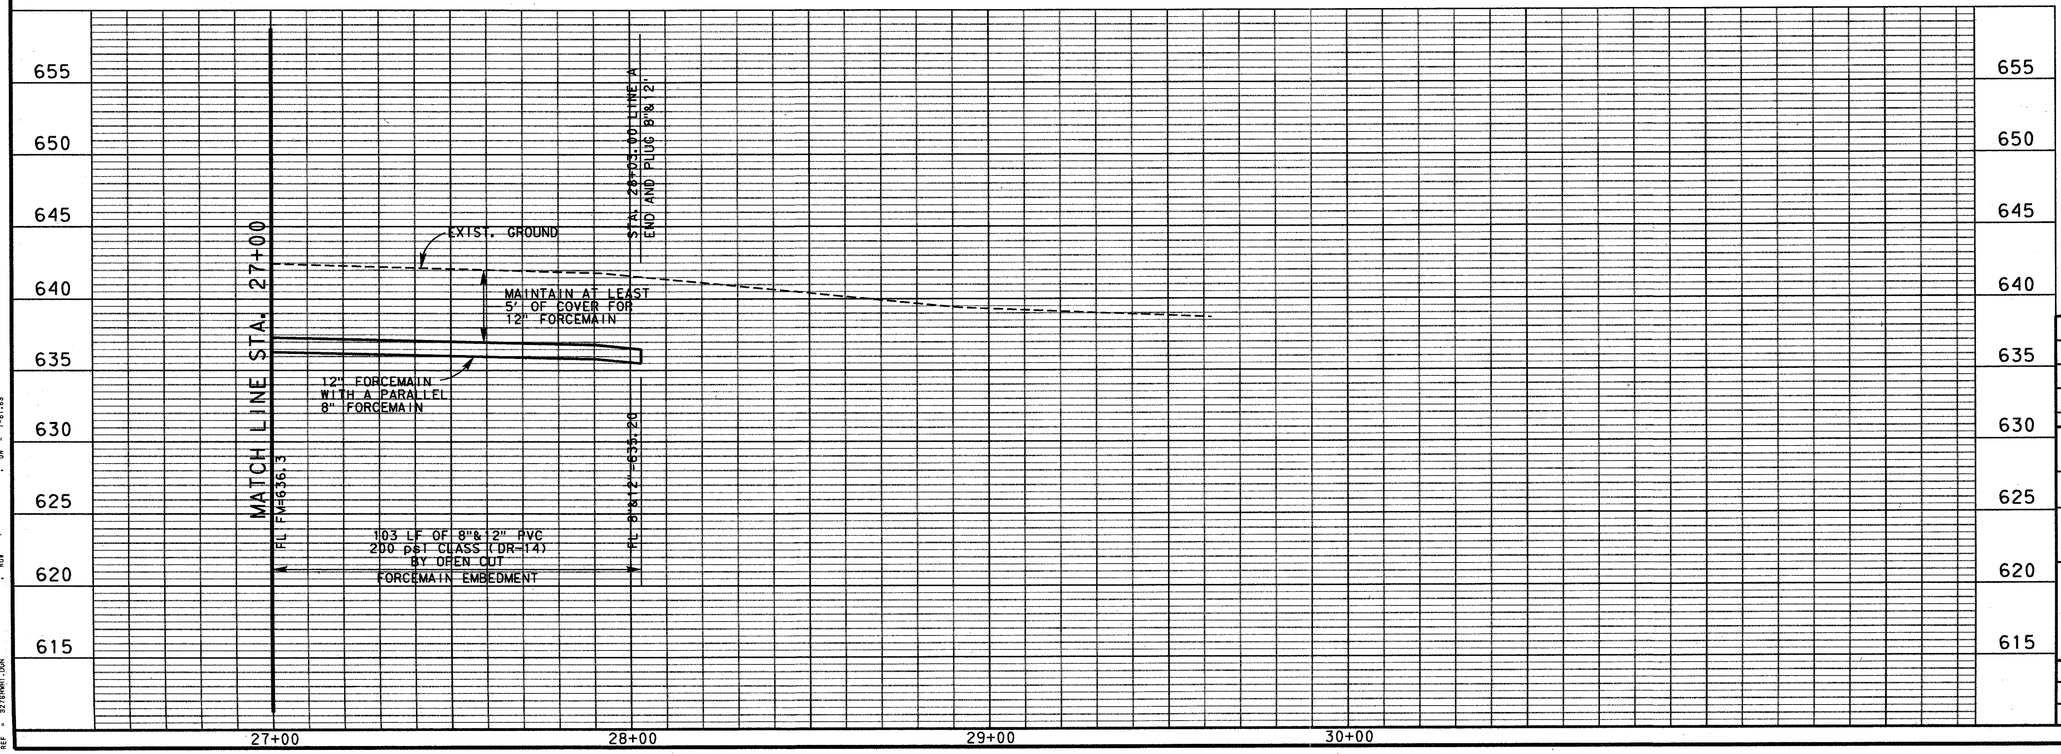

STATE OF TEXAS
JOHN H. LINDNER
64694
REGISTERED PROFESSIONAL ENGINEER
3/24/95

NO.	DATE	REVISION	APPROV.
4			
3			
2			
1			

TOWN OF ADDISON, TEXAS

MIDWAY/BELTLINE SANITARY SEWER

SANITARY SWR. PLAN & PROFILE
FROM STATION 27+00 TO STATION 28+03

Carter::Burgess
Consultants in Engineering, Architecture, Planning and the Environment
CARTER & BURGESS, INC.
7950 ELMBROOK DRIVE, SUITE 250
DALLAS, TX 75247-4961

Unit		Scale Horiz. 1"=20' Vert. 1"=5'	Date 03-23-95
Designed	D. Moore	Checked J. Lindner	Job No. 933276010
Drawn	B. Sowels	Approved J. Lindner	Sheet 9 of 11

3276ss27.DGN