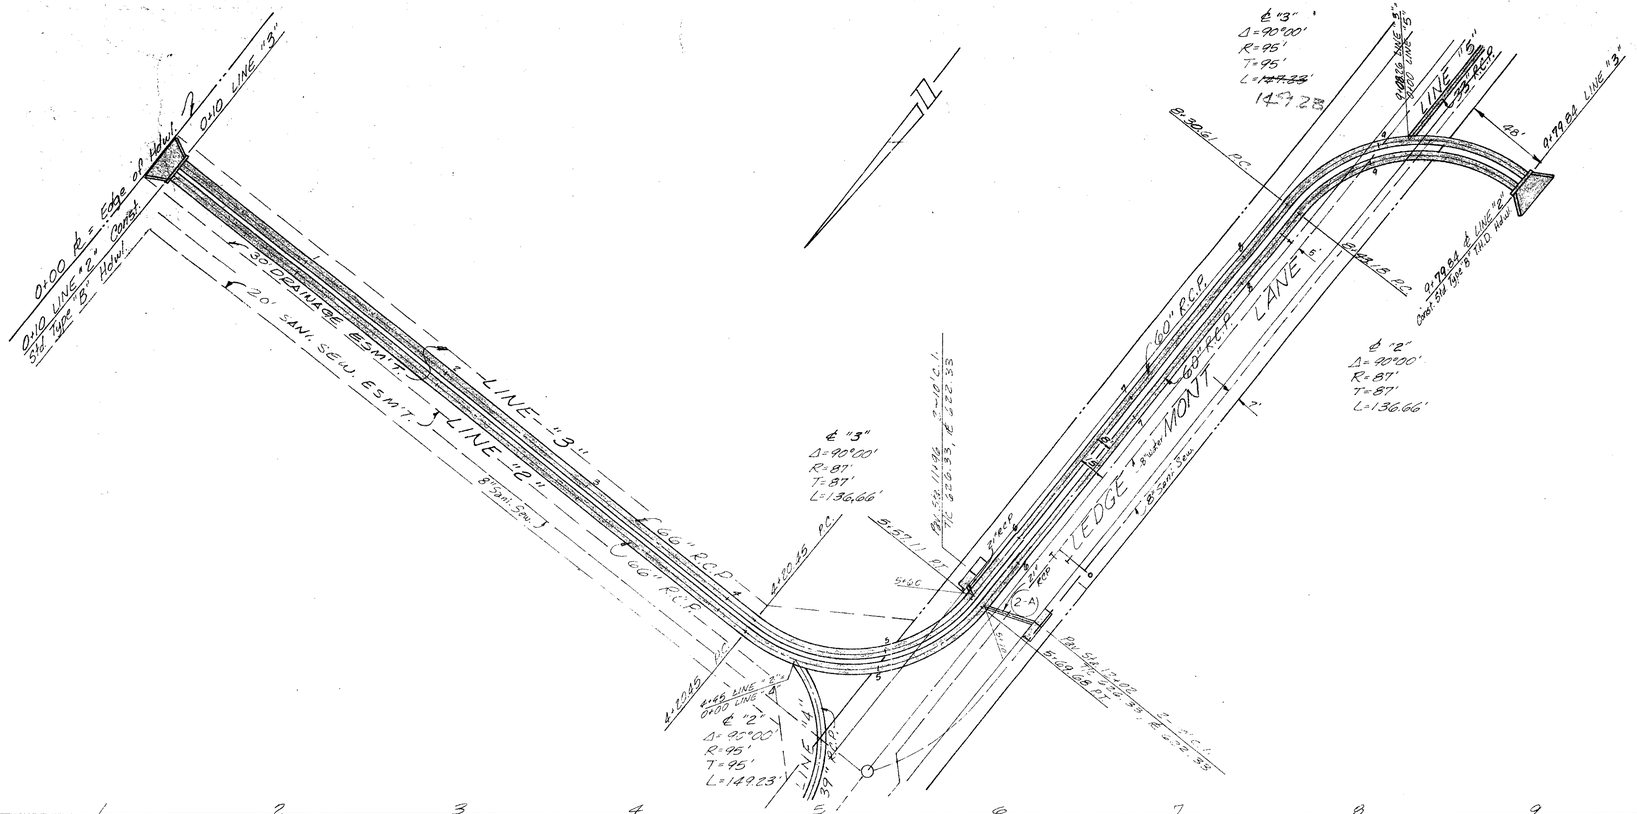


| NO. | DATE | BY | REVISION |
|---|---|---|---|
| 1 | 3-8-79 | RE | Changed location of Inlets |

BENCH MARK: Top of F.H. at northwest corner of Westgrove Dr. and Dallas Parkway. Elev. 621.01

BENCH MARK: 60d nail in power pole no. AG-118-114 east side of Addison Road, first pole south of Kemp Eng. Co. Elev. 638.78

| DESIGN | DRAWN | CHECKED | DATE | SCALE | JOB | SHEET |
|---|---|---|---|---|---|---|
| ARW | RE | ARW | 11-75 | 1"=40' H 1"=4' V | 926-E | 4 of 7 |

PLATE No. 7