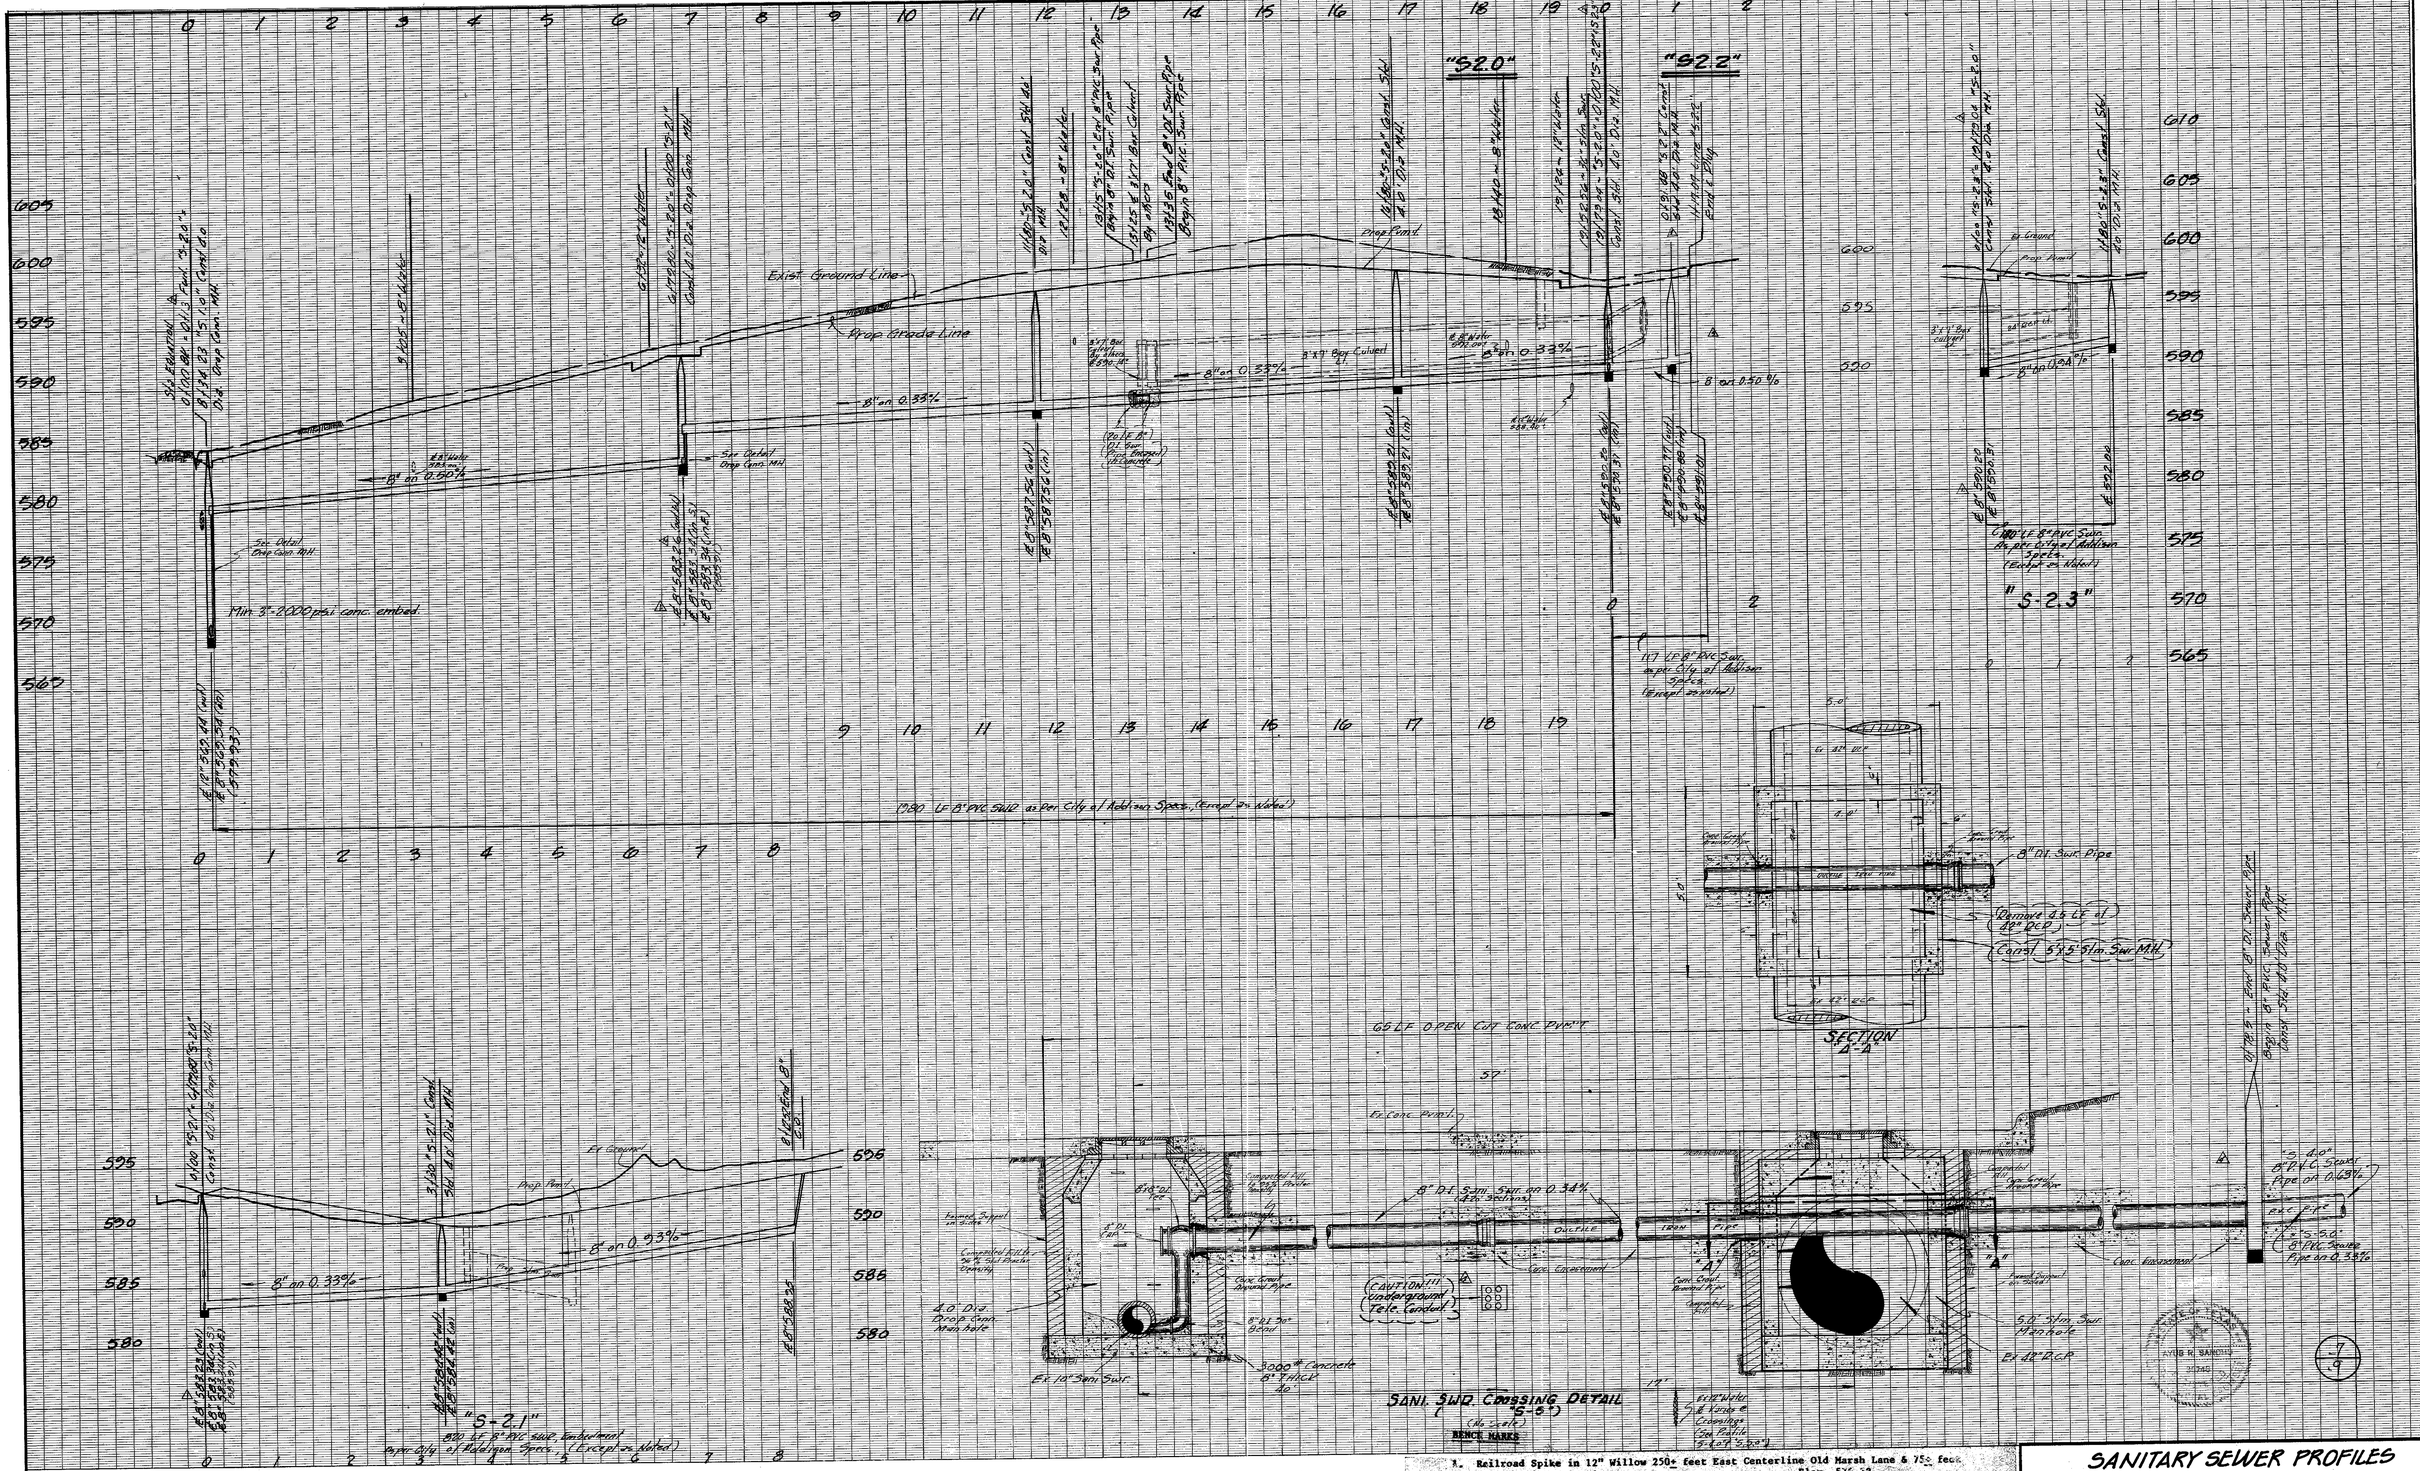
"S2.0"
"S2.2"
"S-2.3"
"S-2.1"
Exist. Ground Line
Prop Grade Line
Prop Pvmt
Ex Ground
Prop Pvmt
8" on 0.33%
8" on 0.50%
3'x9' Box Culvert
Min 3"-2000 psi conc. embed.
(17) LF 8" PVC Sewer as per City of Addison Specs. (except as noted)
(7) LF 8" PVC Sewer as per City of Addison Specs. (except as noted)
(7) LF 8" PVC Sewer as per City of Addison Specs. (except as noted)
870 LF 8" PVC SWR, Embankment per City of Addison Specs. (Except as Noted)
66 LF OPEN CUT CONC PVMT
8" Dia. Swr. Pipe
Remove 4.5 LF 42" RCP
Const 5'x5' S/m. Swr MH
SECTION A-A
8" Dia. Storm Pipe at 0.63%
5'-0" Dia. Storm Manhole
Ex 42" RCP
Ex 10" Sani. Swr.
3000# Concrete 8" THICK
SANI. SWR CROSSING DETAIL
(S-5)
(No Scale)
CAUTION!!! Underground Tele. Conduit
Concrete Encasement
Concrete Cradle
Concrete Saddle
