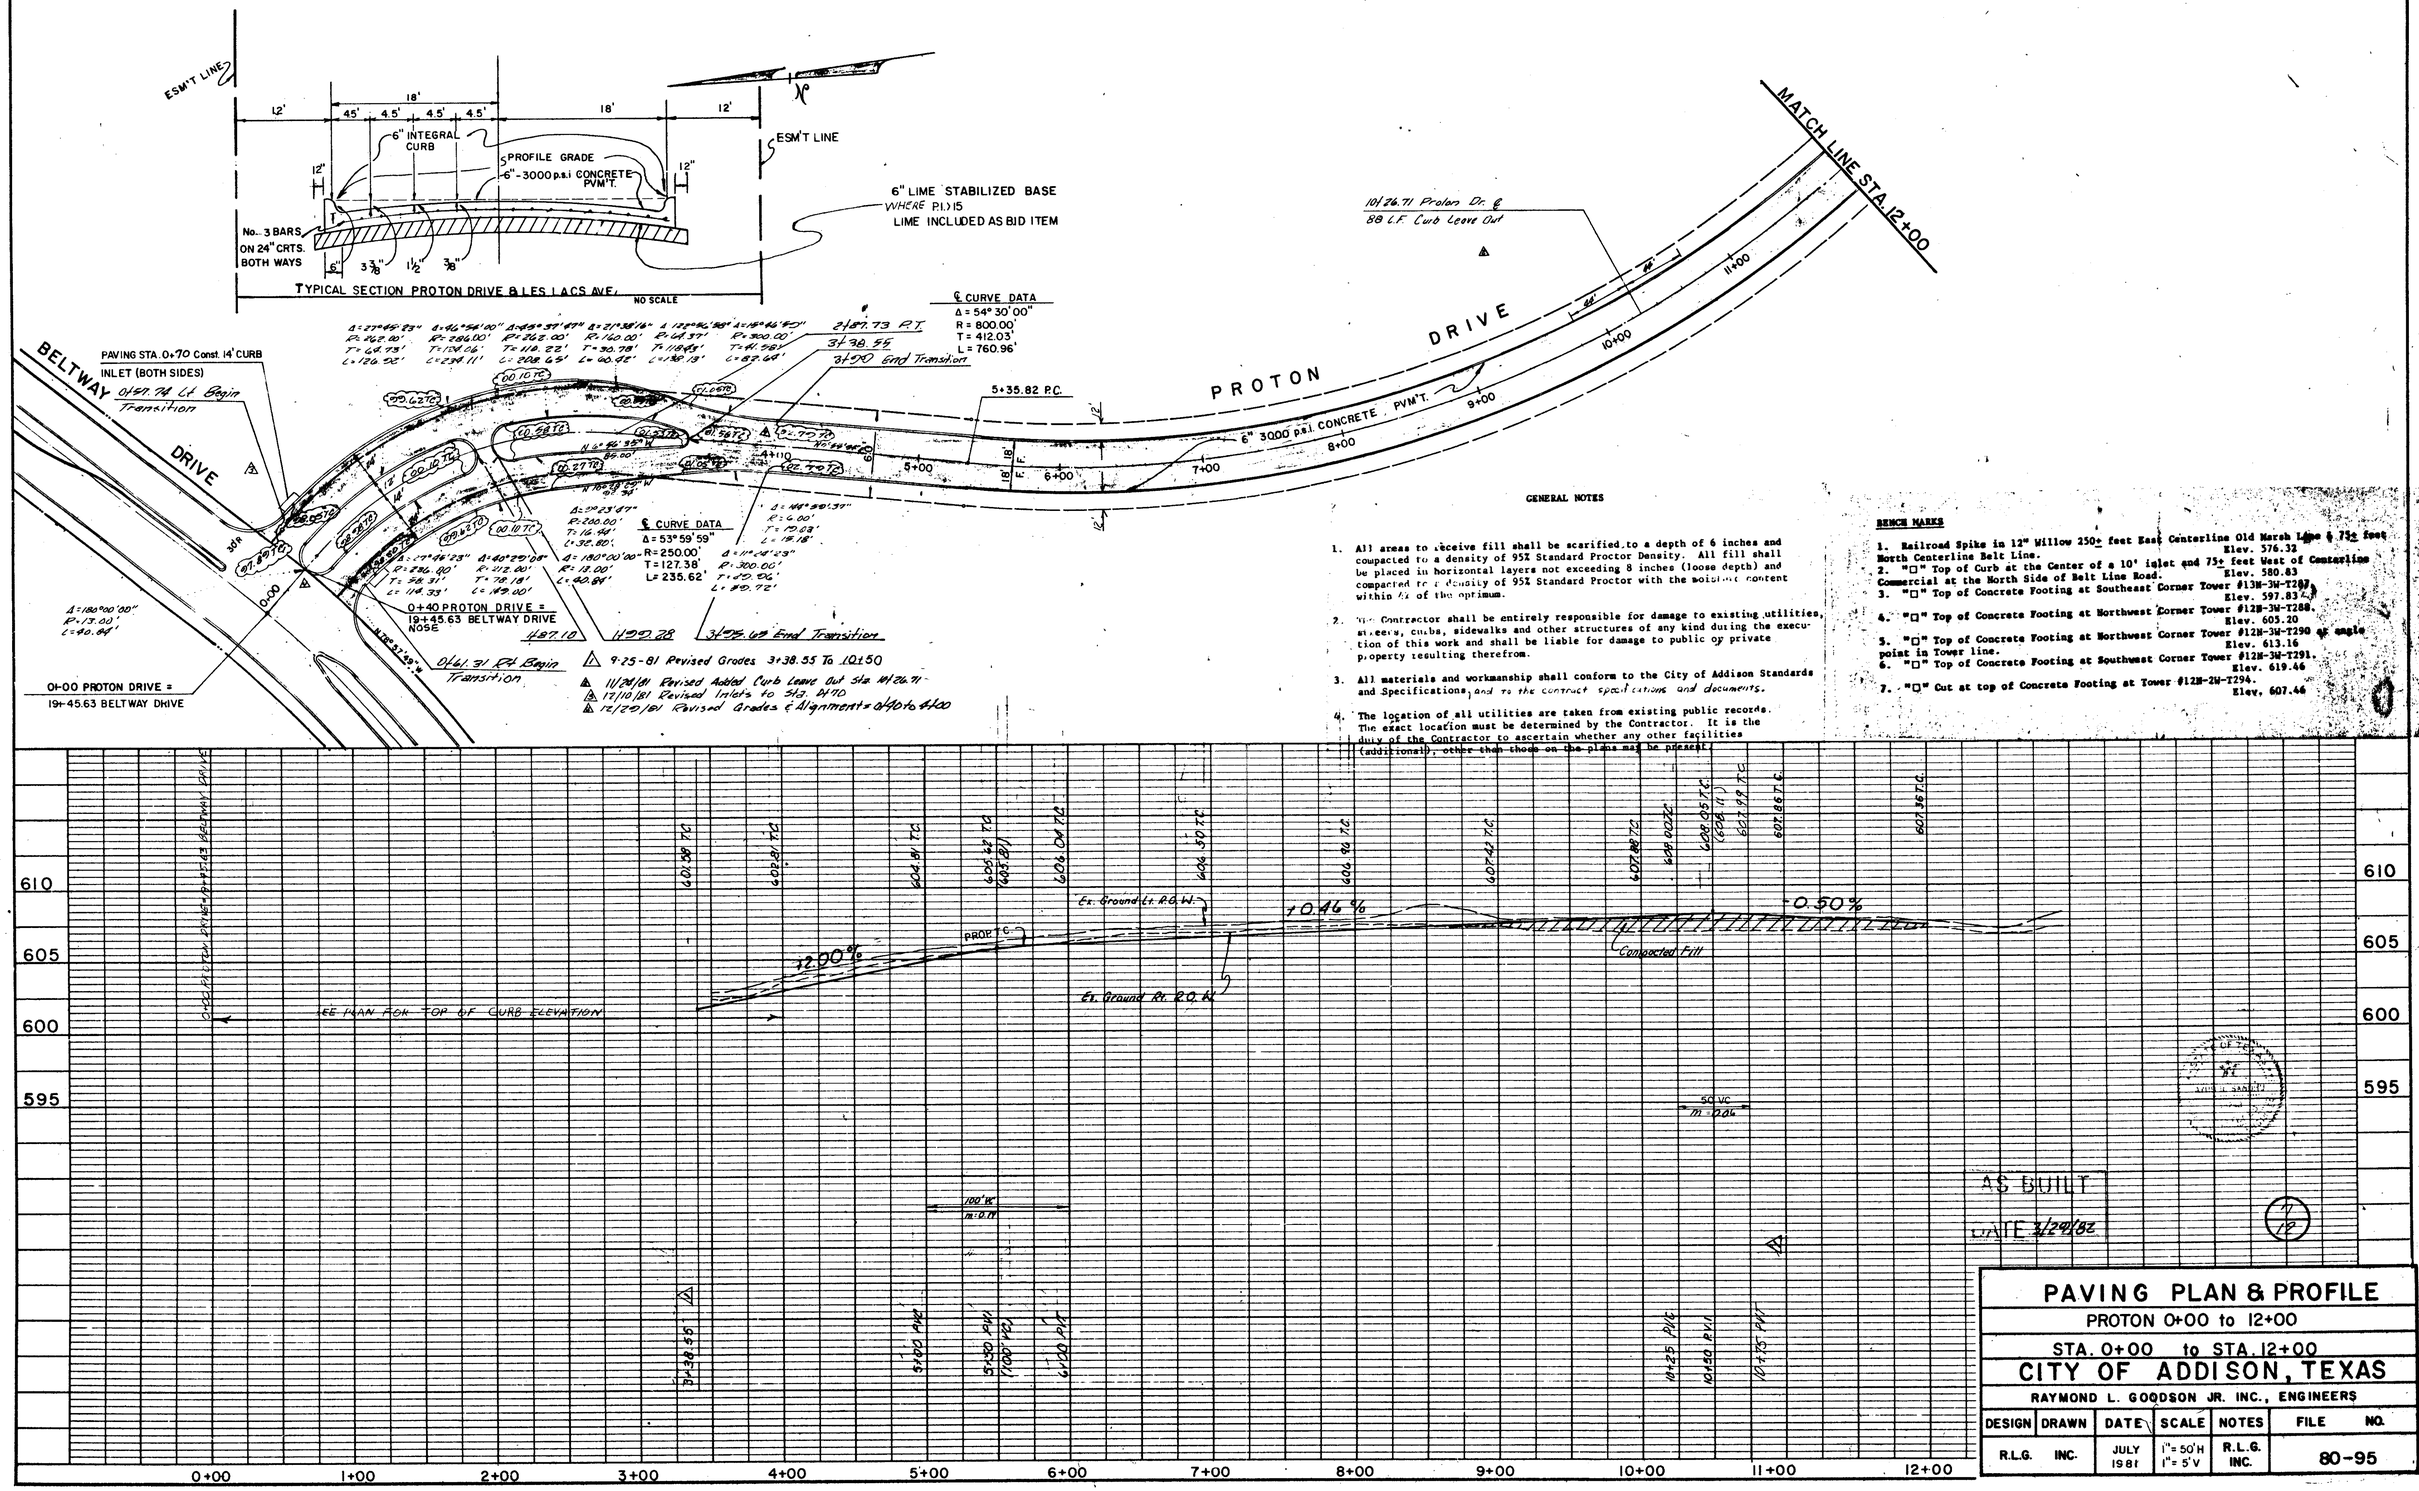

PLAN — SURVEYED, ALIGNMENT CHECKED, R/W OF WAY CHECKED, NOTE BOOK, No., BY, DATE

PROFILE — SURVEYED, PLOTTED, CHECKED, NOTE BOOK, No., % & % NOTED, STRUCTURE REVISIONS CHECKED, BY, DATE

AS BUILT
DATE 3/29/82

PAVING PLAN & PROFILE

PROTON 0+00 to 12+00

STA. 0+00 to STA. 12+00

CITY OF ADDISON, TEXAS

RAYMOND L. GOODSON JR. INC., ENGINEERS

DESIGN	DRAWN	DATE	SCALE	NOTES	FILE NO.
R.L.G. INC.		JULY 1981	1"= 50' H 1"= 5' V	R.L.G. INC.	80-95