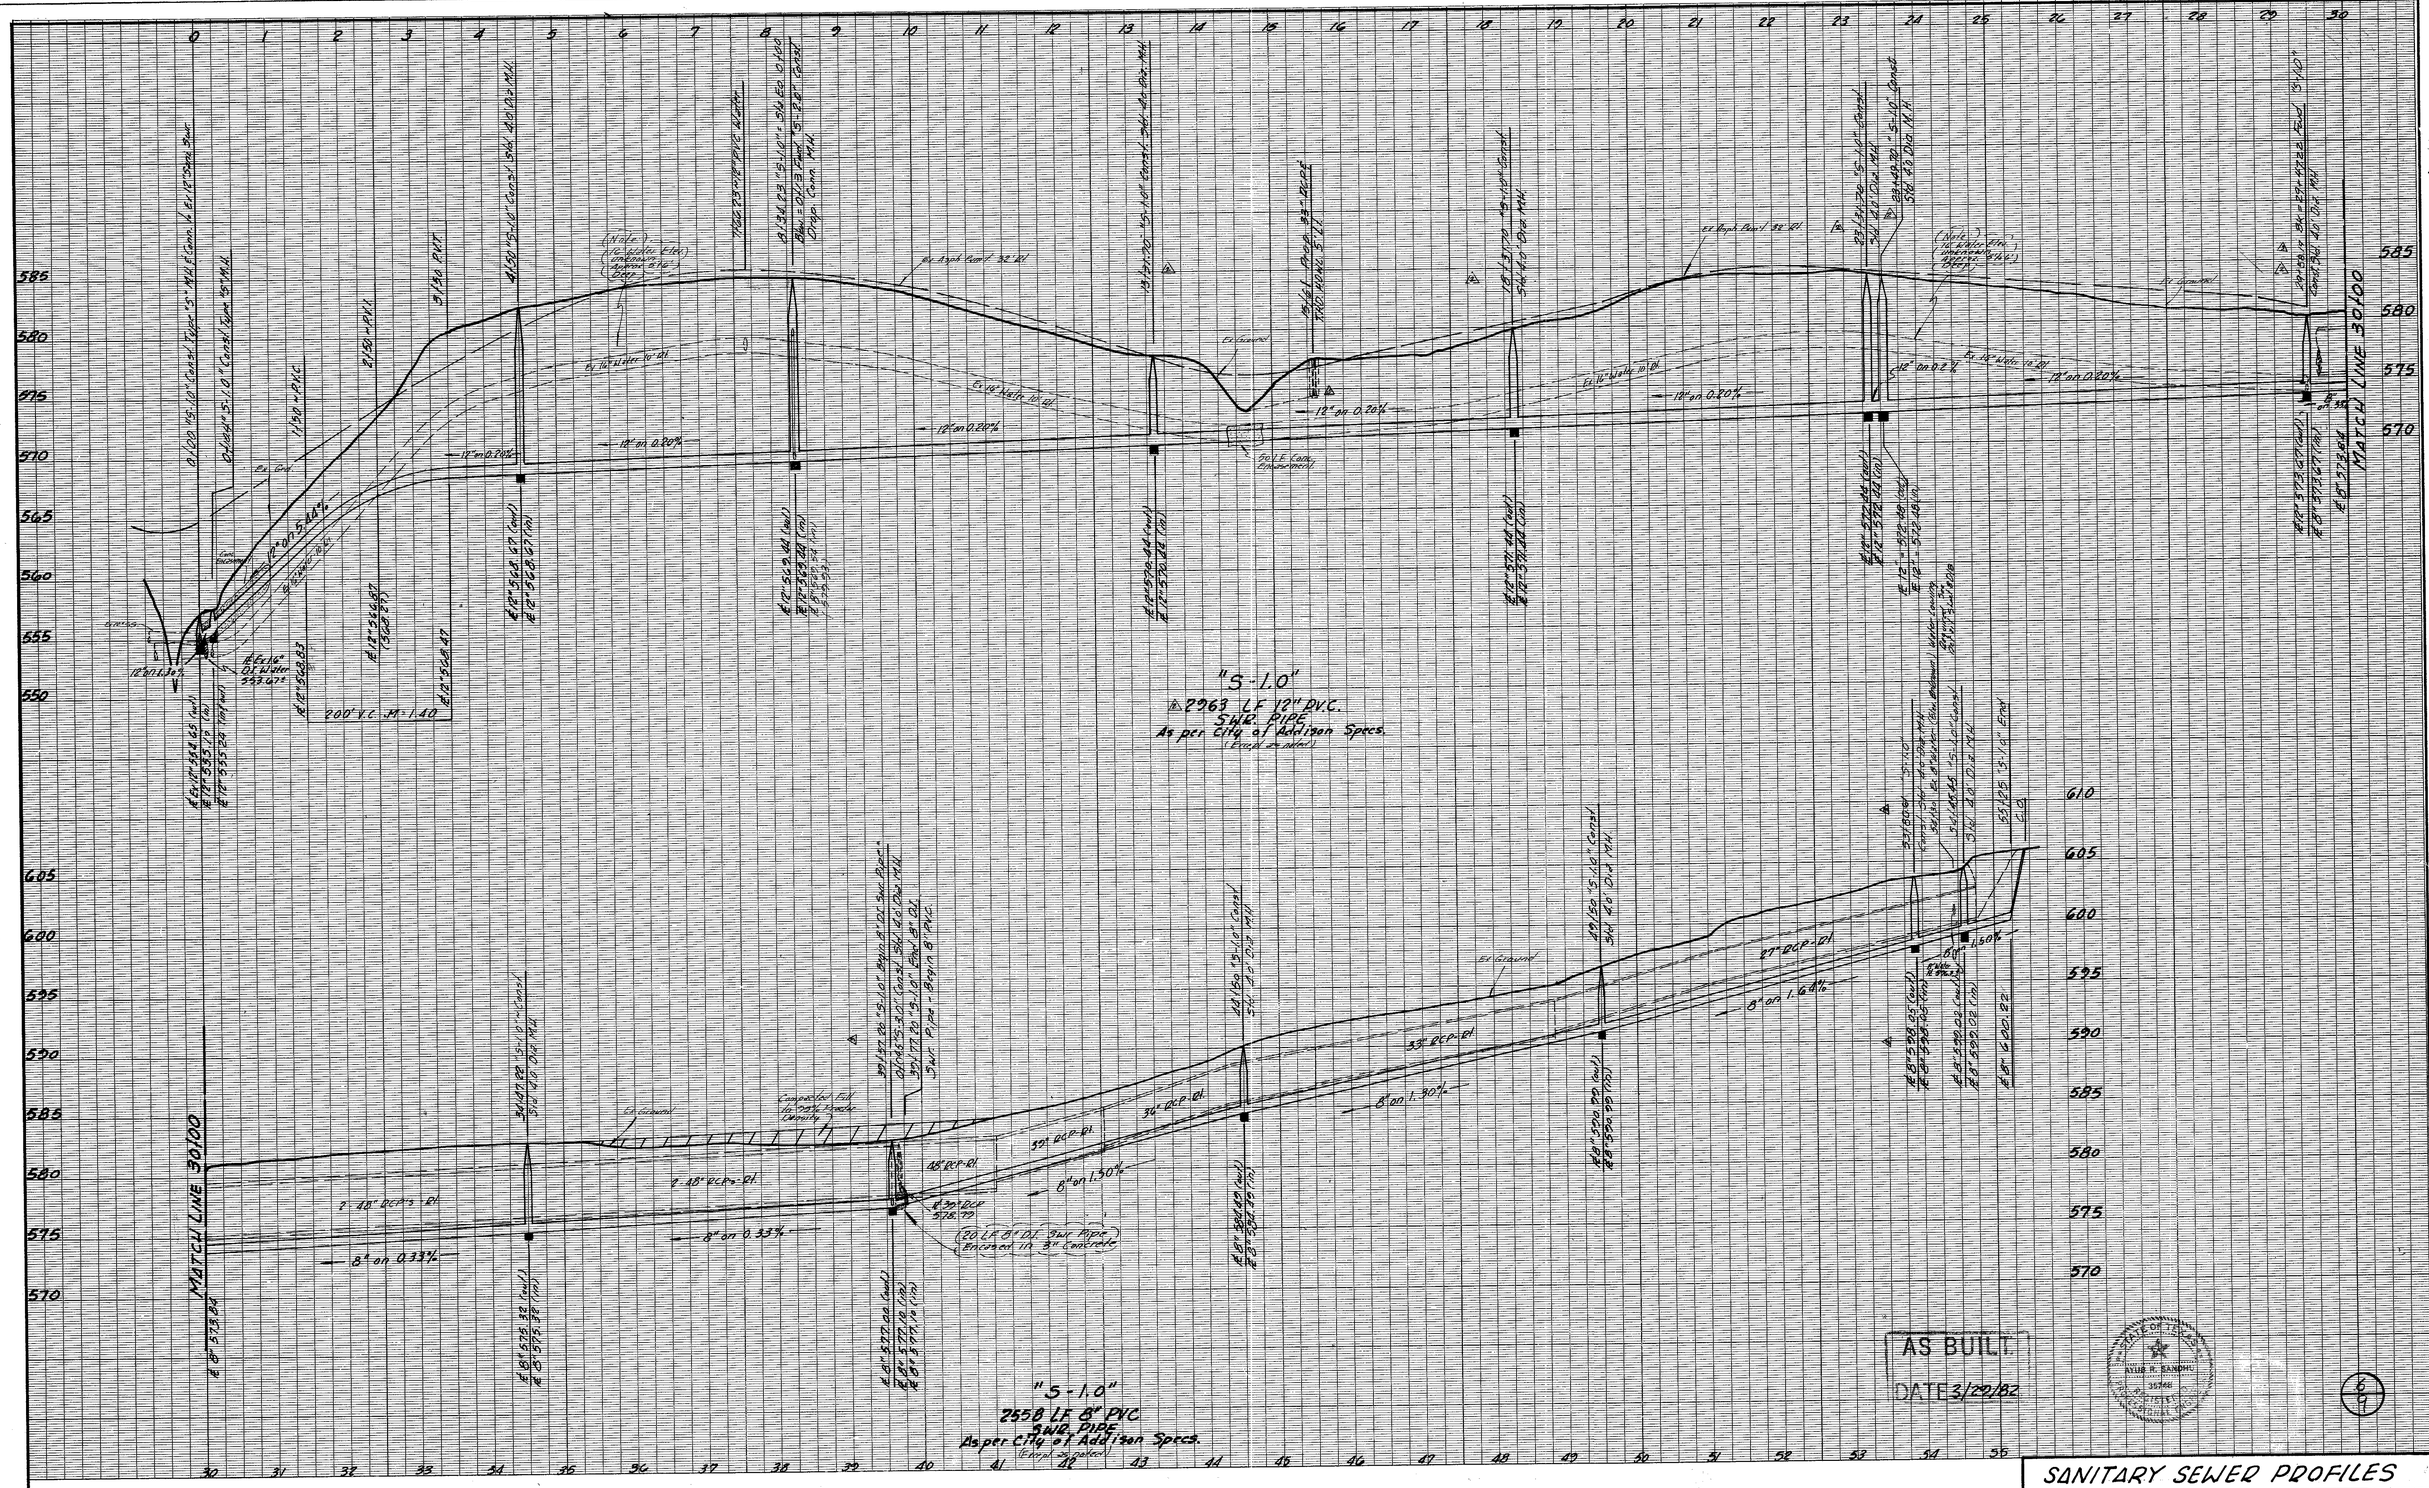

△ 9/1/81 Revised stations Line "S-1.0"
Added M.H. E
18 L.F. 12" PVC.
△ 9/30/81 Revised stations Line "S-1.0"

SANITARY SEWER PROFILES						
LINE "S-1.0"						
LES LACS VILLAGE INC.						
RAYMOND L. GOODSON JR. INC. ENGINEERS						
CITY OF ADDISON, TEXAS						
DESIGN	DRAWN	DATE	SCALE	NOTES	FILE	NO.
R.L.G.	R.L.G.	Aug, 1981	1"=100'H 1"=6'V.	R.L.G.		