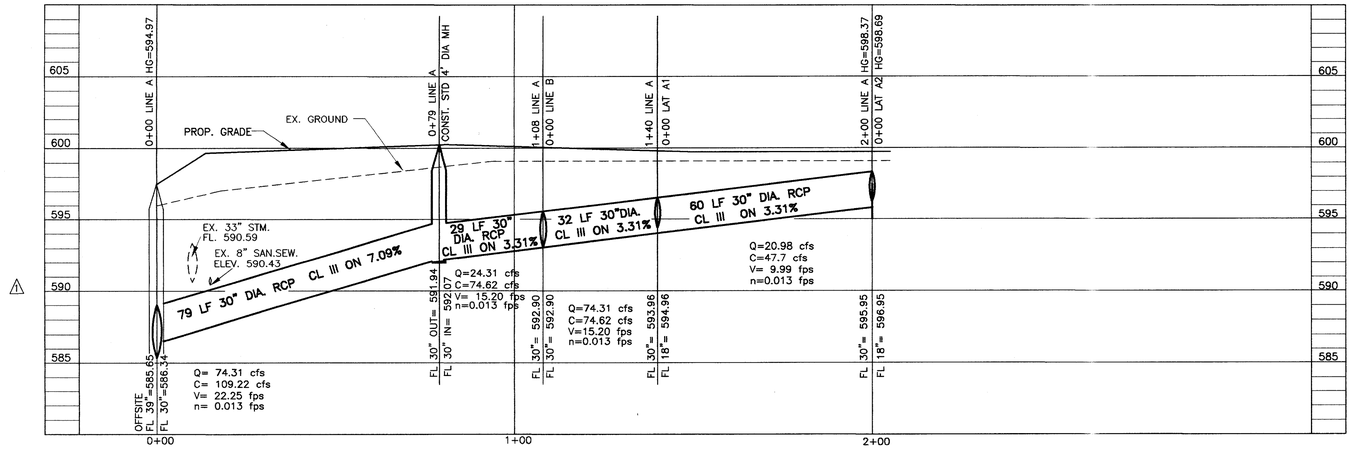

LINE A

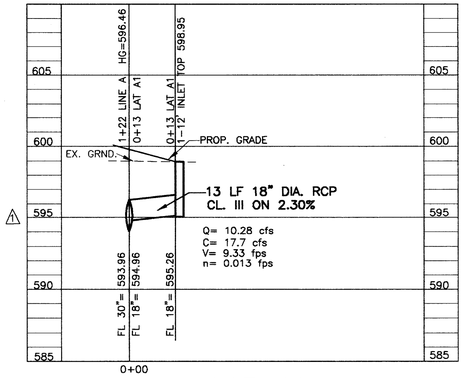

LAT. A1

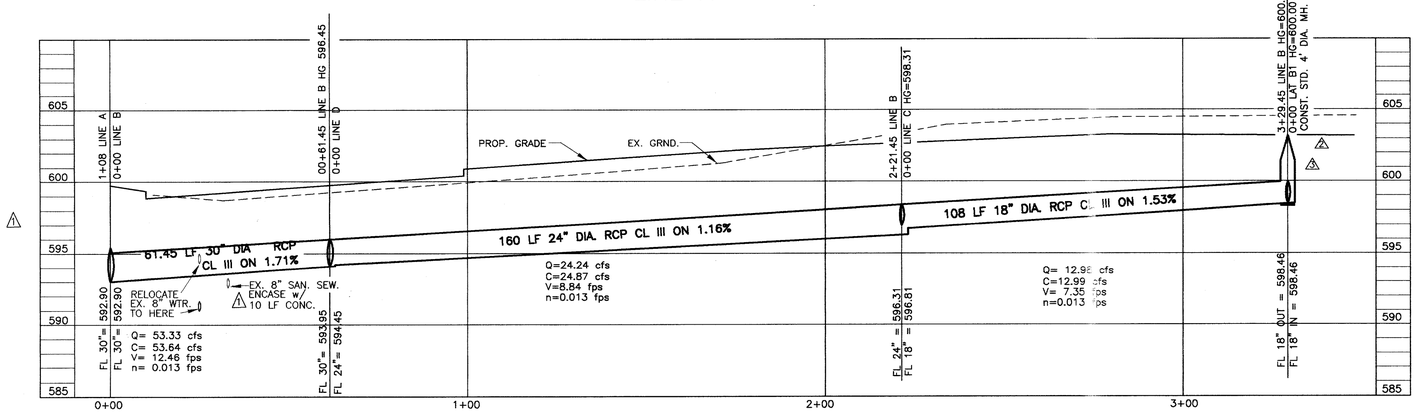

LINE B

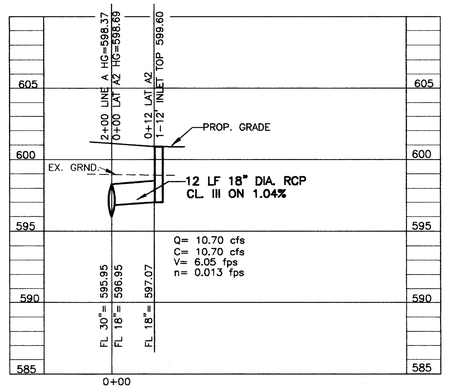

LAT. A2

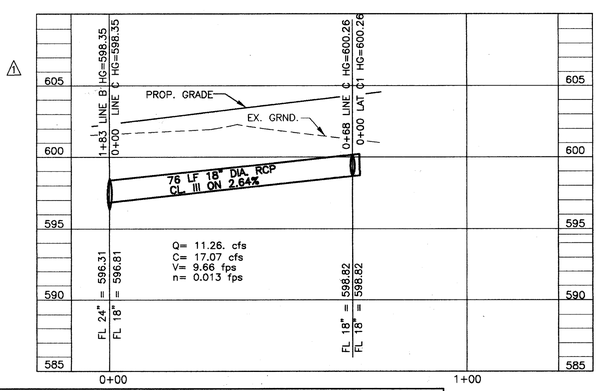

LINE C

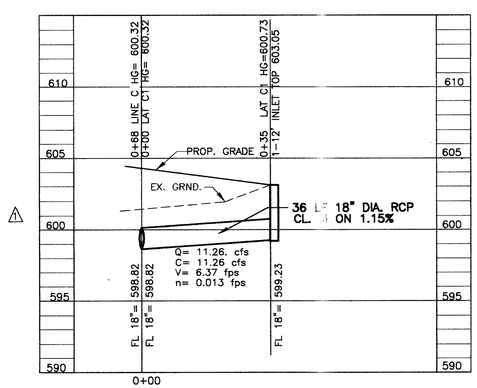

LAT. C1

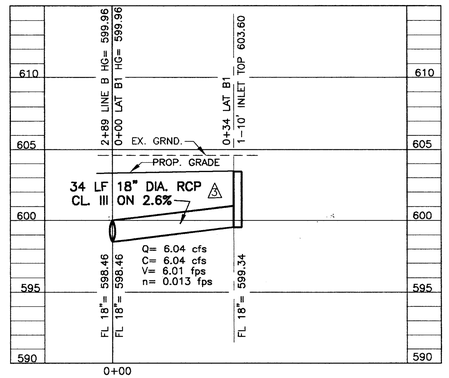

LAT. B1

THE DRAWING, SPECIFICATIONS, AND OTHER DOCUMENTS PREPARED BY COOK CONSULTANTS, INC. FOR THIS PROJECT ARE INSTRUMENTS OF PROFESSIONAL SERVICE, AND AS SUCH, ARE RESERVED AND PROTECTED BY STATUTE. COOK CONSULTANT, INC. AS AUTHOR RETAINS OWNERSHIP OF THE DOCUMENTS, INCLUDING THE COPYRIGHT. THE DRAWINGS AND OTHER DOCUMENTS MAY NOT BE REPRODUCED OR USED BY ANYONE FOR ANY REASON WITHOUT THE EXPRESS WRITTEN CONSENT OF COOK CONSULTANTS, INC.

THESE DRAWINGS ARE PROVIDED FOR "AS-BUILT" DRAWINGS BY OTHERS FOR THE CITY OF ADDISON

NOTE:

STORM SEWER EMBEDMENT SHALL CONFORM TO THE TOWN OF ADDISON SPECIFICATIONS

REV. NO.	PROJ. NO.	DESCRIPTION	DATE
3		REVISED LINE B & LAT. B1	7/11/96
2		REVISED PER CITY COMMENTS	5/21/96
1		REVISED PER CITY COMMENTS	5/03/96

STORM SEWER PROFILES

TOWN HOMES OF ADDISON

DEPARTMENT OF PUBLIC WORKS

TOWN OF ADDISON, TEXAS

DATE: _____

PROJECT NO. 81215-35

DESIGN	DRAWN	DATE	SCALE	NOTES	FILE	NO.
LD	LAC	9/15/95	1"=20'H 1"=5'V	CCI		