1"=100'

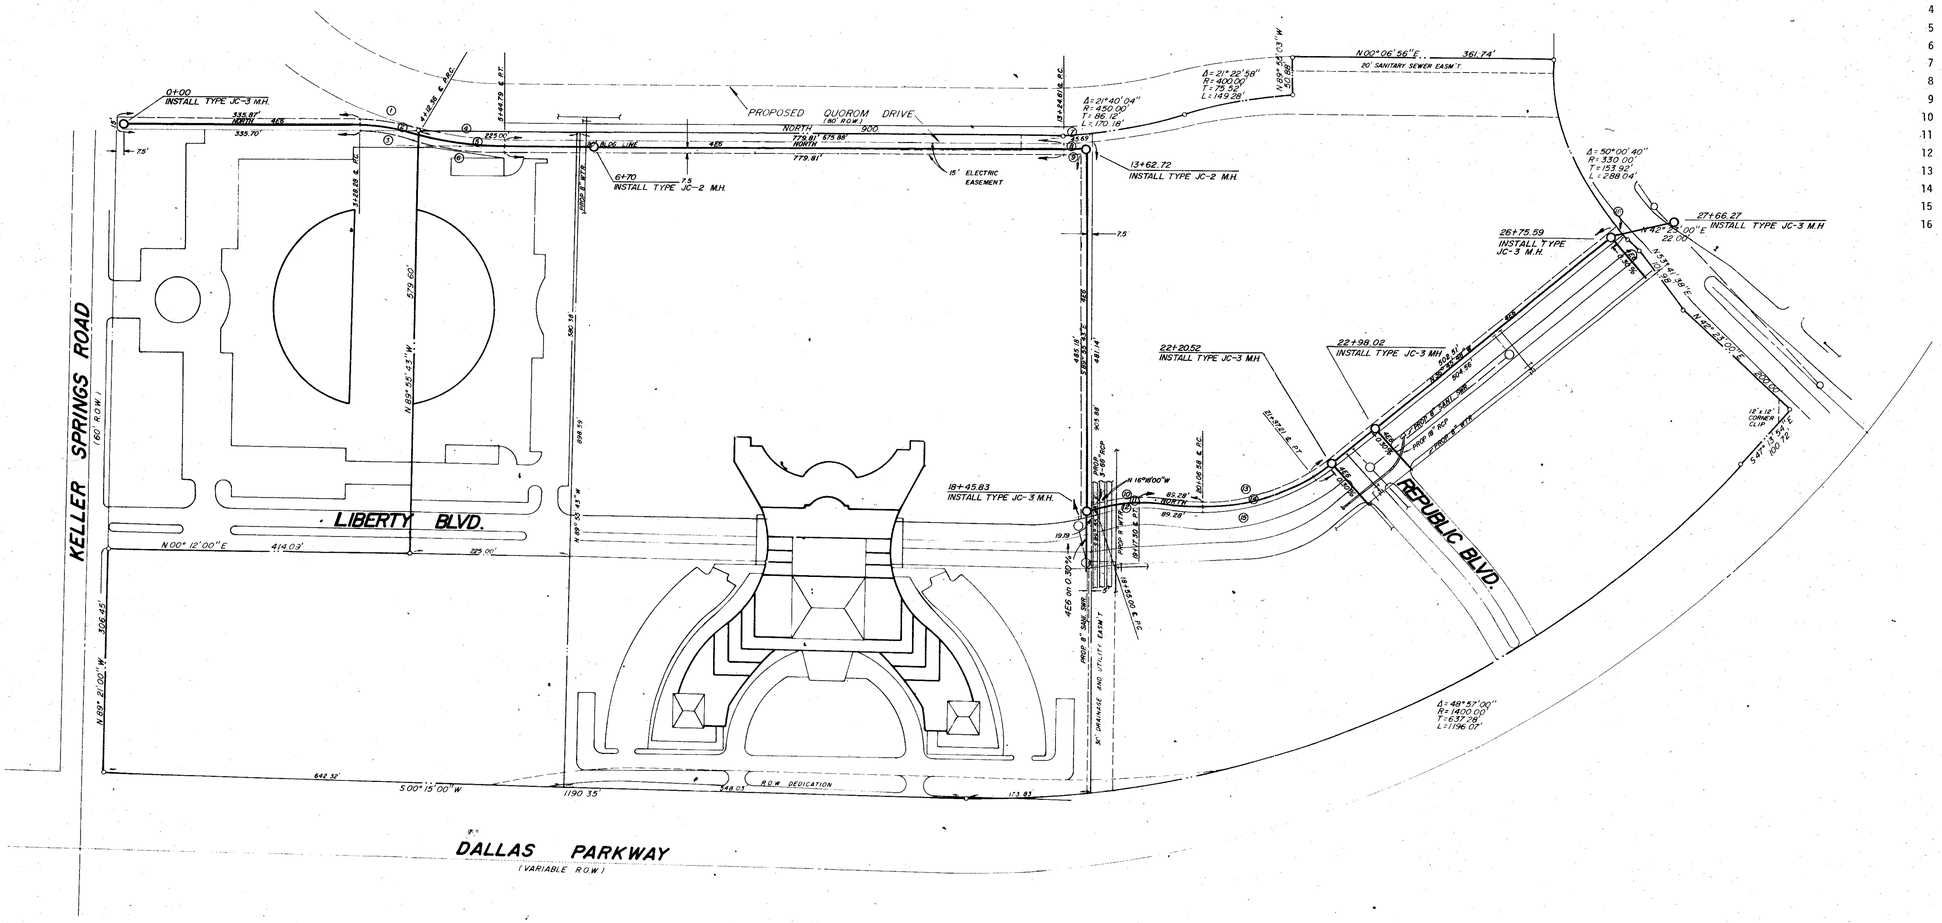
KELLER SPRINGS ROAD
LIBERTY BLVD.
REPUBLIC BLVD.
DALLAS PARKWAY
(VARIABLE R.O.W.)
PROPOSED QUOROM DRIVE
(80' R.O.W.)
NORTH 675.88'
NORTH 900
779.81'
779.81'
0+00
INSTALL TYPE JC-3 M.H.
6+70
INSTALL TYPE JC-2 M.H.
13+62.72
INSTALL TYPE JC-2 M.H.
18+45.83
INSTALL TYPE JC-3 M.H.
22+20.52
INSTALL TYPE JC-3 M.H.
22+98.02
INSTALL TYPE JC-3 M.H.
26+75.59
INSTALL TYPE JC-3 M.H.
27+66.27
INSTALL TYPE JC-3 M.H
15' ELECTRIC EASEMENT
20' SANITARY SEWER EASM'T.
Δ=21°40'04"
R=450.00'
T=86.16'
L=170.18'
Δ=21°29'58"
R=400.00'
T=75.52'
L=149.98'
Δ=50°00'40"
R=330.00'
L=288.04'
Δ=48°57'00"
R=1400.00'
T=637.78'
L=1196.07'
N 00° 06' 56" E 361.74'
N 89° 55' 43" W 579.60'
N 00° 12' 00" E 414.03'
S 00° 15' 00" W 1190.35'
642.32'
248.03'
R.O.W. DEDICATION
175.83'
N 16°18'00" W
85.28'
N 42° 25' 00" E
22.00'
N 47° 35' 00" E
200.00'
12'x 12' CORNER CLIP
30' DRAINAGE AND UTILITY EASM'T
PROP 8" SAN. SWR.
PROP 8" W.L.
PROP 8" RCP
