


"CURVE DATA"

NO.	Δ	R	T	L
1	16°18'00"	200.00'	28.64'	56.90'
2	36°49'48"	300.00'	99.88'	192.84'
3	04°00'18"	180.25'	6.30'	12.60'
4	05°00'00"	219.75'	9.59'	19.18'
5	33°01'48"	180.25'	53.44'	103.91'
6	04°29'11"	200.00'	7.83'	15.66'
7	05°00'00"	200.00'	8.73'	17.45'
8	33°01'48"	200.00'	59.30'	115.30'

BM NO. 1
 SQUARE CUT ON TOP OF CURB AT THE RADIUS RETURN OF AN ISLAND LOCATED NEAR THE NORTHEAST CORNER OF LIBERTY PLAZA I, APPROXIMATELY 639 FEET NORTH OF THE SOUTHEAST PROPERTY CORNER.
 ELEV. 622.14

BM NO. 2
 CHISELED SQUARE ON THE END OF THE CURB RADIUS LOCATED ON THE DRIVEWAY ON THE NORTH SIDE OF KELLER SPRINGS ROAD, APPROXIMATELY 500 FEET WEST OF DALLAS PARKWAY.
 ELEV. 626.24

BOUNDARY INFORMATION IS FROM A SURVEY BY GEOGRAM CORP. DATED FEB. 1984

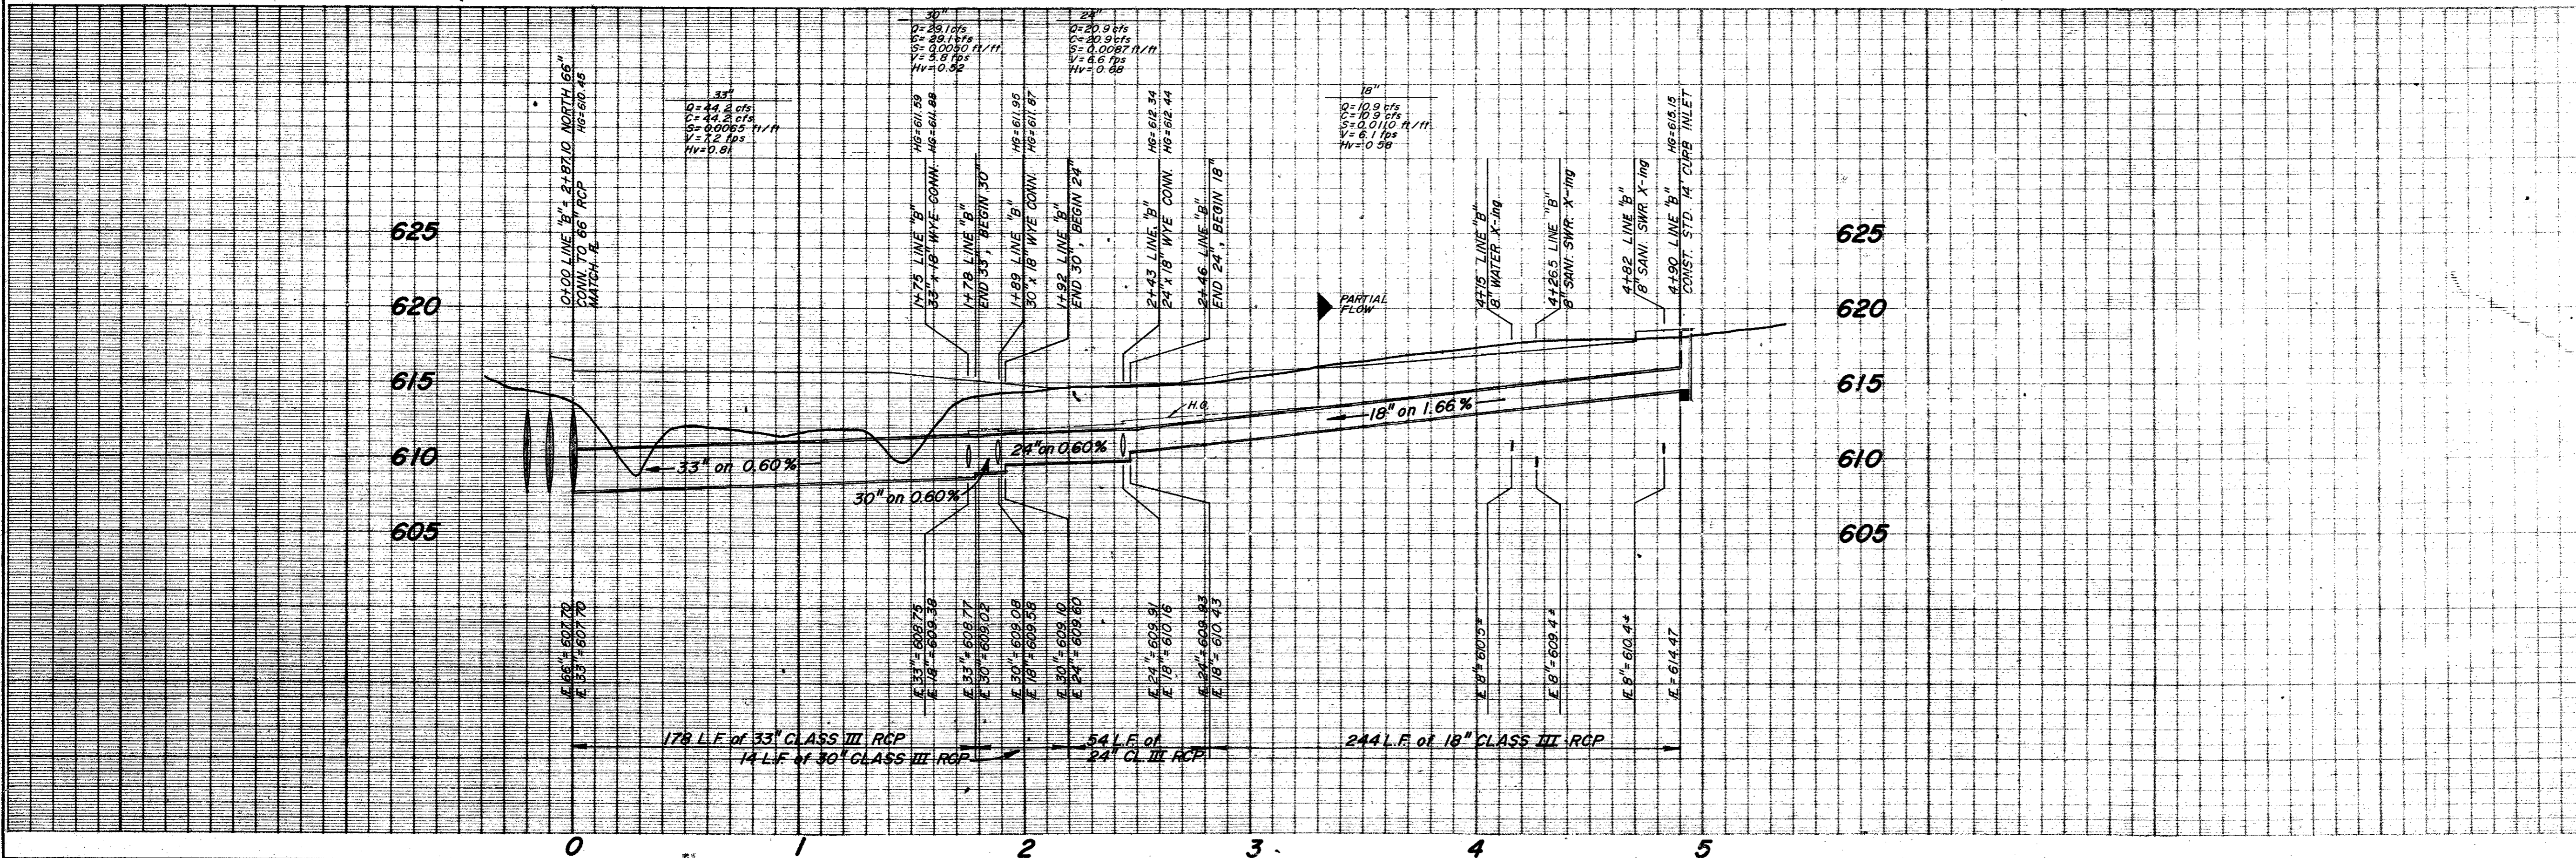

STORM SEWER LINE "B"
LIBERTY PLAZA
 T.F. STONE COMPANIES, INC.
 JACK R. DAVIS & ASSOCIATES-ENGINEERS
 3535 TRAVIS SUITE 100, DALLAS, TEXAS

DESIGN	DRAWN	DATE	SCALE	NOTES	FILE	NO.
D.W.H.	JAR	1/85	H'1"=40' V'1"=6'	D.R.	C84146	of