

FH TO BE SALVAGED AND RELOCATED BY G.C. SEE SHEET C-4

BENCHMARK STA. BM #5 CHISEL SQUARE ON CURB RADIUS AT FIRST DRIVE ON NORTH SIDE OF KELLEY SPRINGS ROAD, 150' EAST OF LIBERTY PLAZA BLDG. 300' WEST OF DALLAS HWY. ELEV. = 626.24

NOTE TOPOGRAPHIC INFORMATION FROM BOWES & ASSOC. DRAWING REVISED 4-9-84. DRAWING PREPARED FROM FILMWORK FURNISHED BY ARCHITECT.

**GINN, INC.**  
CONSULTING ENGINEERS  
DALLAS, TEXAS  
DATE RECEIVED 9-4-84  
DATE REVIEWED 9-18-84  
BY: [Signature]

TYPE I CONST, B-2 OCC.

INSPECTION REVIEW	HOLD	APPROVED	REVIEWED BY
BUILDING		8-30-84	CP
PLUMBING		9/24/84	J.C.B.
ELECTRICAL		OK per [Signature]	

- FIRE EXTINGUISHERS:  
Minimum rating 2A 10BC  
Maximum travel distance 75'  
Minimum one per 6,000 sq ft
- No sprinkler omissions
- Alarm system to be monitored at a constantly attended location
- Fire lanes to be to A.F.D.'s specs (attached)
- Fire hydrants 300' O.C.

SEE ATTACHED NOTE

DEPARTMENTAL REVIEW	HOLD	APPROVED	REVIEWED BY
FIRE			
ENGINEERING			
UTILITIES			
STREETS			
LANDSCAPE			

See notes C-4 & C-5

CONDUCT LINDA FOR USGMA APPROVAL BEFORE C.O.


OK per DEN 9-29-84

GENERAL NOTES


1. Type "A" light fixtures shall be removed by General Contractor and shall be relocated per Sheet GA 2.04.
2. Type "B" light fixtures shall be removed by General Contractor and shall be relocated per Sheet GA 2.04.
3. Soil boring locations provided by Hooper and Associates, Inc., per Report No. 84.179, Dated April 27, 1984.

**BLACK R. DAVIS & ASSOCIATES, INC.**  
consulting civil engineers & surveyors  
2902 Carlisle Street Dallas, Texas 75204

**HARWOOD K SMITH & PARTNERS**  
Architects/Engineers/Planners  
1111 Plaza of the Americas North, LB 307  
Dallas, Texas 75201 214/748-5261

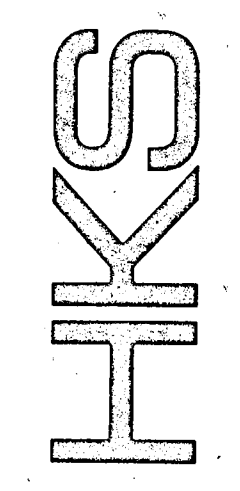

liberty plaza  
t.f. stone companies dallas, texas

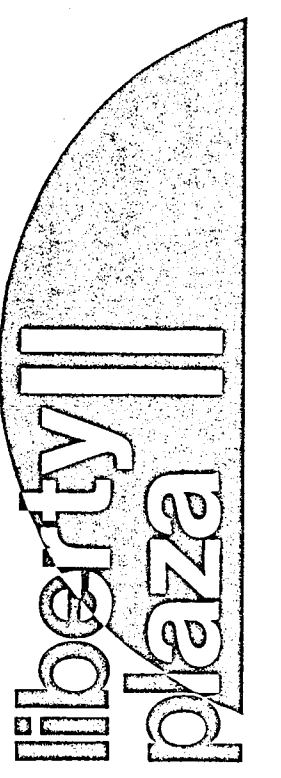

Job No: 1499  
Revisions:  
Sheet Title: TOPOGRAPHIC MAP  
Date: 7-24-84  
Drawn:  
Sheet No: C 1 of sheets