1"=100'

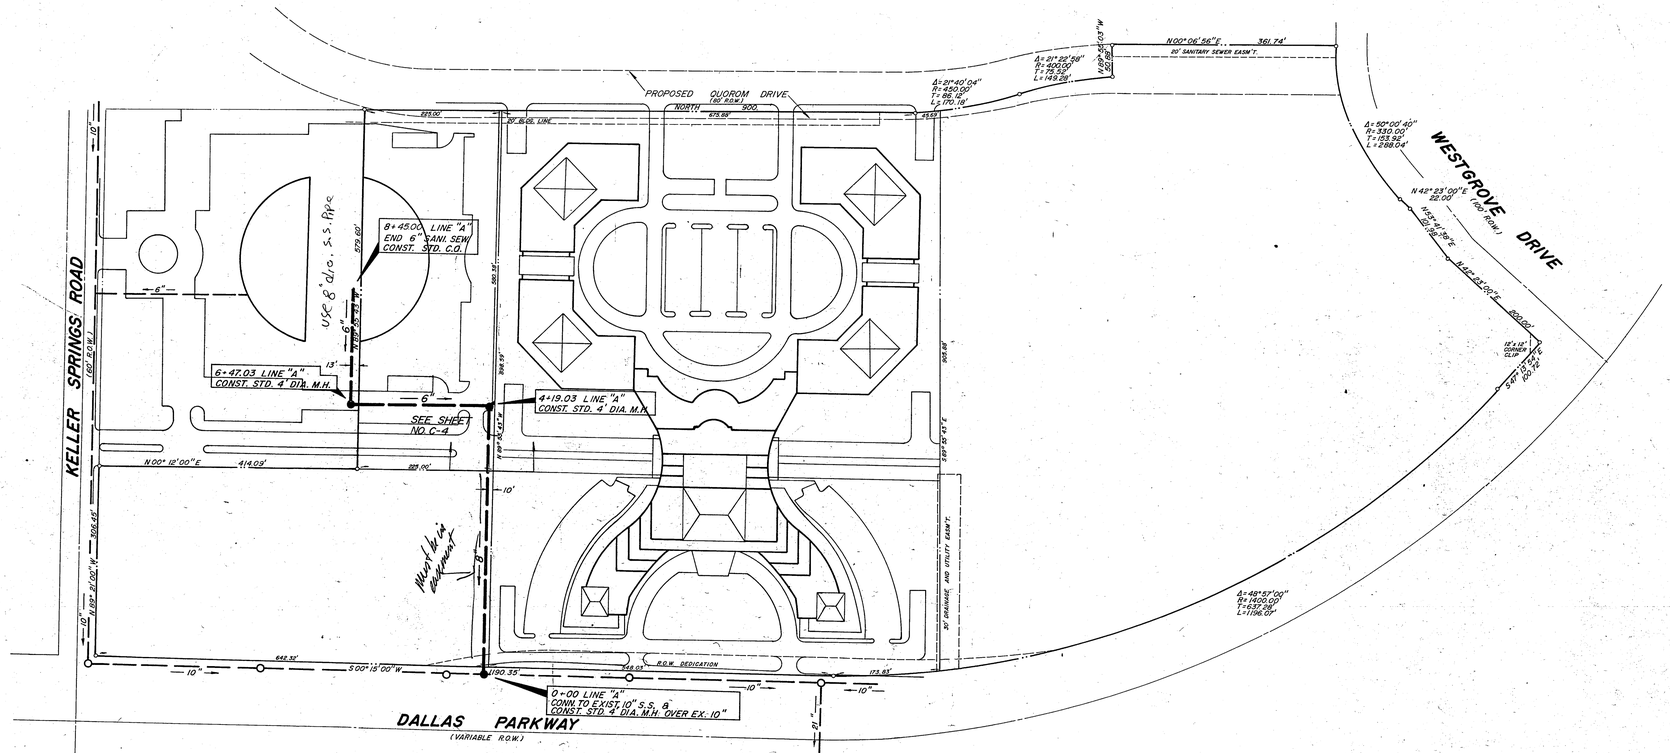

BENCHMARK:
SQUARE CUT ON TOP OF CURB OF
ISLAND N.E. CORNER OF LIBERTY PLAZA
ELEV-622.15

NOTE: BOUNDARY INFORMATION IS FROM
A BOUNDARY SURVEY BY GEOGRAM CORP.
DATED FEBRUARY, 1984.

OFF-SITE SANITARY SEWER

LIBERTY PLAZA

JACK R. DAVIS & associates, inc.
consulting civil engineers & surveyors
2902 Carlisle Street Dallas, Texas 75204

DESIGN	DRAWN	DATE	SCALE	NOTES	FILE	NO.
J.R.D.	J.R.D.	6/84	1"=100'	J.R.D.	C	8417O

HARWOOD K SMITH & PARTNERS
Architects/Engineers/Planners
1111 Plaza of the Americas North, LB 307
Dallas, Texas 75201 214/748-5261

HKS

t.f. stone companies dallas, texas

liberty plaza

Job No:

Revision:

Sheet Title:
OFF-SITE
SANITARY SEWER

Date: 7.24.84

Drawn:

Sheet No:
C 5
of sheets
C 1