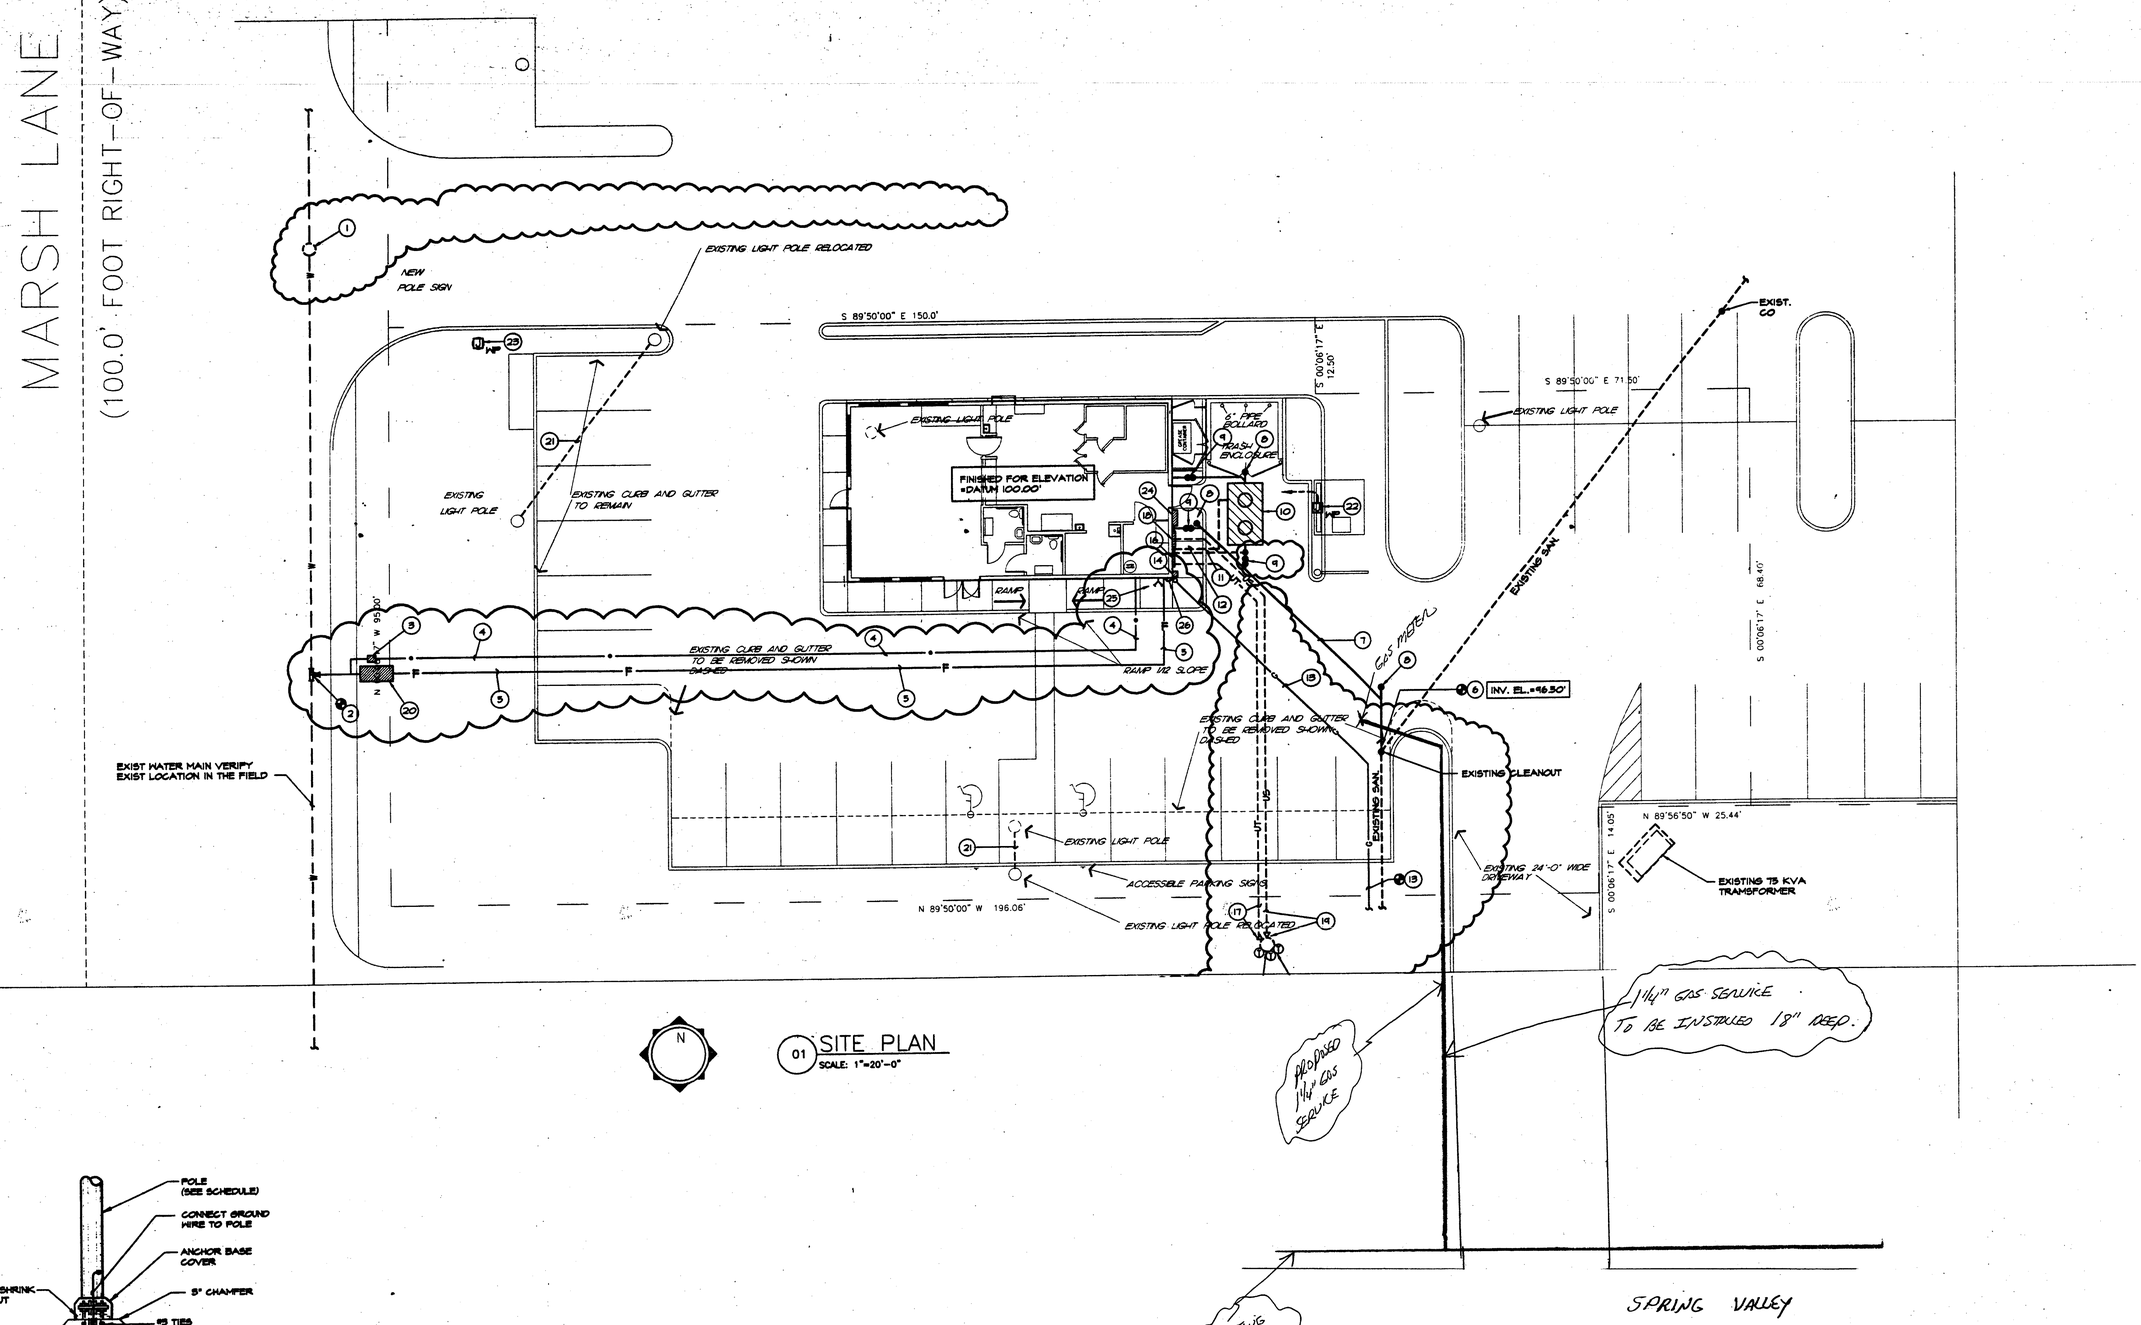

01 SITE PLAN
SCALE: 1"=20'-0"

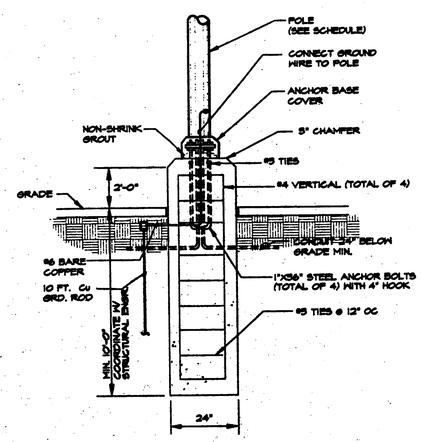

02 POLE BASE DETAIL
NO SCALE

GAS LOAD SUMMARY

DESCRIPTION	CFH
RTU'S (HEATING)	270
KITCHEN (COOKING)	179
WATER HEATING	70
TOTAL BUILDING GAS DEMAND	519

LITY CONTACTS:

	TELEPHONE:
EACE IES (ELECTRIC) SERVICE CENTER LLE AVE. 75206 - 6652 - 6673	MS. JERI SHELBY SOUTHWESTERN BELL 1255 TAVAROS AVE. DALLAS, TX. 75218 T. (214) 320 - 6440 F. (214) 324 - 7848

CTRIC:
DEBRAND
IES (GAS)
- 1329

Systems Associates
Engineering Consultants
2351 W. Northwest Highway
Suite 3110, Lock Box 39
Dallas, Texas 75220
Tel (214) 350-6487
Fax (214) 350-6497
SAI Job No 01017

JOHN E WHEELER III
ARCHITECTS
5454 LA SIERRA DRIVE #203 DALLAS, TEXAS 75231
(214)987-0160

SMALL PROTOTYPE
ADDISON, TEXAS

STATE OF TEXAS
SHUJI OKUDA
54327
REGISTERED
PROFESSIONAL ENGINEER
5-11-01

JOB NO. 0106

REVISIONS

NO.	DATE	DESCRIPTION
1	5-8-01	CITY COMMENTS

DATE 03-28-01

SHEET

MEP1