
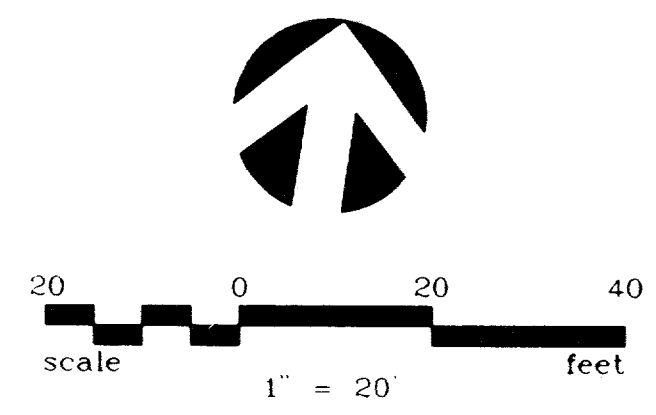




BUSINESS AVENUE

CORPORATE DRIVE

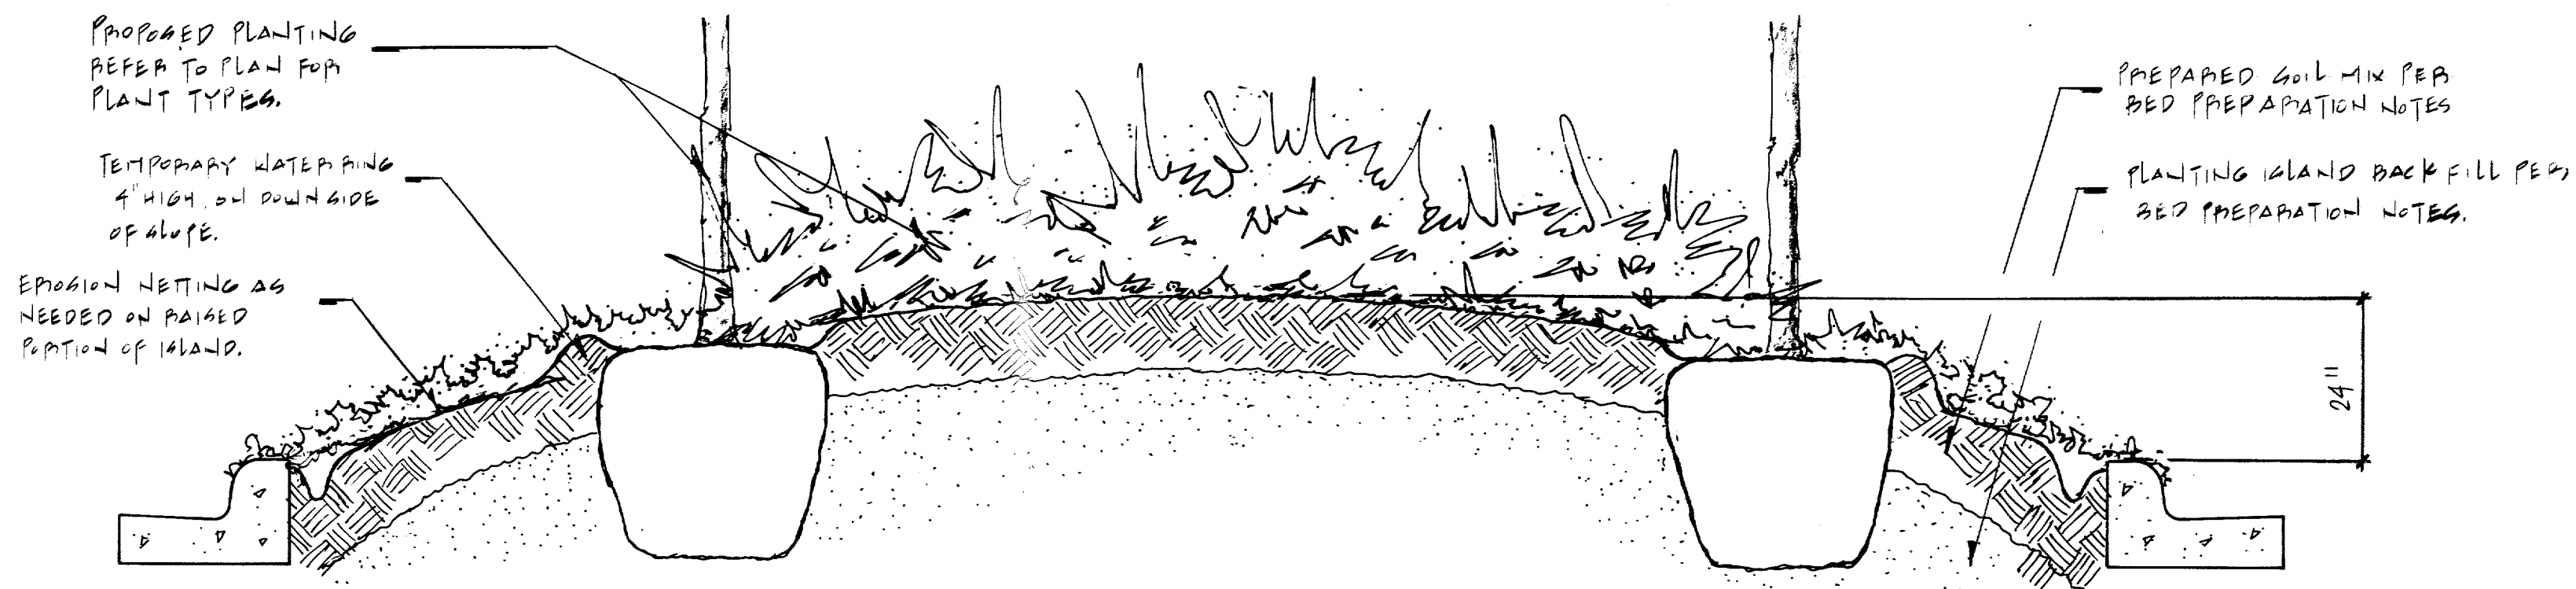


01 MEDIAN PLANTING CROSS-SECTION

NO SCALE

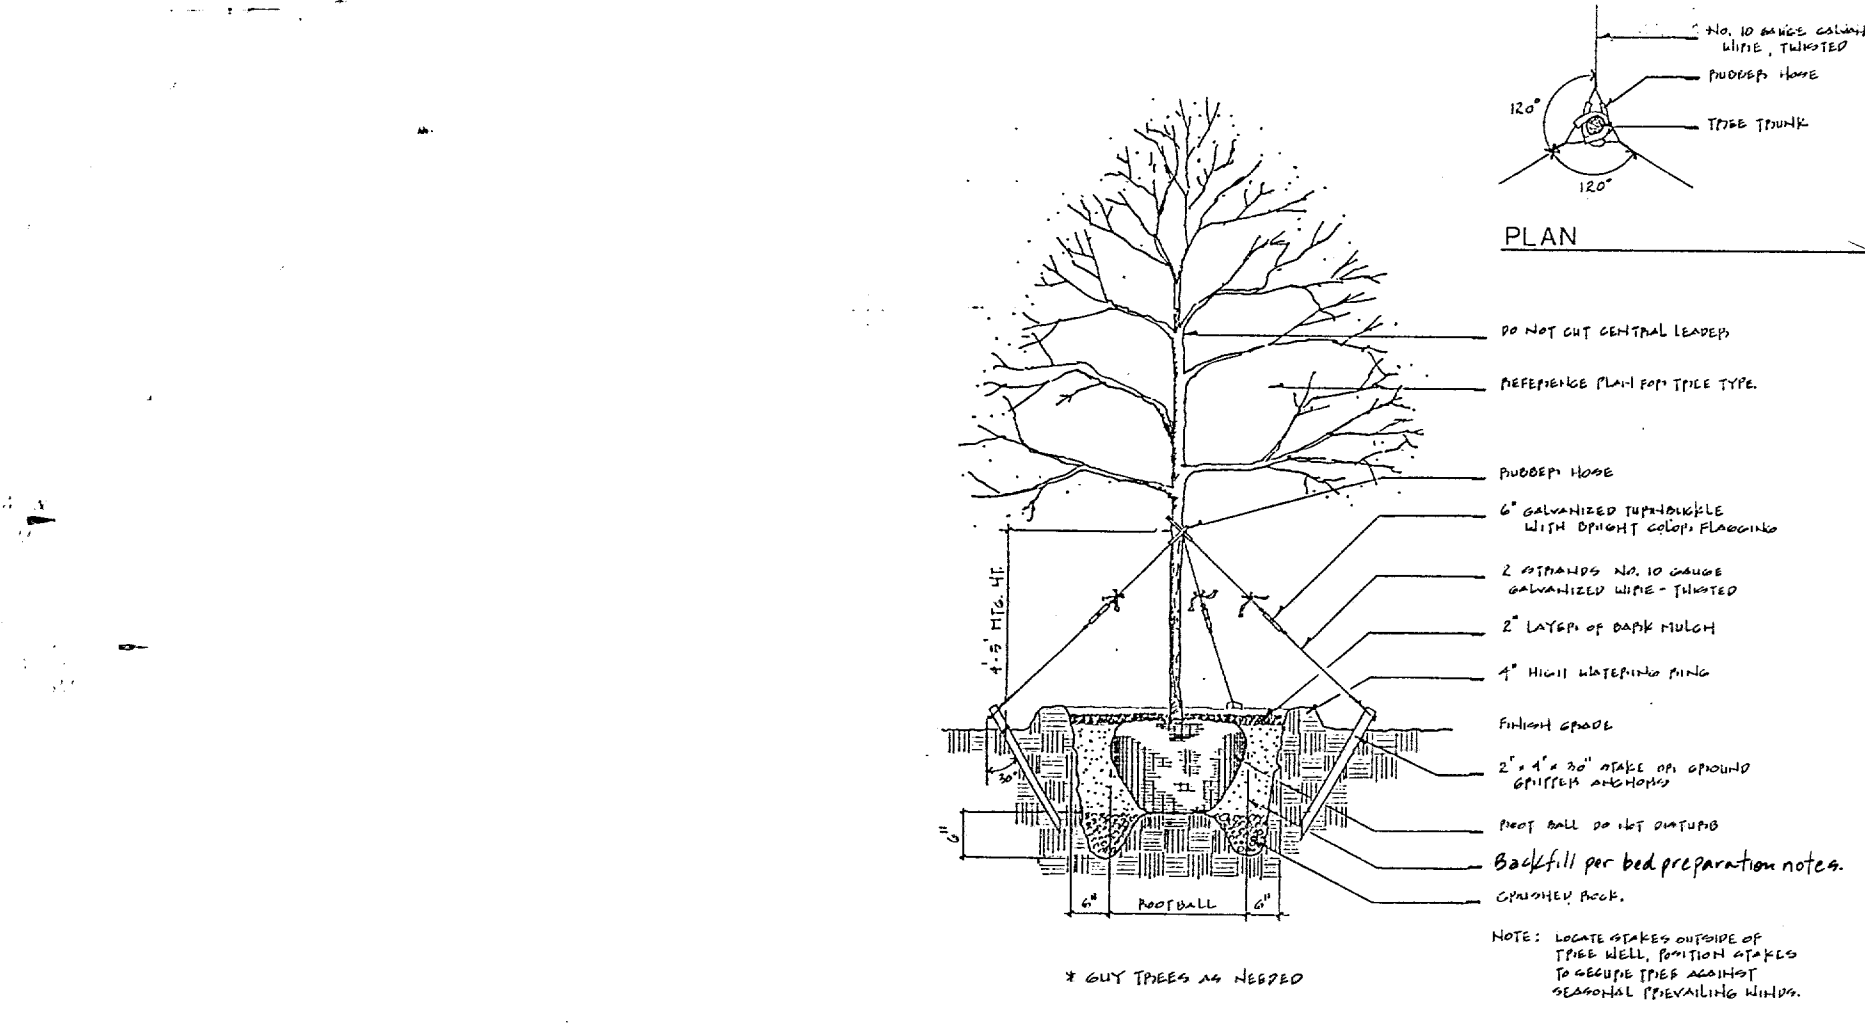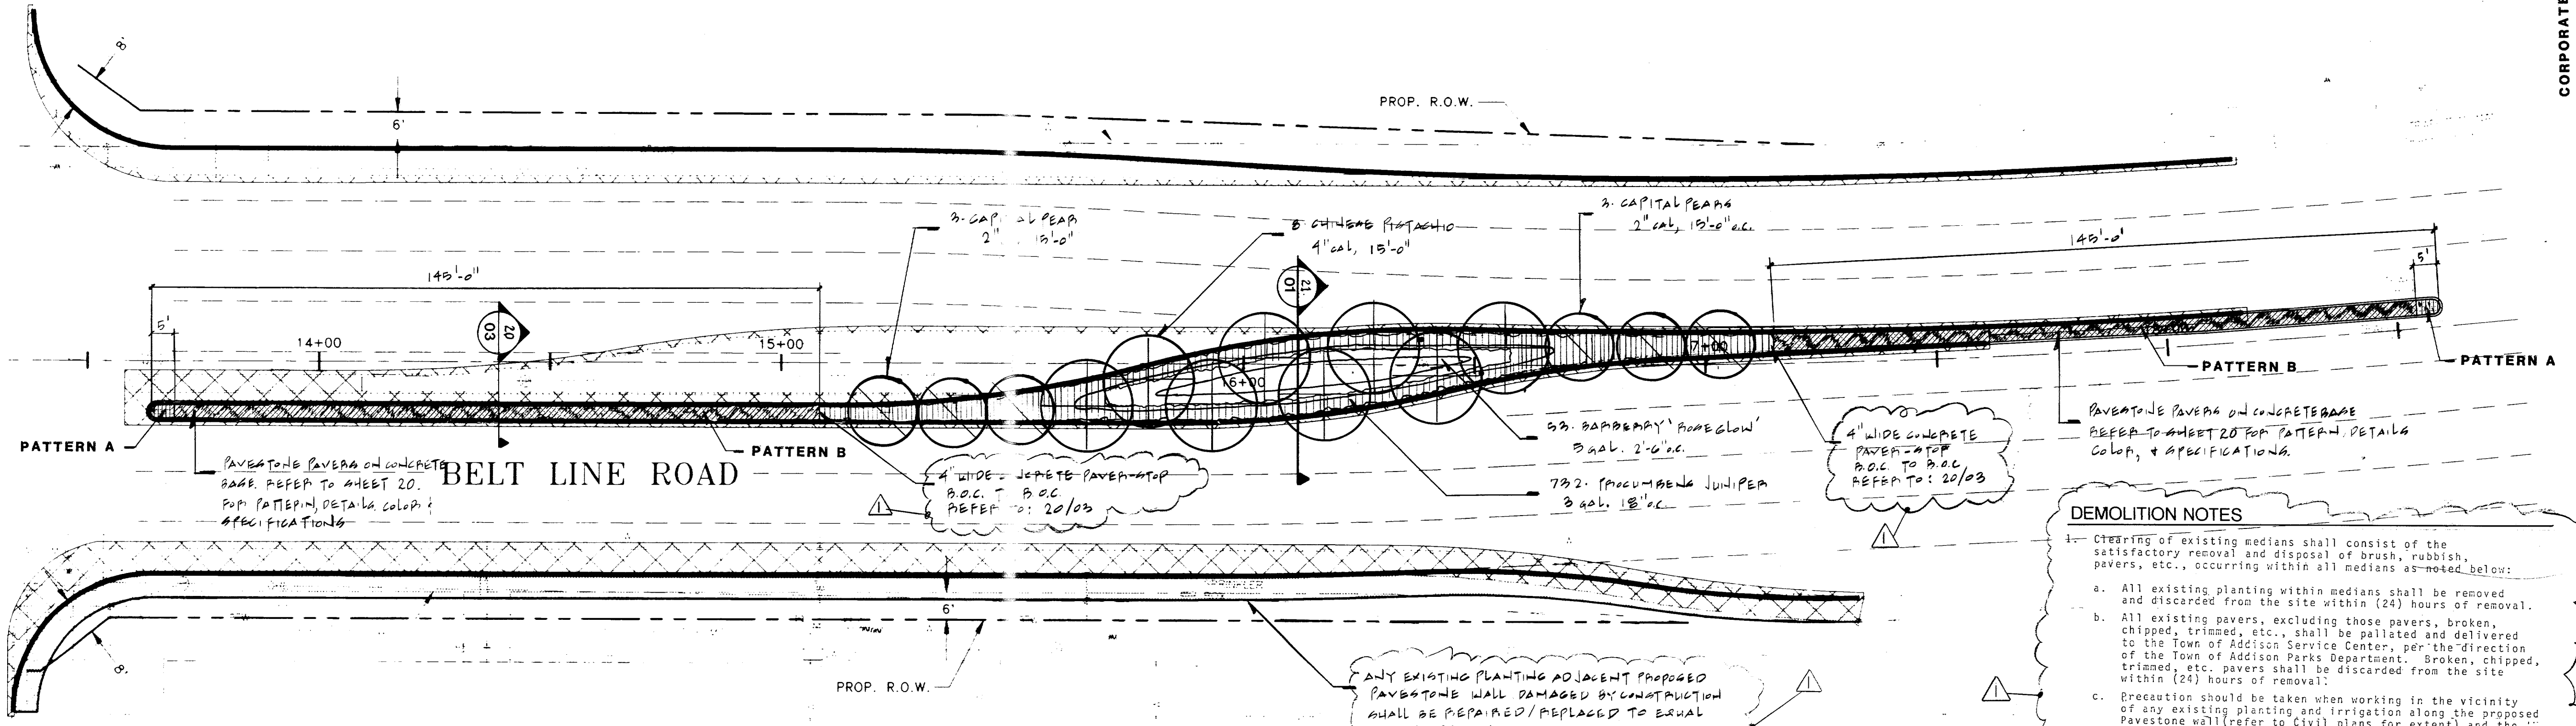



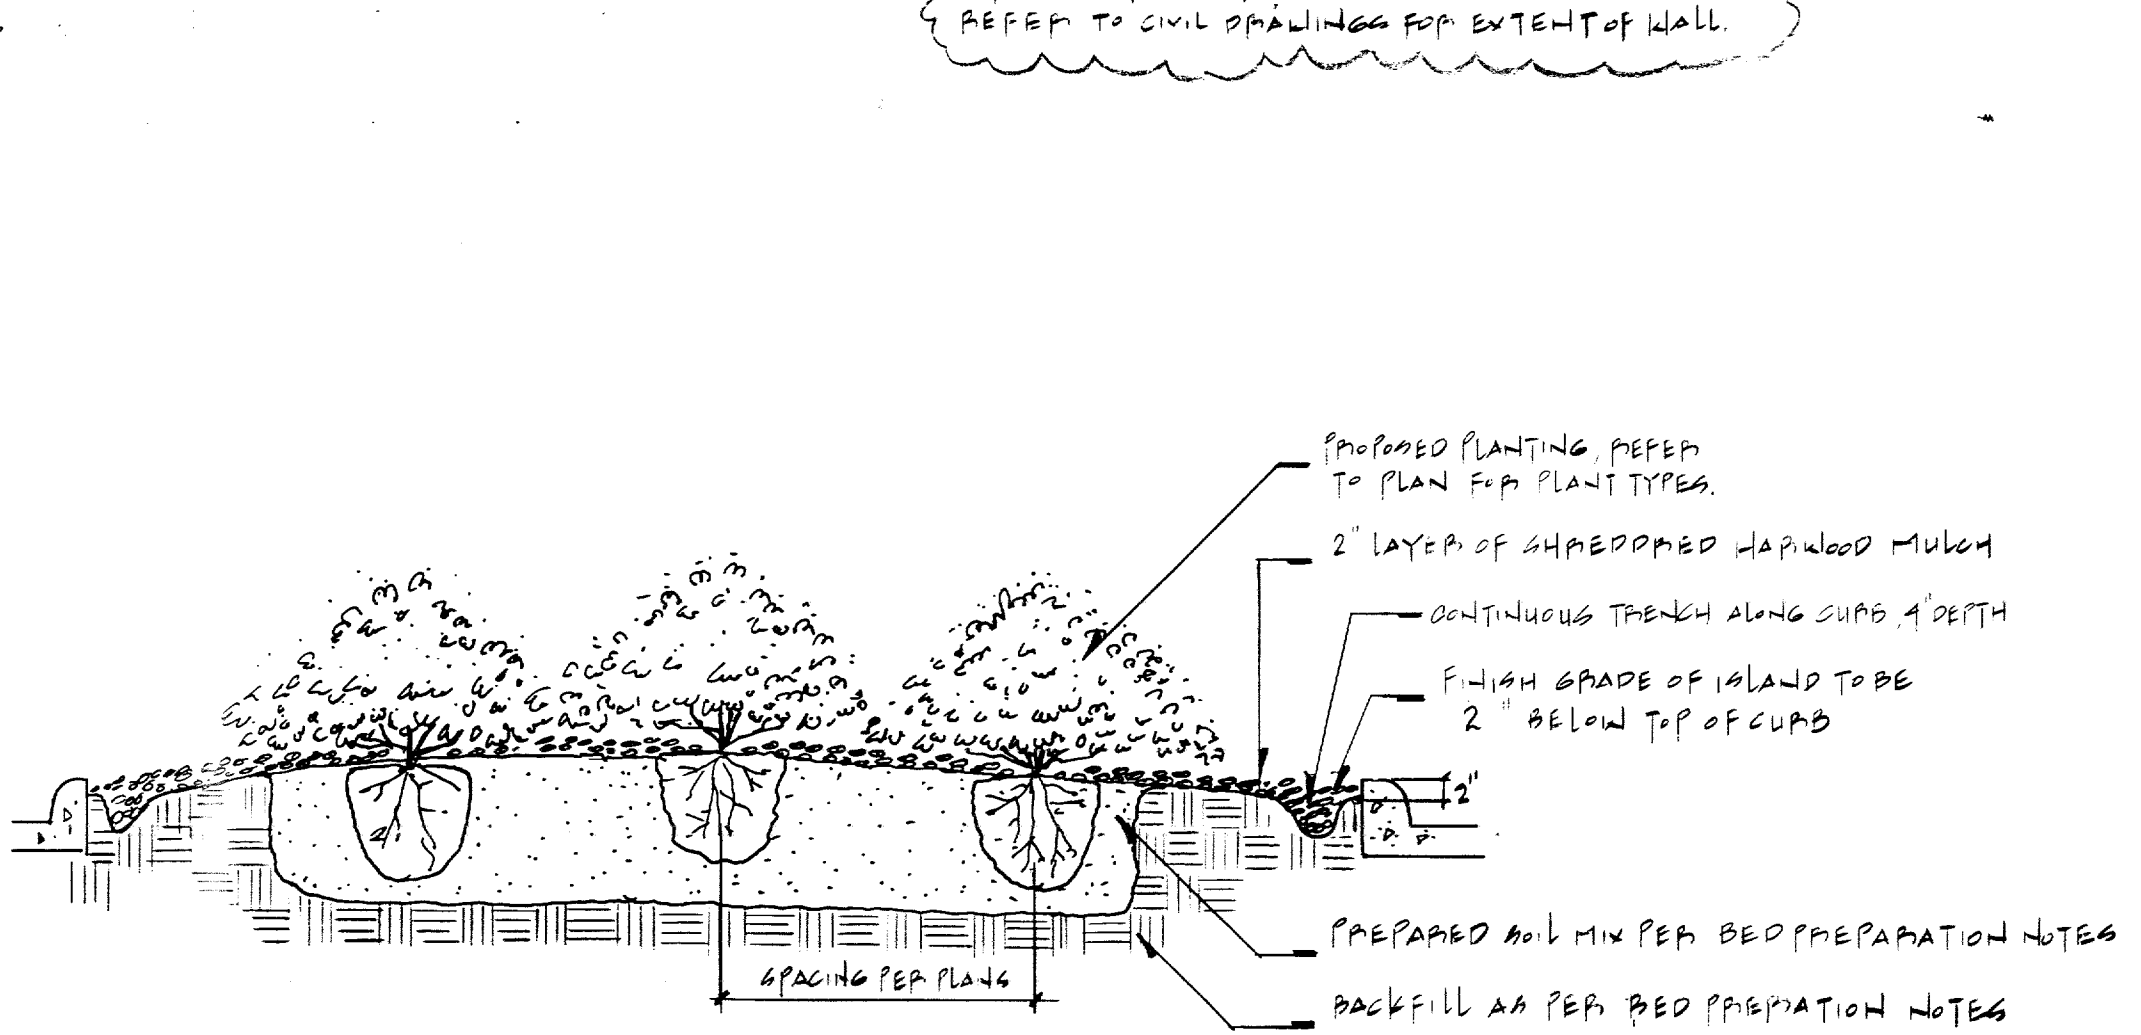

SHRUB / GROUND COVER PLANTING DETAIL

NO SCALE

DEMOLITION NOTES

- Clearing of existing medians shall consist of the satisfactory removal and disposal of brush, rubbish, pavers, etc., occurring within all medians as noted below:
 - All existing planting within medians shall be removed and discarded from the site within (24) hours of removal.
 - All existing pavers, excluding those pavers, broken, chipped, trimmed, etc., shall be palletted and delivered to the Town of Addison Service Center, per the direction of the Town of Addison Parks Department. Broken, chipped, trimmed, etc. pavers shall be discarded from the site within (24) hours of removal.
 - Precaution should be taken when working in the vicinity of any existing planting and irrigation along the proposed Pavestone wall (refer to civil plans for extent) and the Mobil gas station. Any damage occurring to existing planting and irrigation shall be replaced and/or repaired to equal or better value.

BED PREPARATION NOTES

- Clearing of existing planting islands shall consist of the satisfactory removal and disposal of brush and rubbish occurring within all planting areas as noted below:
 - All existing Sweet-Gum and Cedar Elm shall be hand-cut, banded and burlapped, and transplanted to another site as determined by the Town of Addison.
 - All Wax Myrtle shall be removed and discarded from the site within (24) hours of removal.
 - All pavers and existing groundcover shall be removed and discarded from the site within (24) hours of removal.
- Backfill: All planting islands shall be backfilled with Sandy Loam. It shall be without admixture of subsoil or slag and shall be free of stones, lumps, sticks, plants, or their roots, toxic substances, or other extraneous matter that may be harmful to plant growth or would interfere with future maintenance. Refer to Landscape Specifications.
- Prepared Soil Mix: Organic compost material shall be a mixture of 80% vegetative matter and 20% animal waste. Ingredients should be a mix of coarse and fine screened material. **Living Earth Technologies or approved equal.**
- Mulch: Mulch shall be Shredded Hardwood Bark Mulch of a relative uniform particle size with a median size of one (1") inch and shall be free of sticks, stones, leaves, and any other debris.
- Organic Fertilizer: Fertilizer shall be Fritulid, Macro-Gro, Manafix, Sustain, Agrispin, but guano or earthworm castings as recommended for required applications. Fertilizer shall be delivered to the site in its original unopened containers, each bearing the manufacturer's guaranteed statement of analysis.
- Prepare new planting beds by backfilling planting islands with the specified backfill to a minimum depth of 18" and by adding 6" of prepared soil mix and tilling to depth of four (4") inches, such that the finish grade of the planting island is two (2") inches below top of curb.
- Apply organic fertilizer such as Fritulid, Macro-Gro, Manafix, or Sustain @ 20 lbs / 1000 sq. ft. at the rate of 1 lb. of nitrogen per 1000 sq. ft.
- All planting areas shall receive a two (2") inch layer of Shredded Hardwood Bark Mulch after plant material has been installed.

NO.	TOWN OF ADDISON COMMENTS	REVISION	BY	DATE

DESIGNED BY: BA/SP
 DRAWN BY: BA
 CHECKED BY: SP
 SCALE: 1" = 20'
 DATE: MAR. 22, 1994
 FILE:

E&H Espey, Huston & Associates, Inc.
 Engineering & Environmental Consultants
 13800 Montfort Drive, Suite 230
 Dallas, Texas 75240 (214) 387-0771

SMR
 Landscape Architects
 703 McKinney, LB 107
 Suite 403
 Dallas, Texas 75202
 (214) 871 0083
 Steven M. Rahn, ASLA

LANDSCAPE PLAN
 BELT LINE ROAD EAST OF BUSINESS AVE. TO CORPORATE DRIVE

PAVING IMPROVEMENTS
 BELT LINE ROAD AT BUSINESS AVENUE
 for
 THE TOWN OF ADDISON

SHEET NO. **21** OF 46 SHEETS
 JOB NO. 15411